#13974

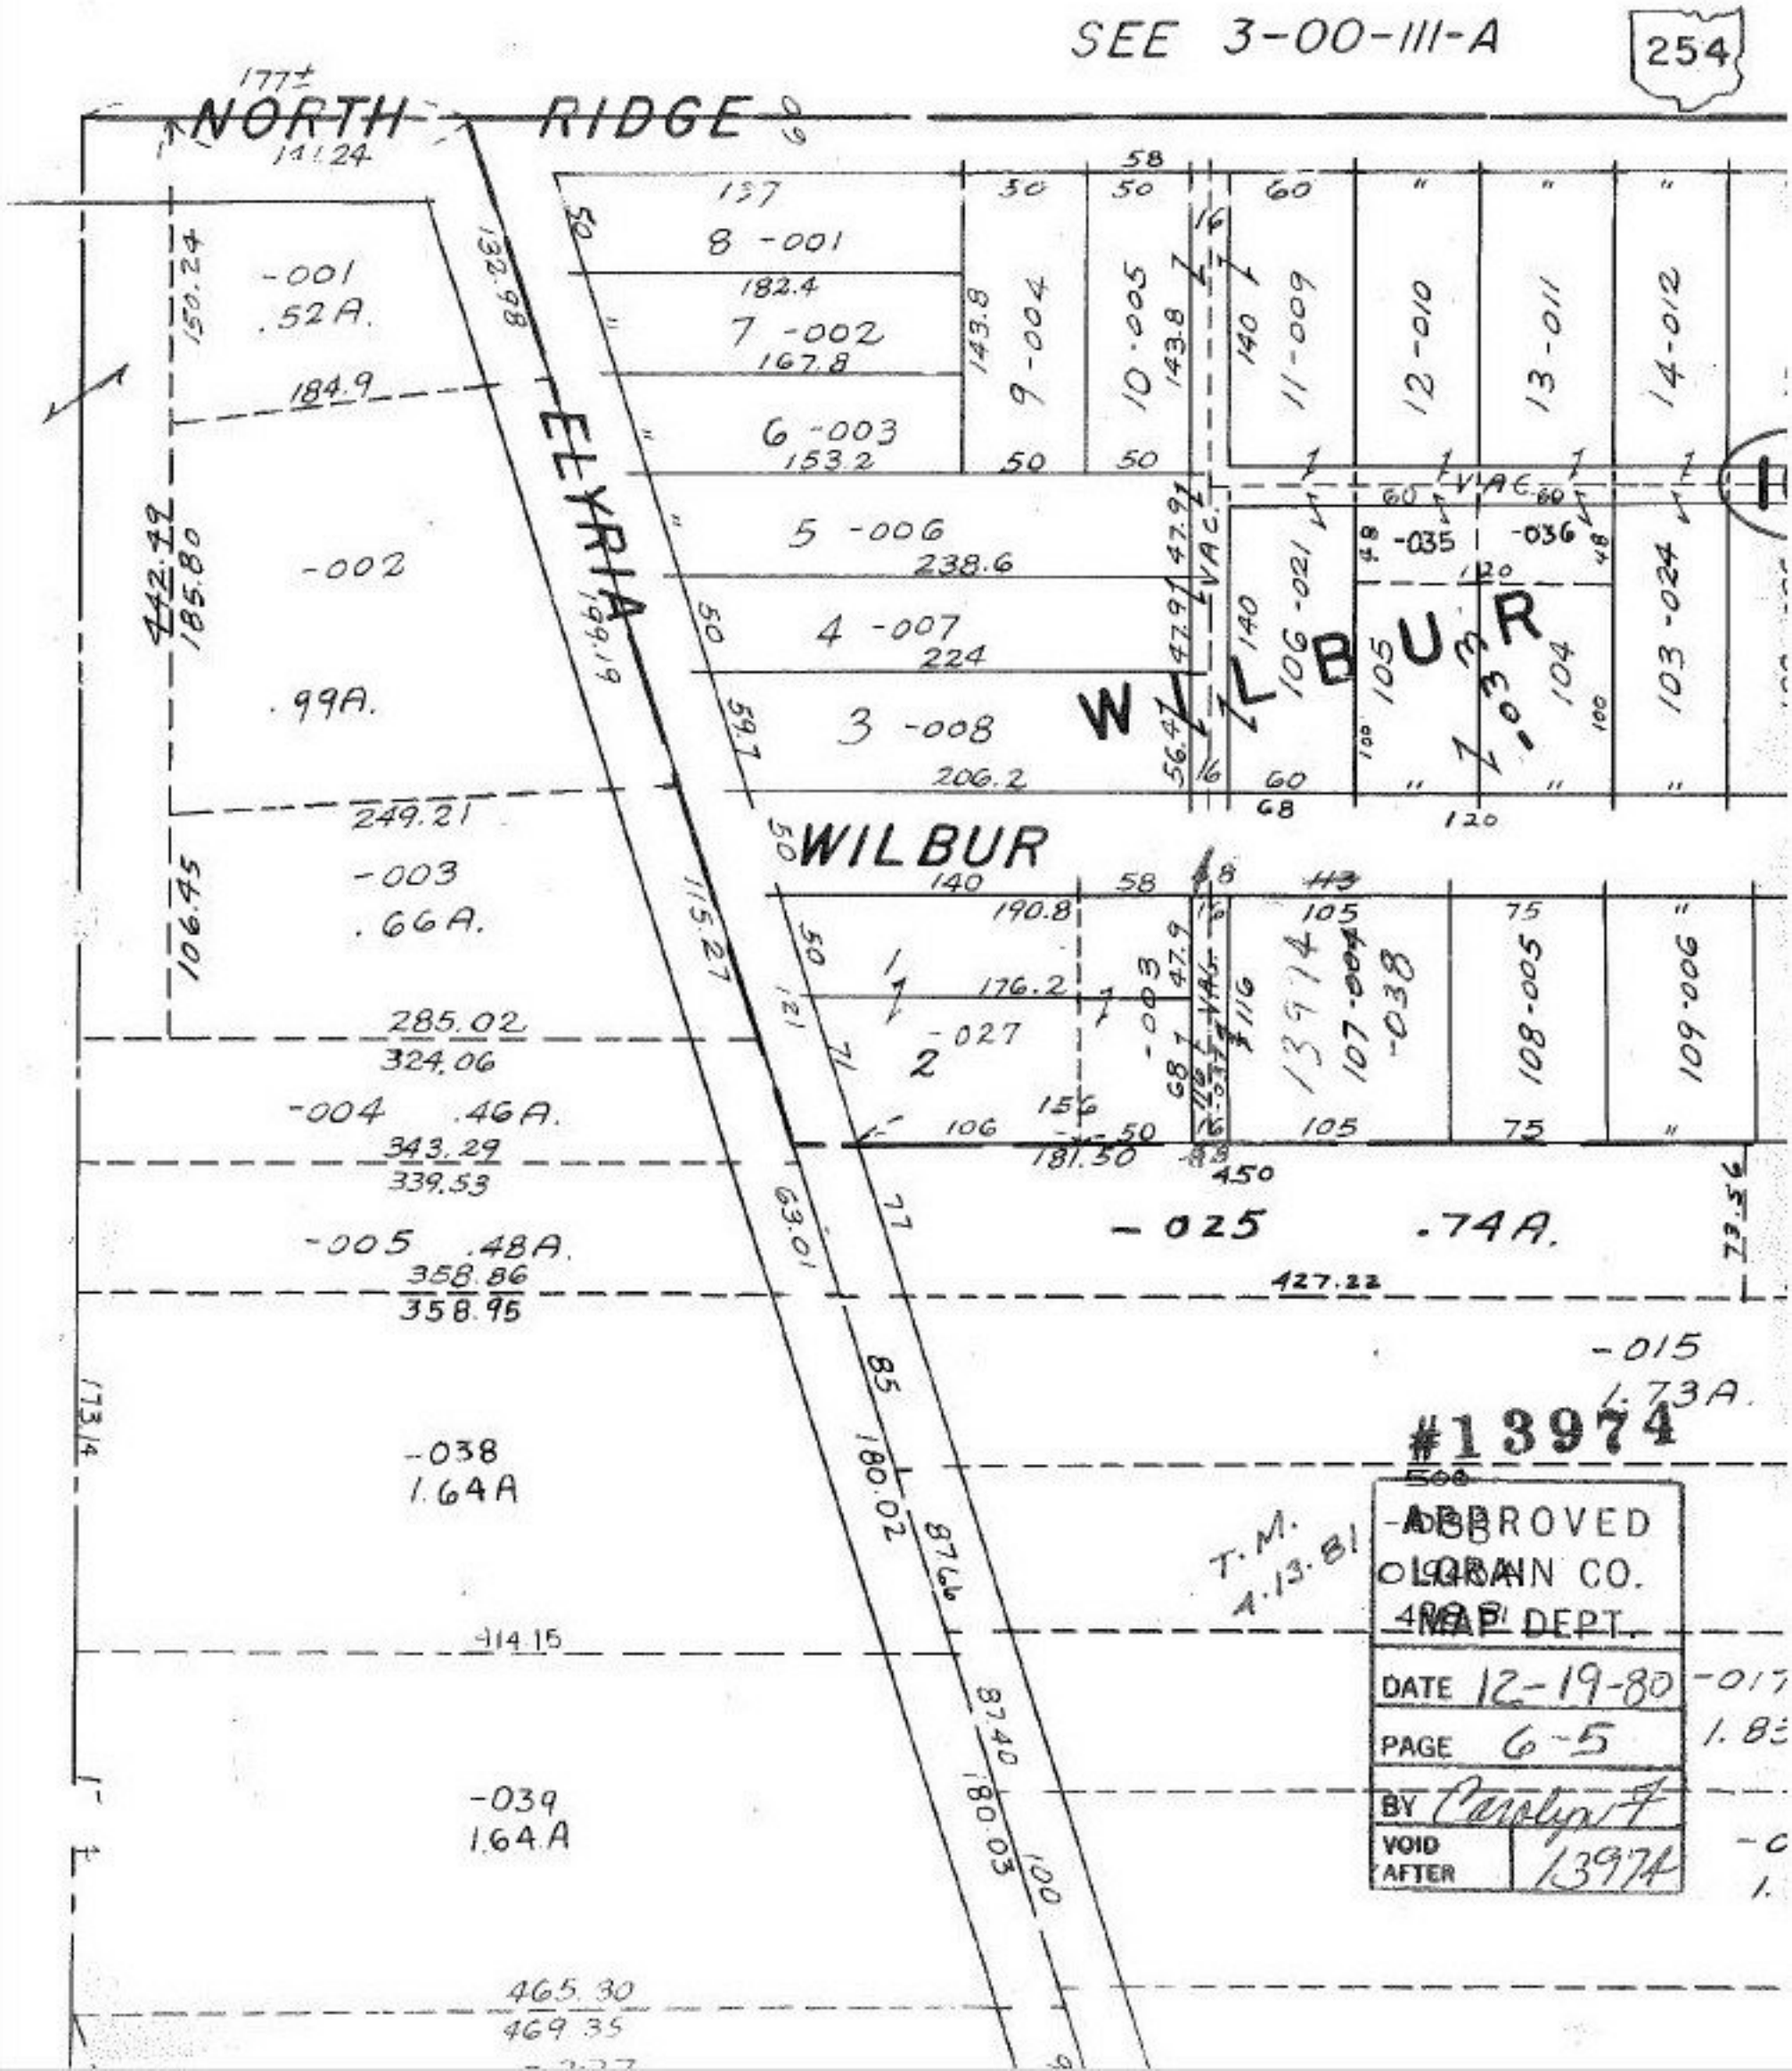

SEE 3-00-111-A
254
NORTH RIDGE
ELYRIA
WILBUR
WILBUR
-001 .52A.
-002 .99A.
-003 .66A.
-004 .46A.
-005 .48A.
-038 1.64A
-039 1.64A
-025 .74A.
-015 1.73A.
8 -001
7 -002
6 -003
5 -006
4 -007
3 -008
9 -004
10 -005
11 -009
12 -010
13 -011
14 -012
106 -021
105
104
103 -024
-035
-036
-027
-003
13974
107 -004
-038
108 -005
109 -006
T.M. 4.13.81
#13974
APPROVED
LORAIN CO.
MAP DEPT.
DATE 12-19-80
PAGE 6-5
BY Carolyn F
VOID AFTER 13974