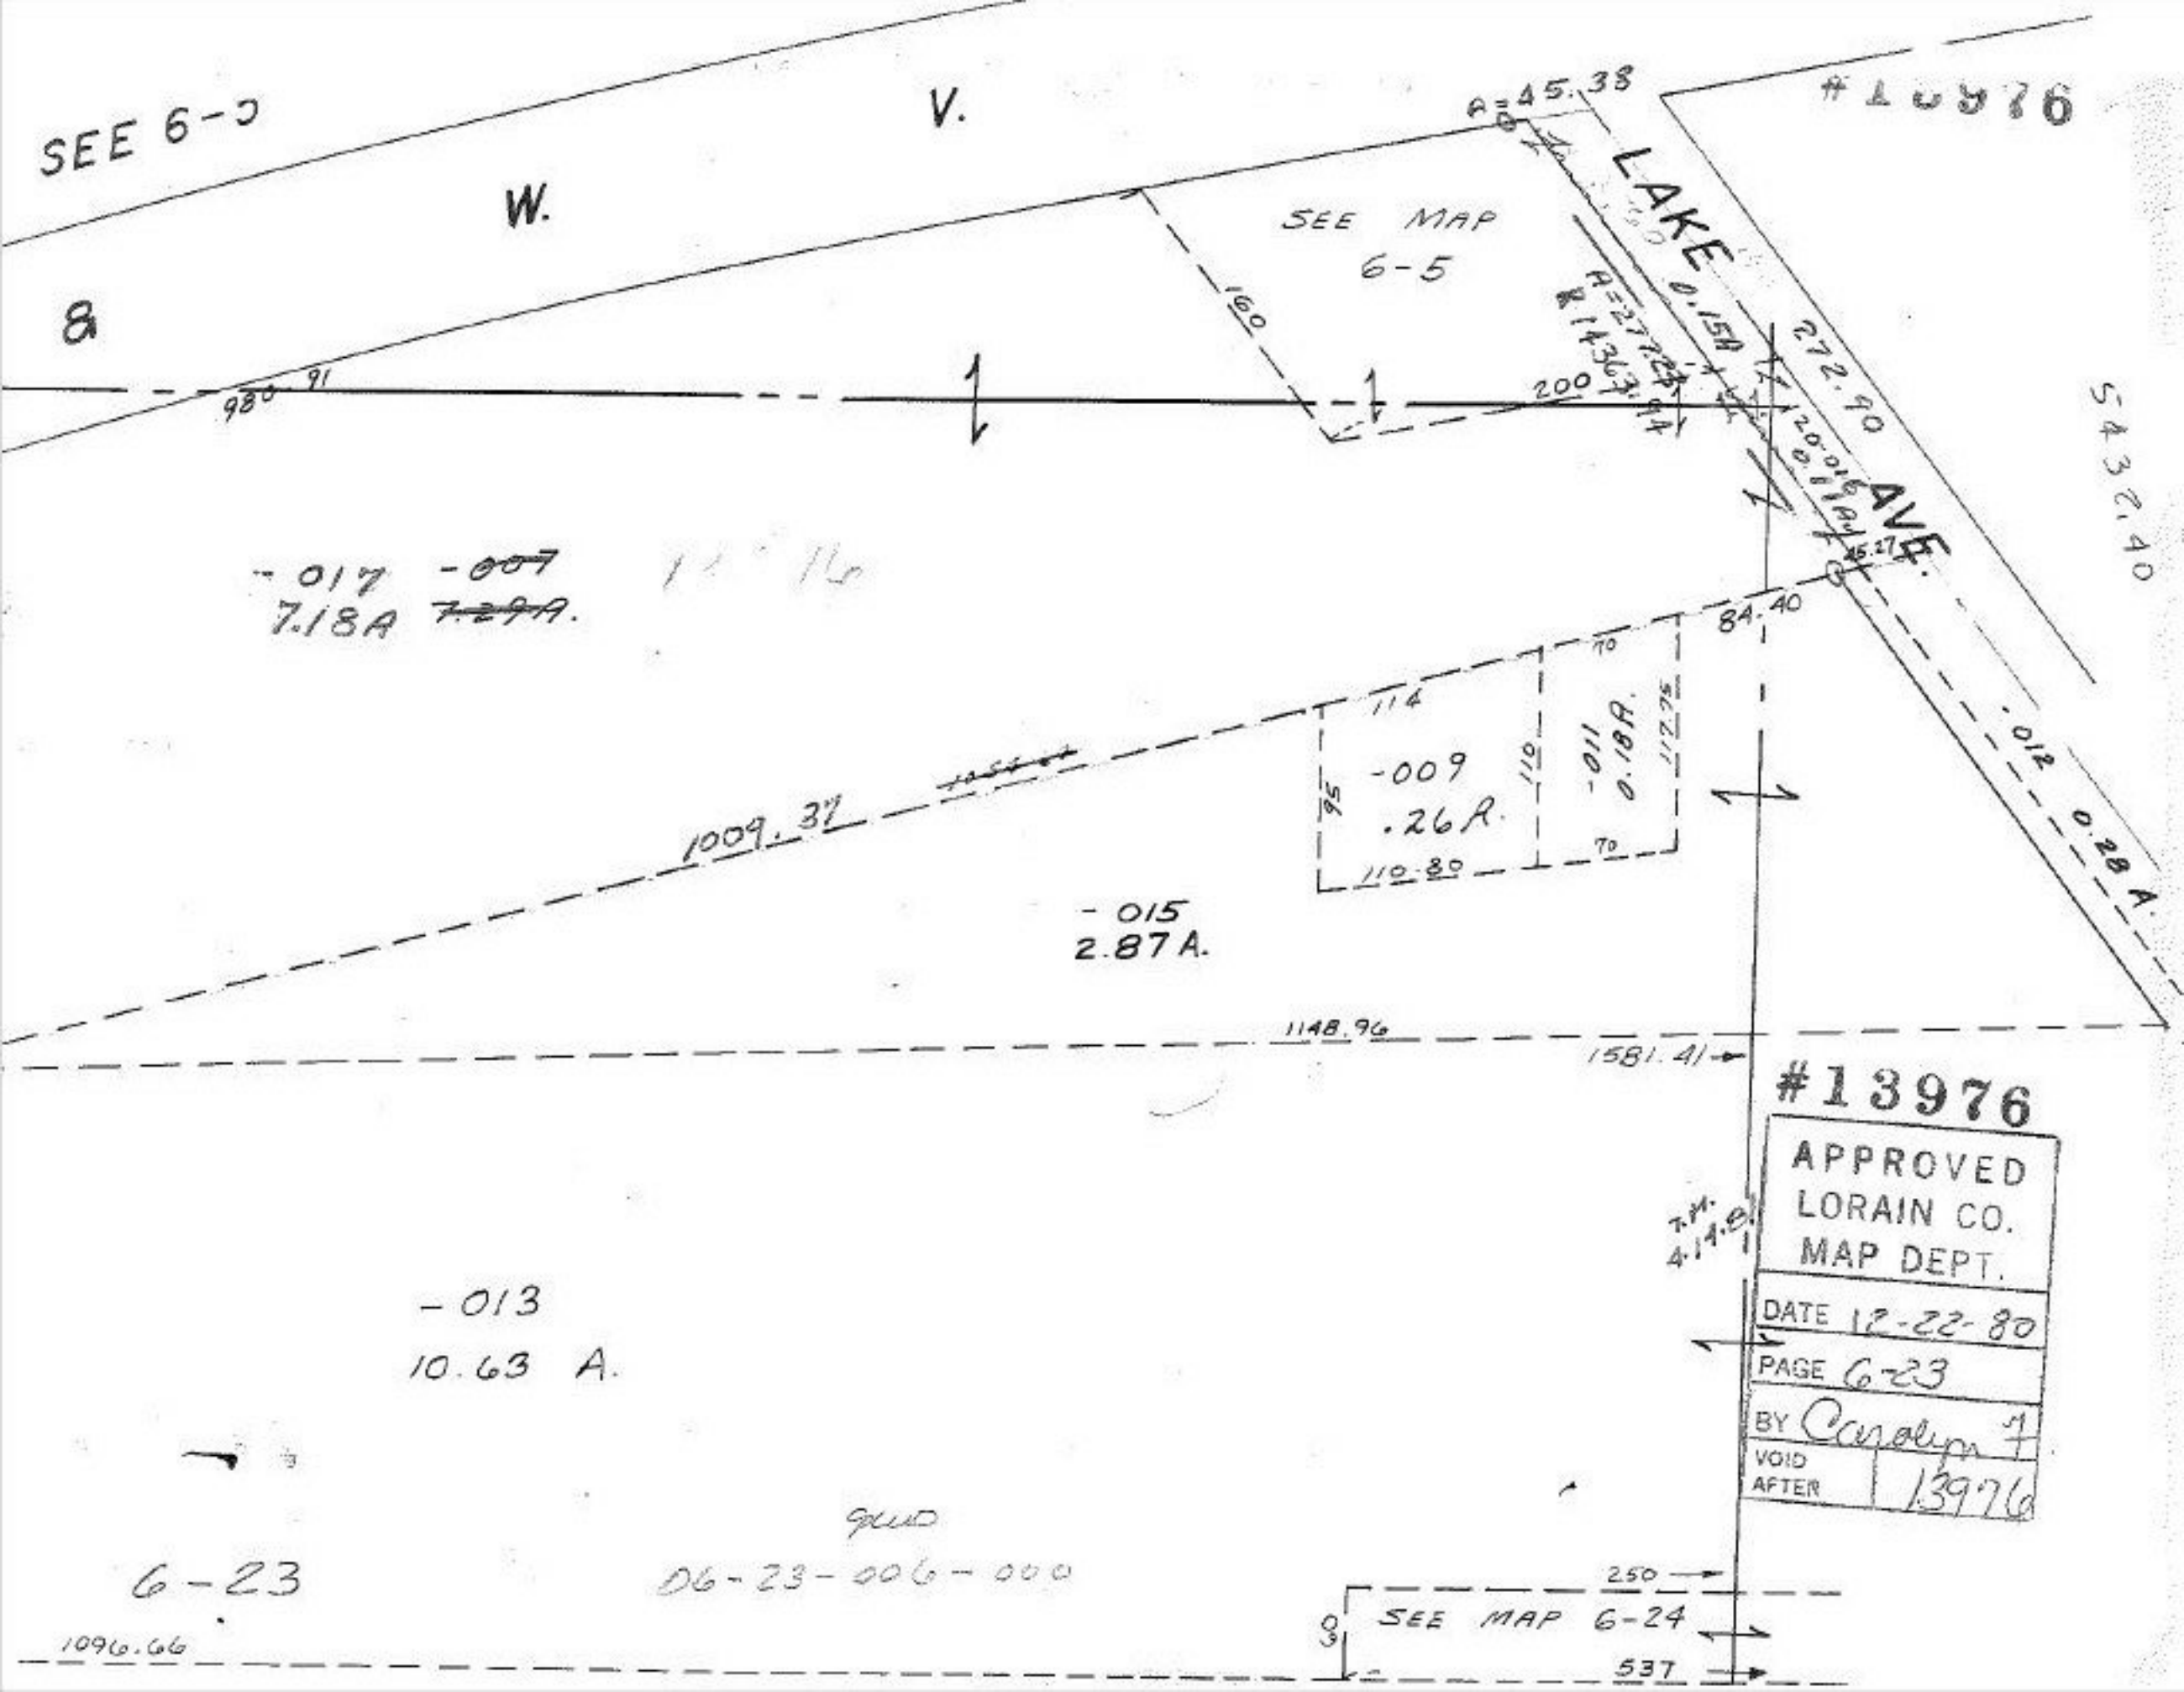
SEE 6-5
W.
V.
8
SEE MAP
6-5
LAKE
AVE.
A=45.38
272.90
5432.40
980.91
160
200
-017
7.18A
-009
.26A.
-011
0.18A.
-012
0.28 A.
84.40
1009.37
-015
2.87A.
1148.96
1581.41
-013
10.63 A.
6-23
D6-23-006-000
250
SEE MAP 6-24
537
1096.66
#13976
APPROVED
LORAIN CO.
MAP DEPT.
DATE 12-22-80
PAGE 6-23
BY Carolyn F
VOID AFTER 13976