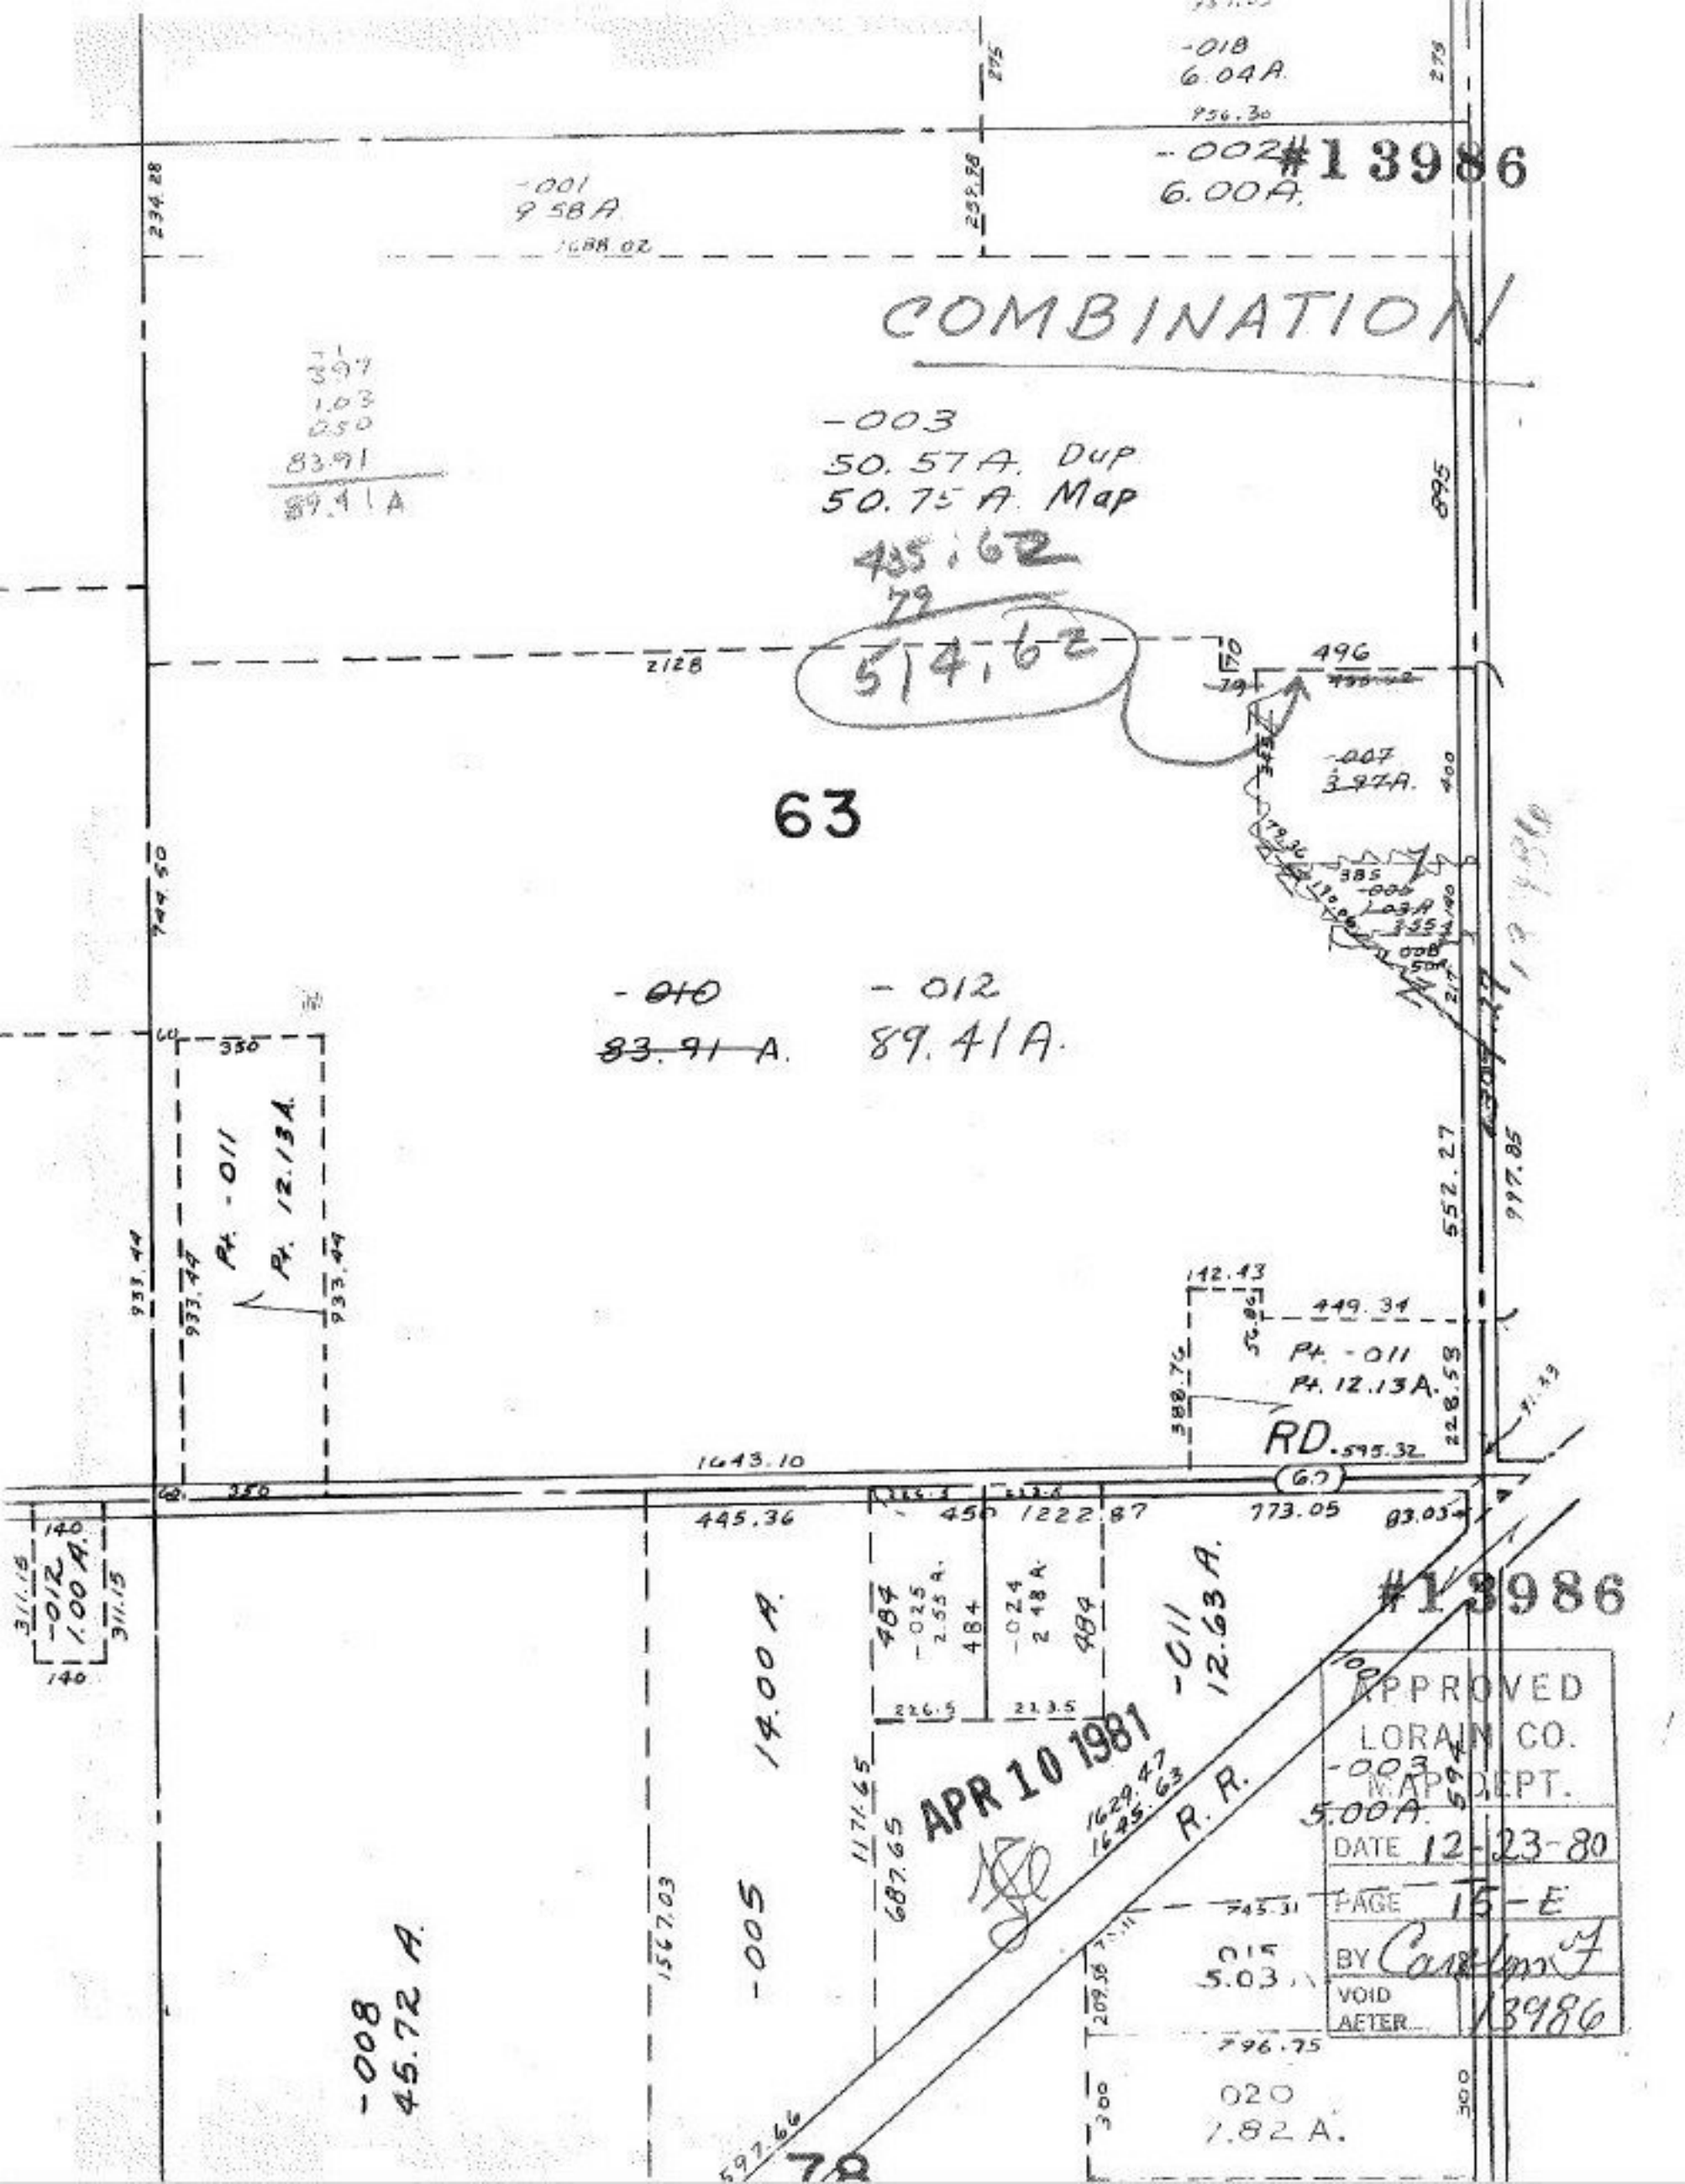

-018
6.04A.
-002
6.00A.
#13986
-001
9.58A.
COMBINATION
-003
50.57A. Dup
50.75A. Map
435.62
79
514.62
63
-010
83.91 A.
-012
89.41A.
Pt. -011
Pt. 12.13A.
RD.
1643.10
445.36
1222.87
773.05
-012
1.00A.
14.00 A.
-011
12.63 A.
R. R.
-005
-008
45.72 A.
-003
5.00A.
015
5.03
020
7.82 A.
78
APR 10 1981
APPROVED
LORAIN CO.
MAP DEPT.
DATE 12-23-80
PAGE 15-E
BY
VOID AFTER 13986