PARENT PARCEL: 07-00-021-119-064

CHILD PARCEL: 07-00-016-104-190, 07-00-021-119-150, -151

STARTING POINT: INTERSECTION OF C/L OF CENTER RIDGE RD. AND C/L OF JAYCOX RD.

14-00576

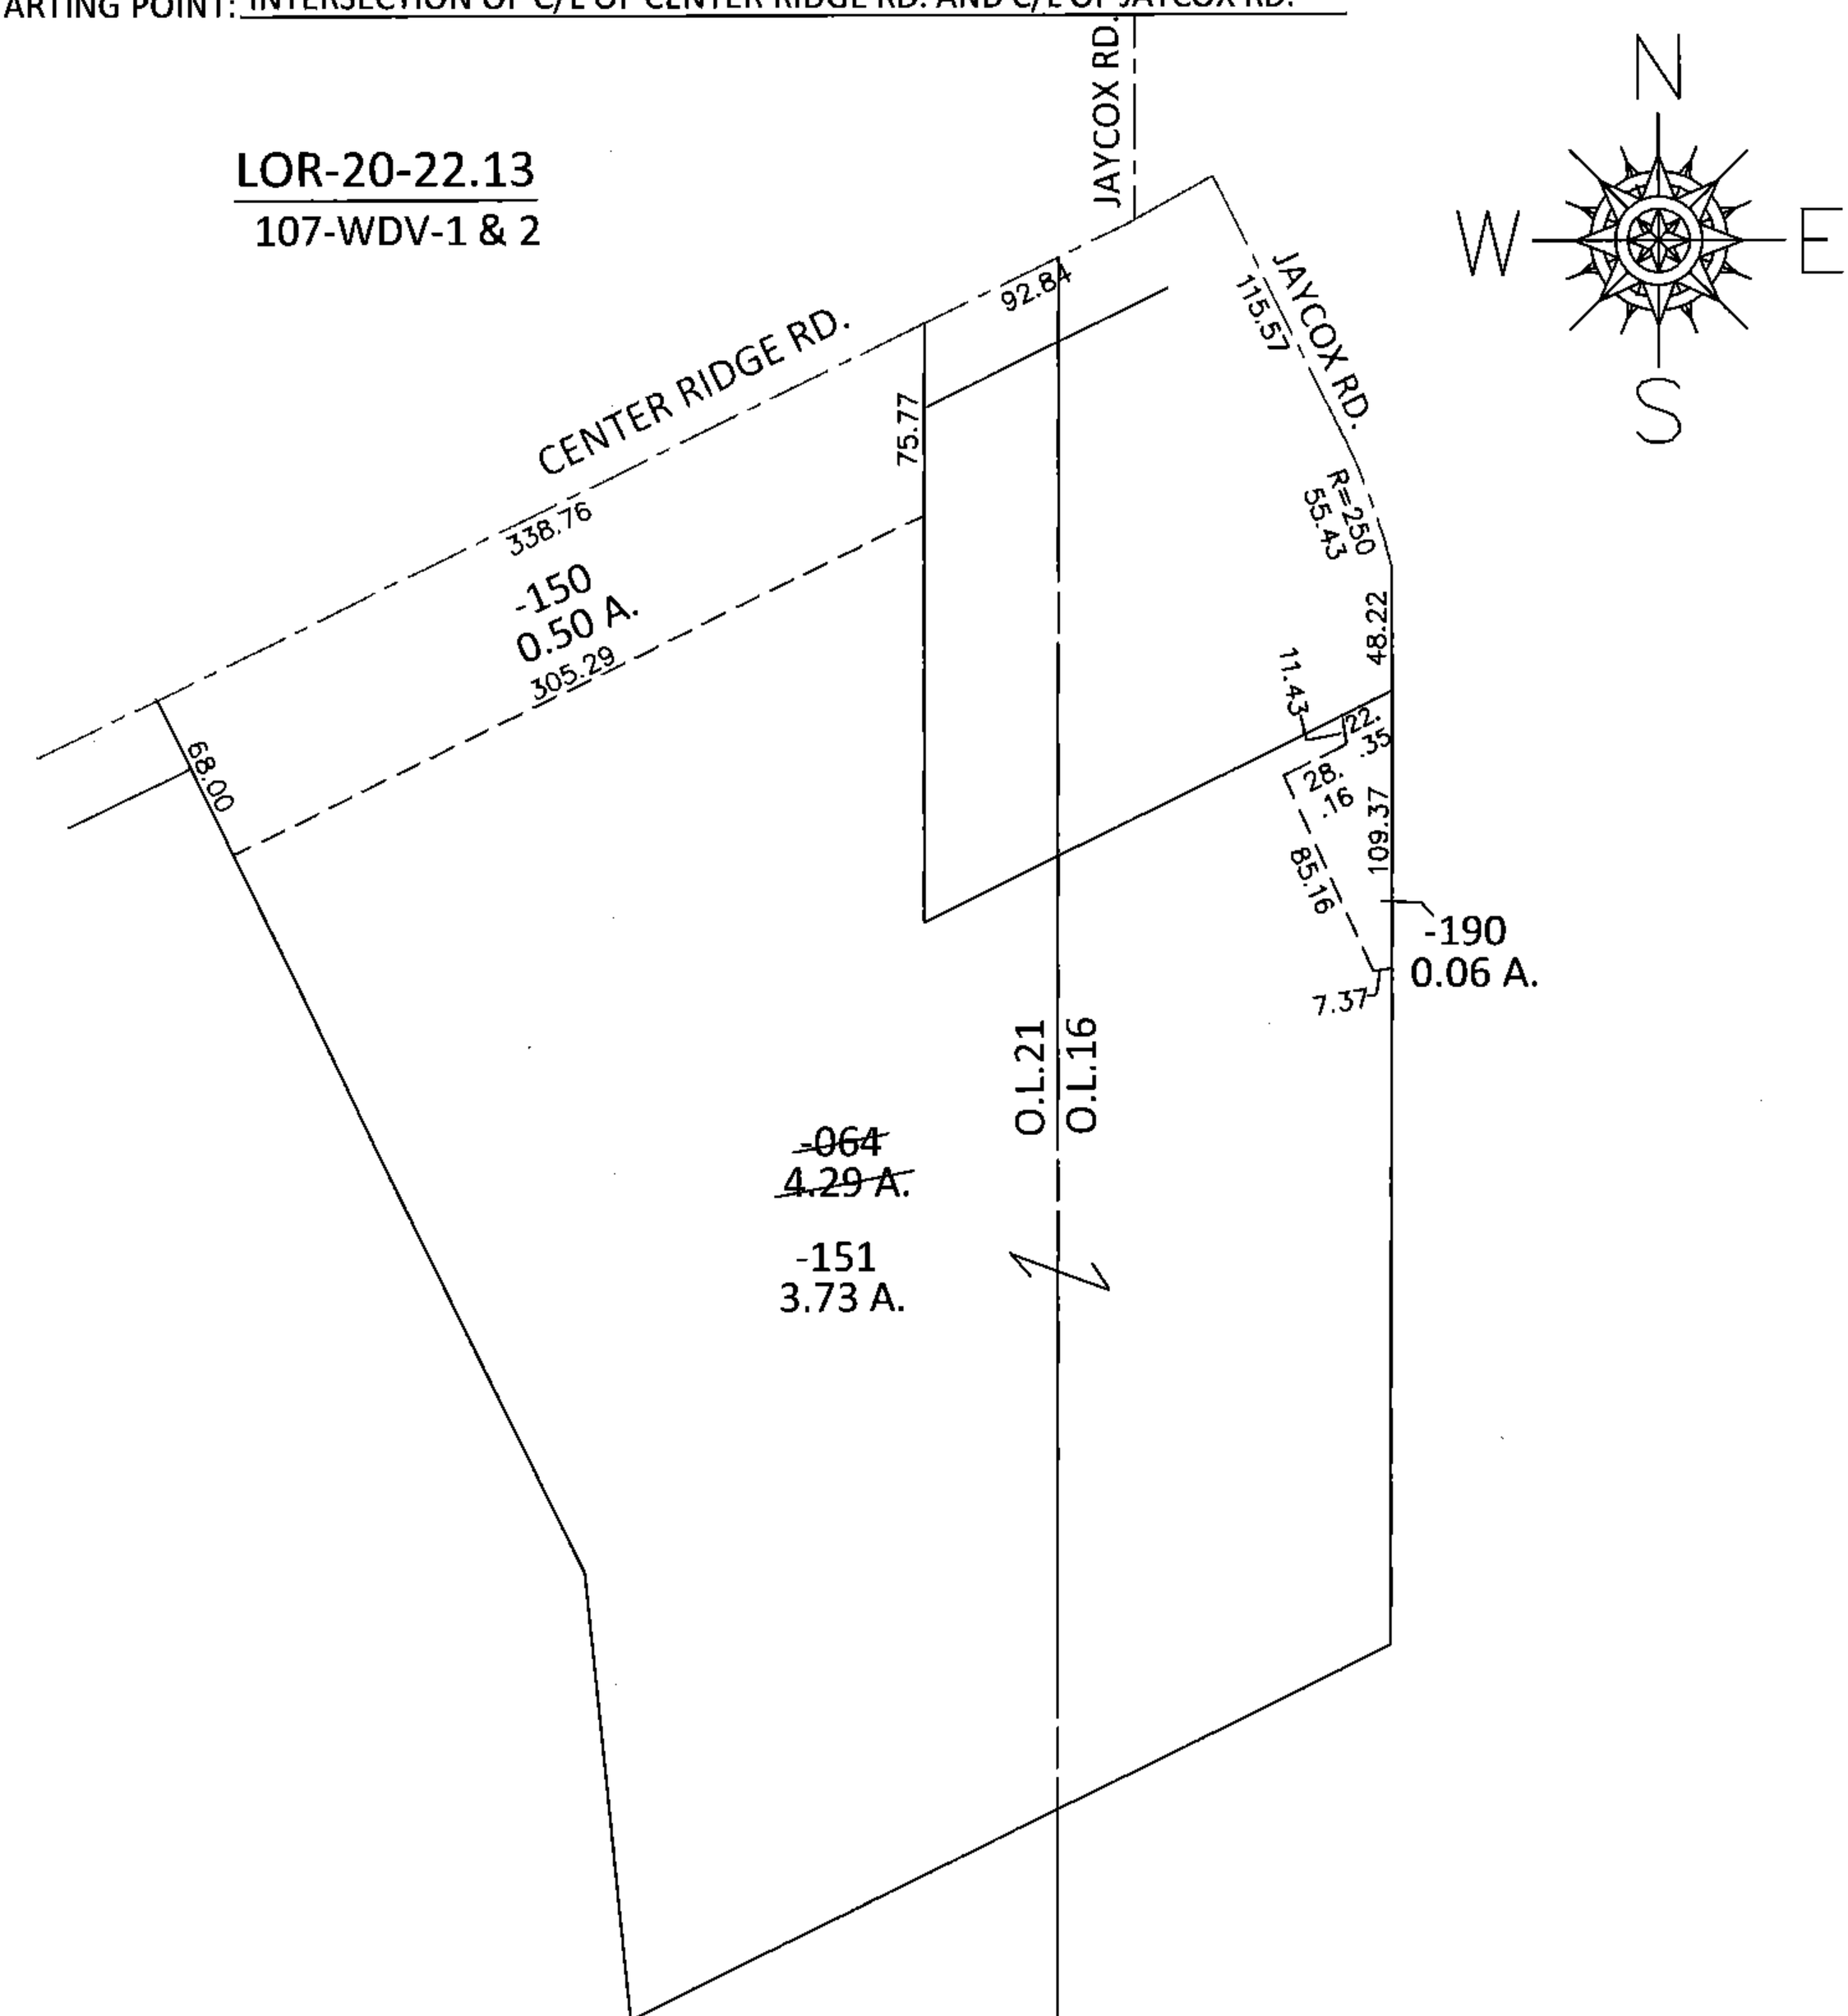

SPLITS/DEEDS PROCESSED

LORAIN COUNTY TAX MAP DEPARTMENT
226 MIDDLE AVE. ELYRIA, OHIO

SURVEYED BY: WILLIAM D. THOMAS

CLOSURE: .01:10,000

MAP PAGE(S): 7-00-016-A

APPROVED BY: RRM DATE: 10-30-14

SCALE: 1"= 100 PRIOR INST.: 20080254711