PARENT PARCEL: 07-00-016-104-002
CHILD PARCEL: 07-00-016-104-193, -194
STARTING POINT: INTERSECTION OF C/L OF CENTER RIDGE RD. AND C/L OF JAYCOX RD.

14-00577

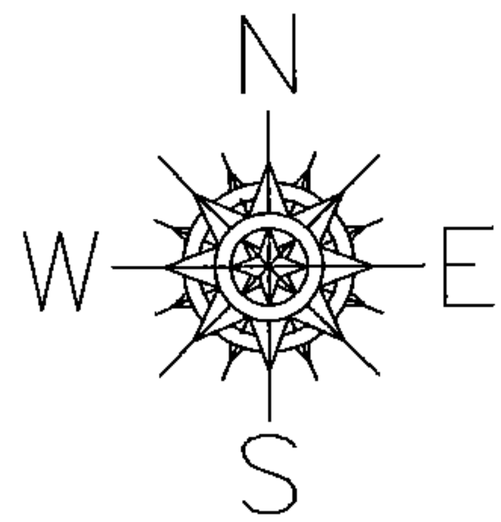

LOR-20-22.13
108-WDV

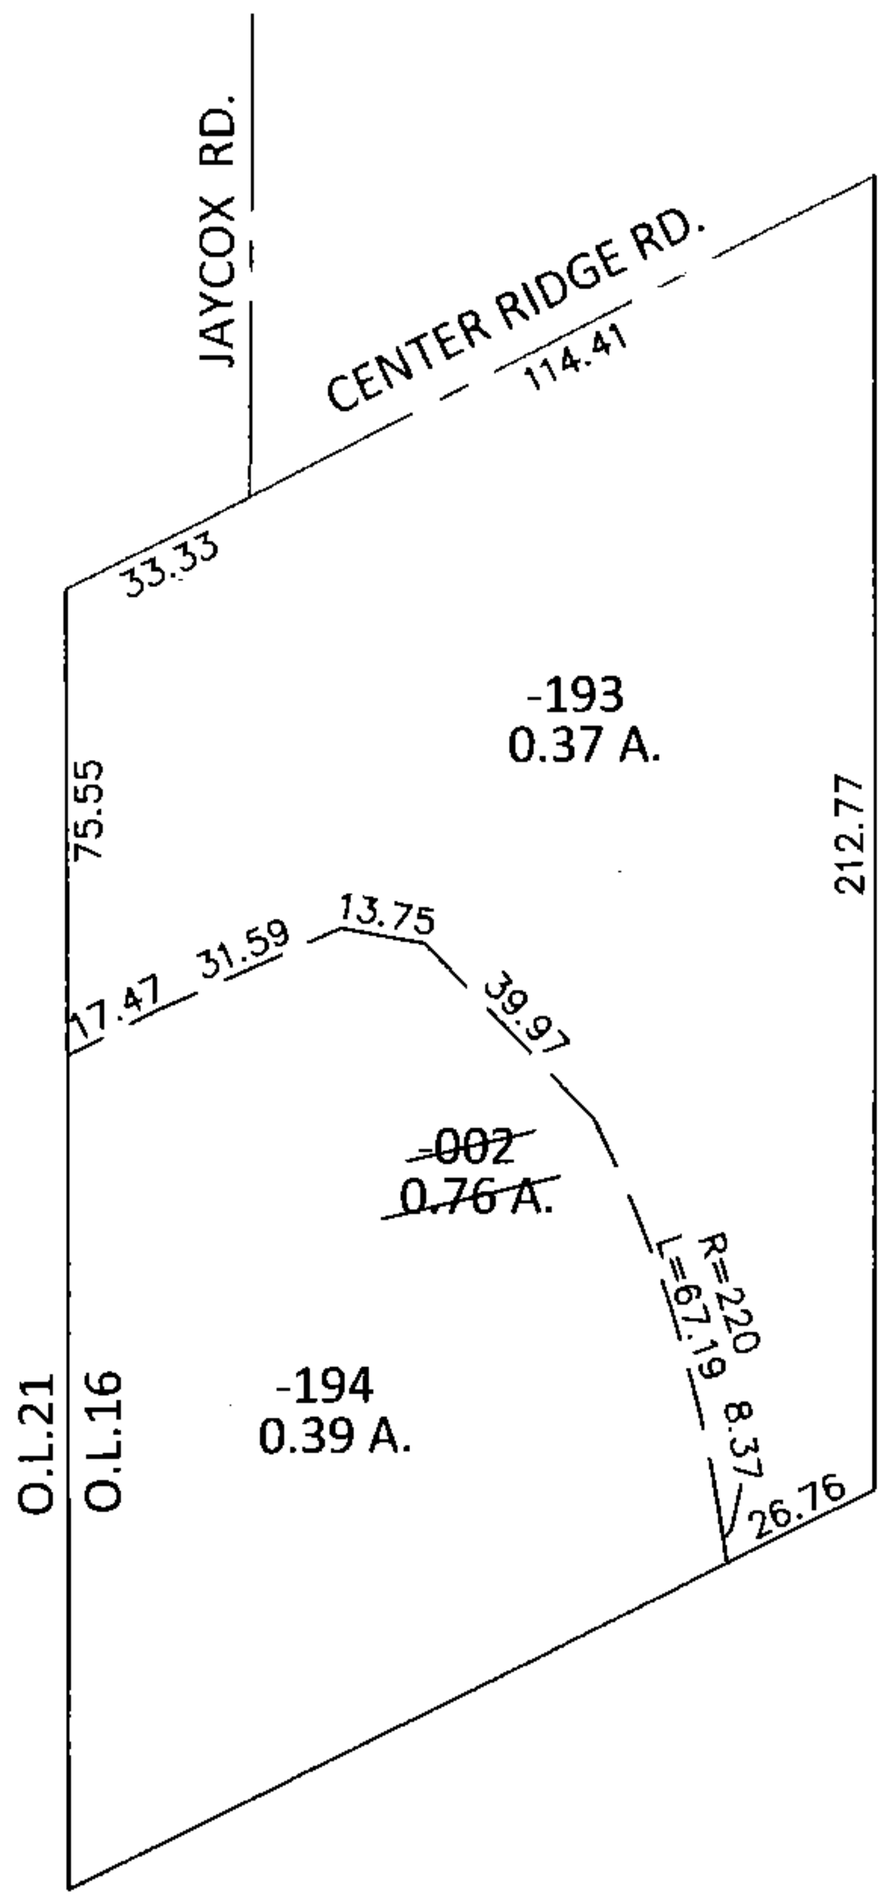

SPLITS/DEEDS PROCESSED

LORAIN COUNTY TAX MAP DEPARTMENT
226 MIDDLE AVE. ELYRIA, OHIO

SURVEYED BY: WILLIAM D. THOMAS
CLOSURE: .01:10,000
MAP PAGE(S): 7-00-016-A
APPROVED BY: RRM DATE: 11-3-14
SCALE: 1"= 50' PRIOR INST.: 20080272781