#14004

Acreages Correction only

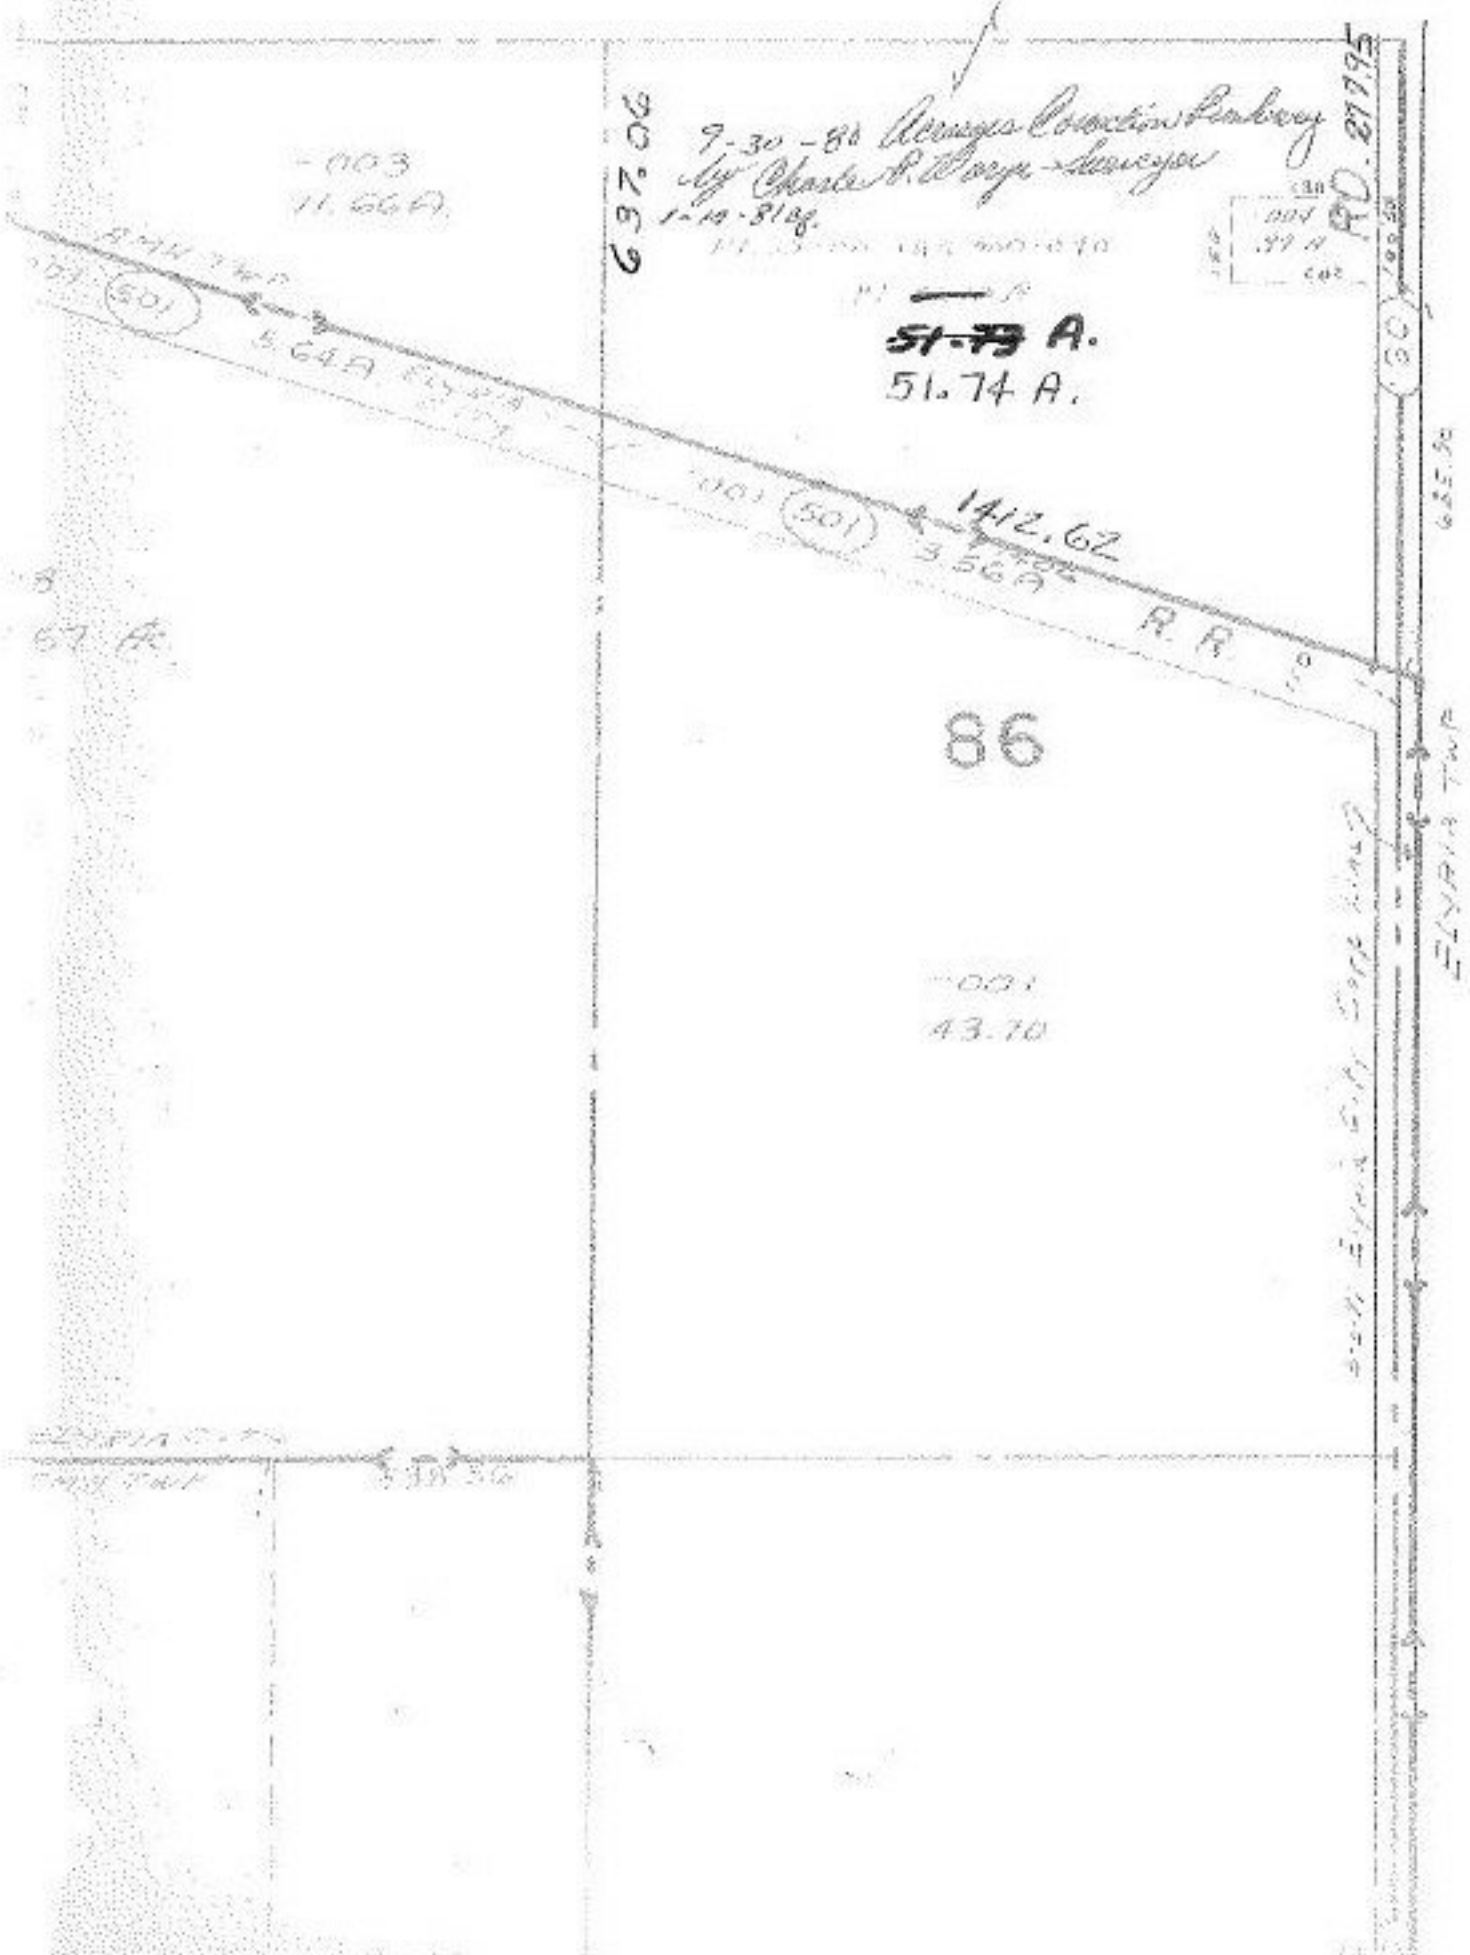

T.M.
4-10-81

#14004

APPROVED
LORAIN CO.
MAP DEPT.
DATE 1-14-81
PAGE 5-11
BY Carolyn E. Lowe
VOID AFTER