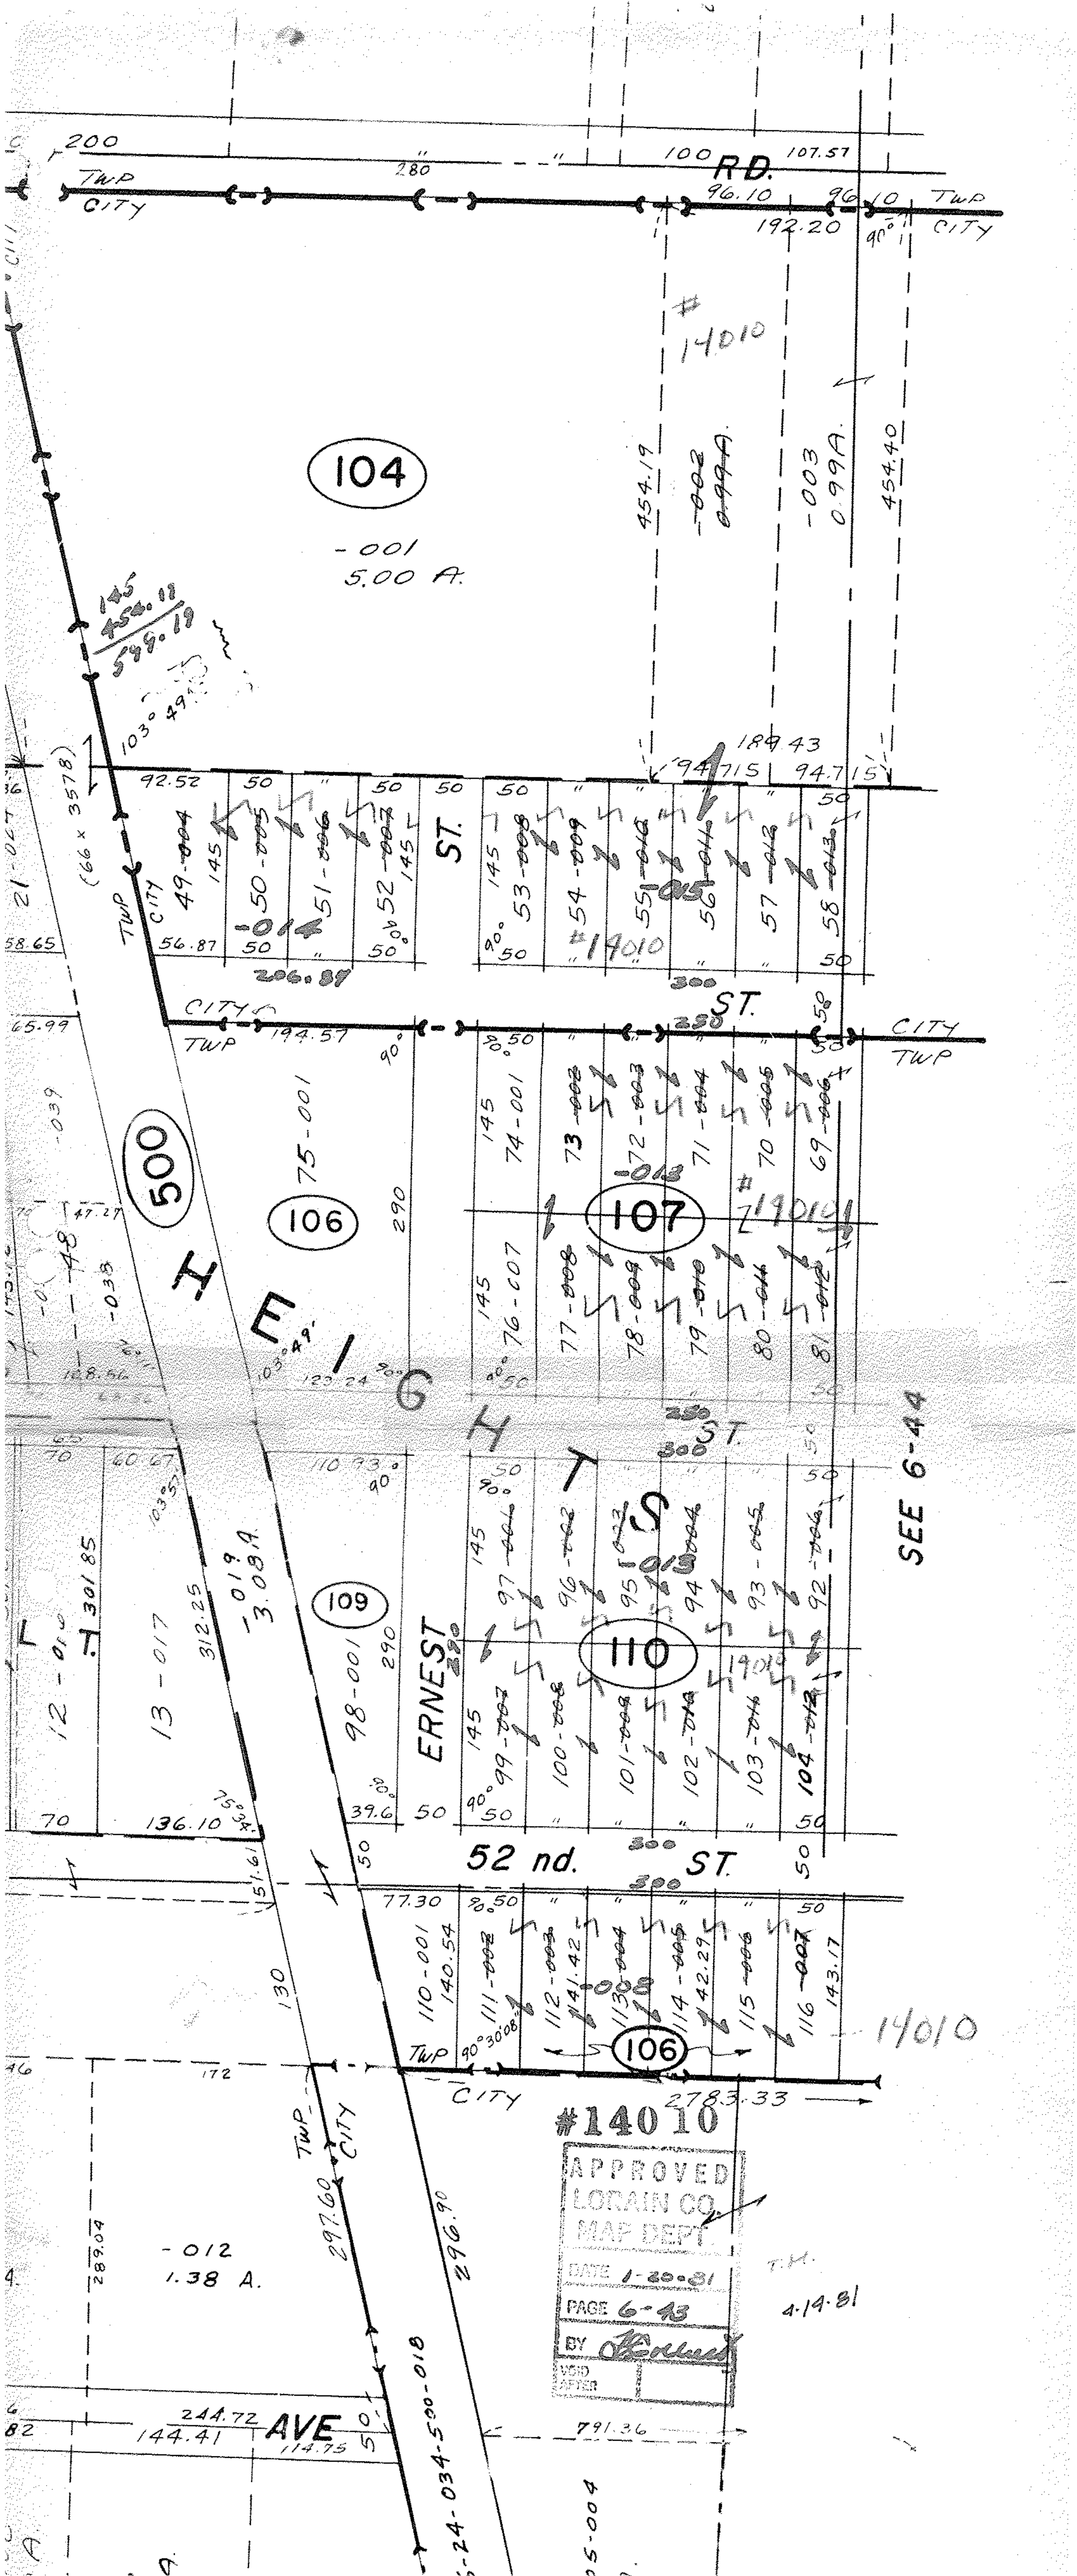

RD.
TWP
CITY
104
-001
5.00 A.
#14010
-003
0.99A.
454.19
454.40
500
106
107
109
110
HEIGHTS
ST.
ERNEST
52 nd. ST.
SEE 6-44
-012
1.38 A.
AVE
#14010
APPROVED
LORAIN CO.
MAP DEPT.
DATE 1-20-81
PAGE 6-43
BY
VOID AFTER
4-14-81