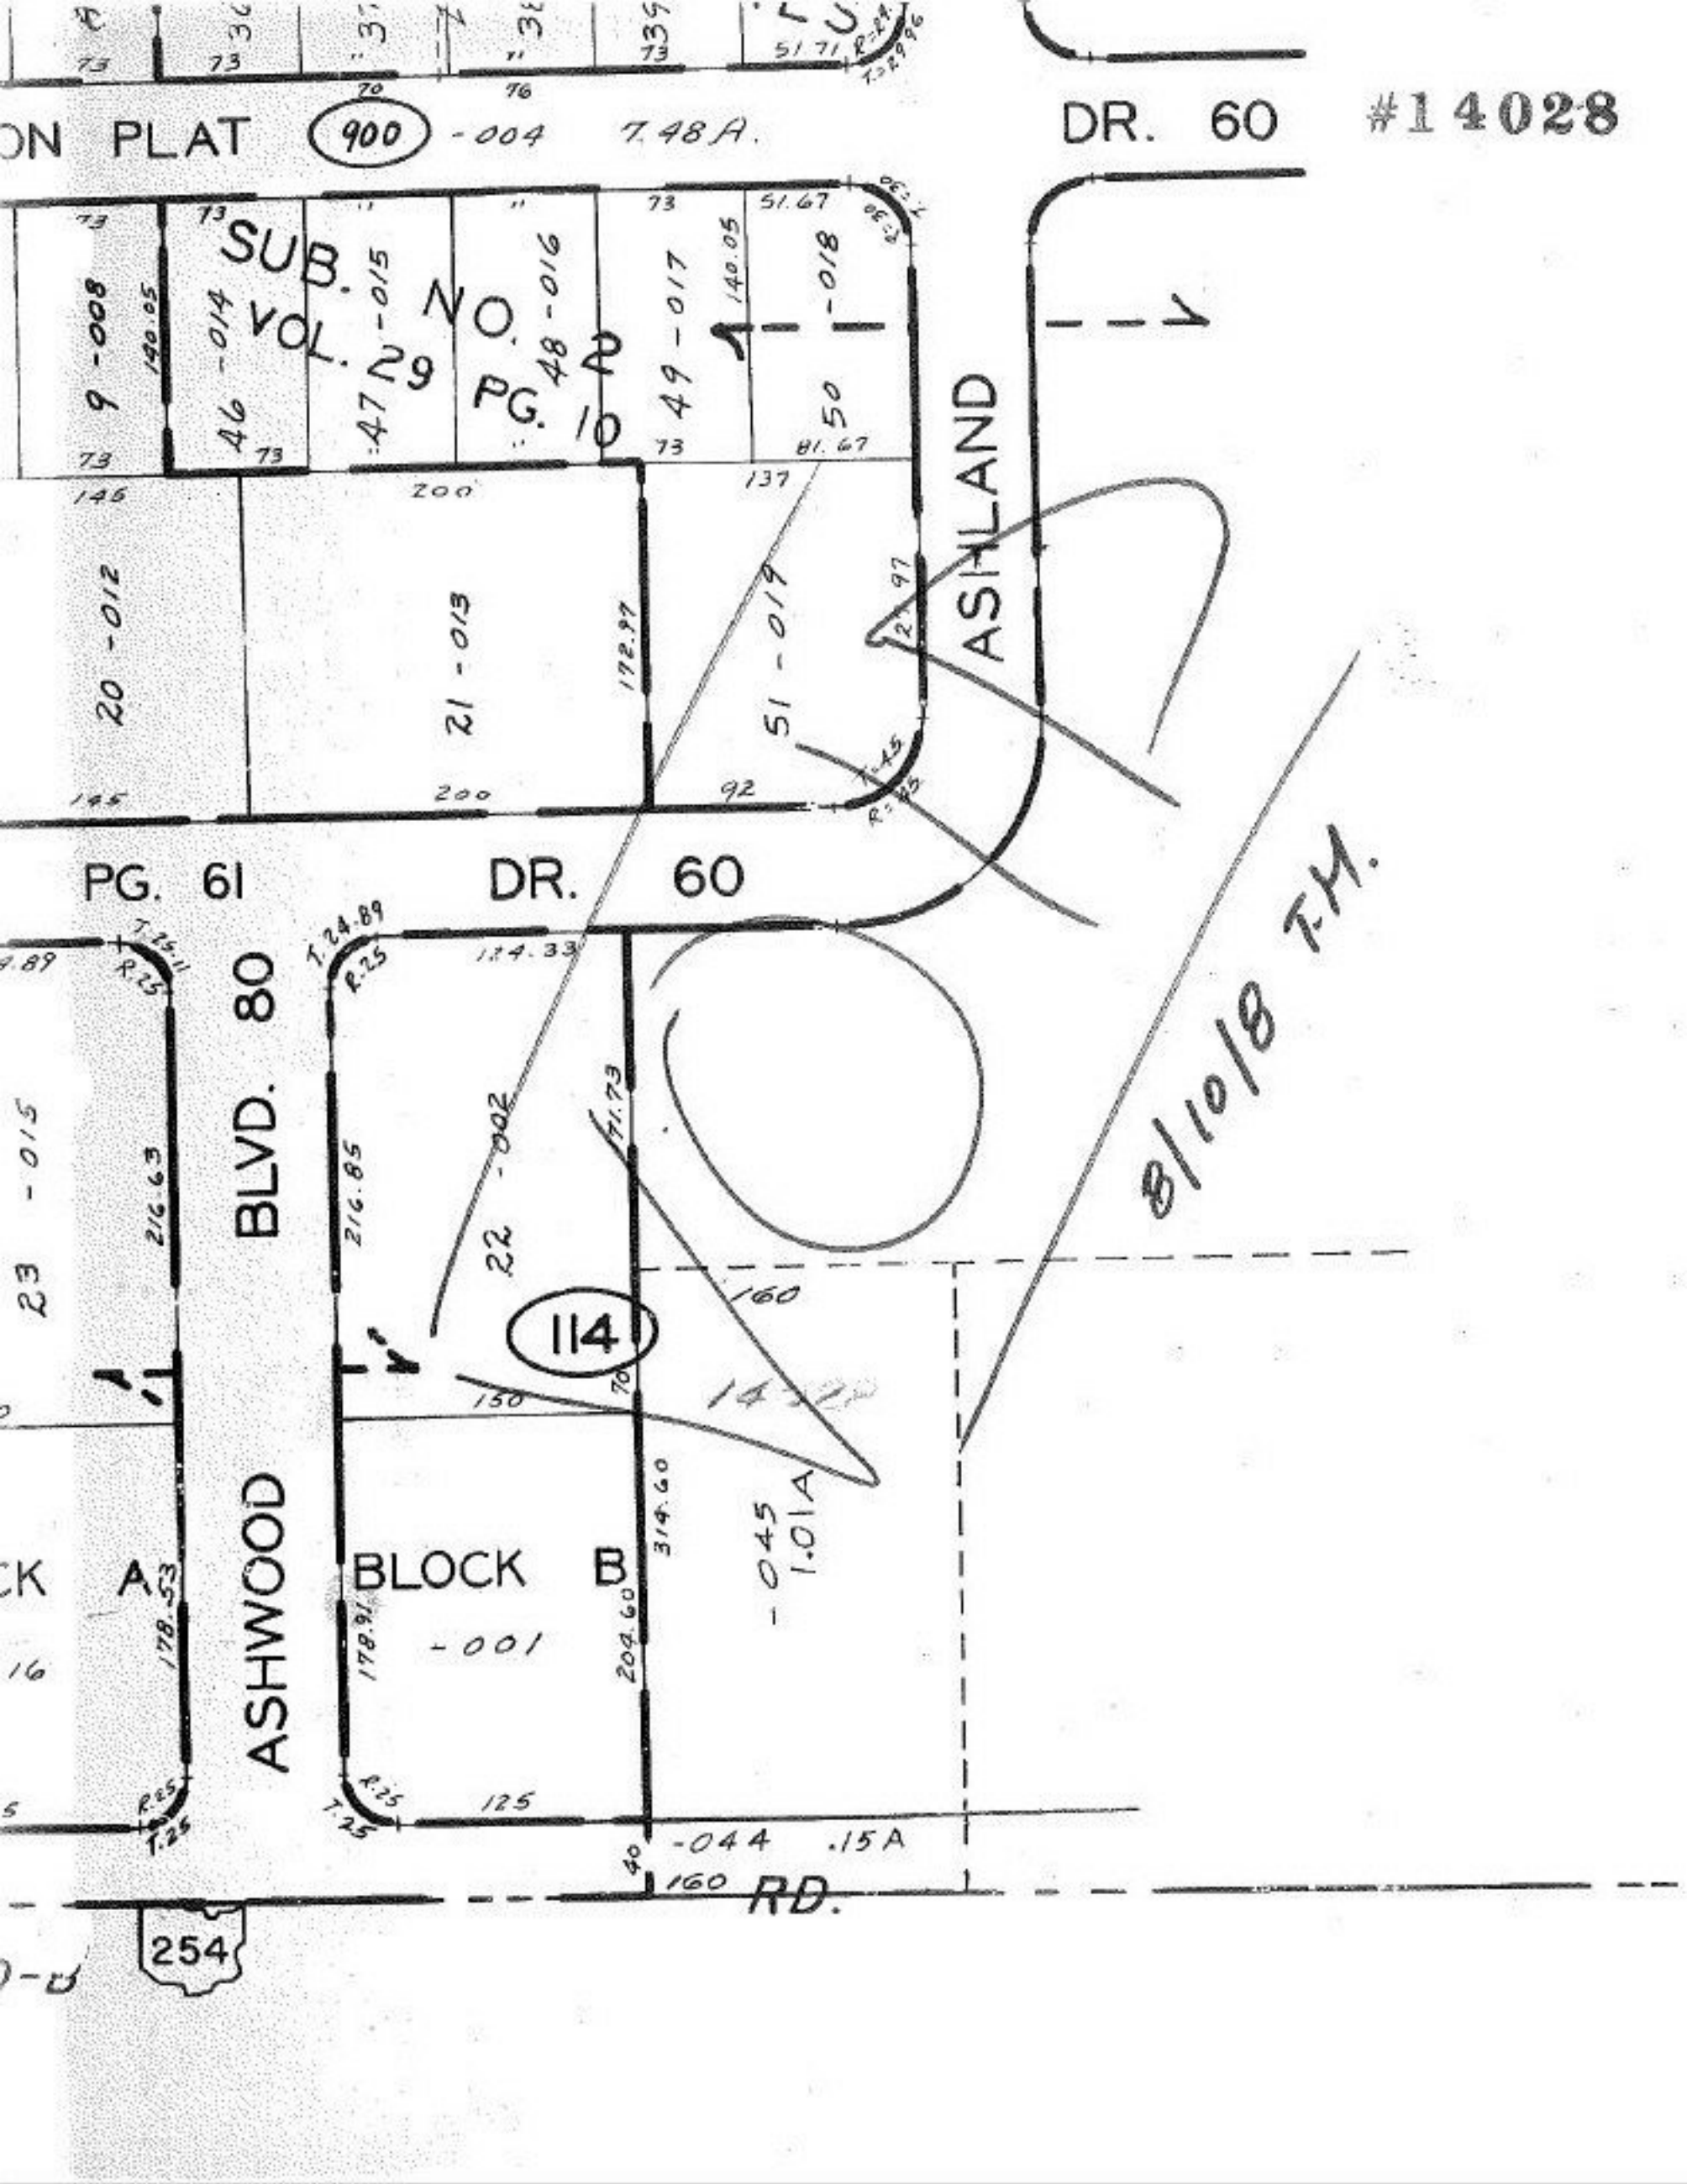

#14028
ON PLAT
900
-004
7.48A.
DR. 60
SUB. NO. 2
VOL. 29
PG. 10
9-008
46-014
47-015
48-016
49-017
50-018
ASHLAND
20-012
21-013
51-019
PG. 61
DR. 60
BLVD. 80
ASHWOOD
BLOCK A
BLOCK B
-001
22-002
114
-045
1.01A
-044
.15A
RD.
254
8/10/18 T.M.