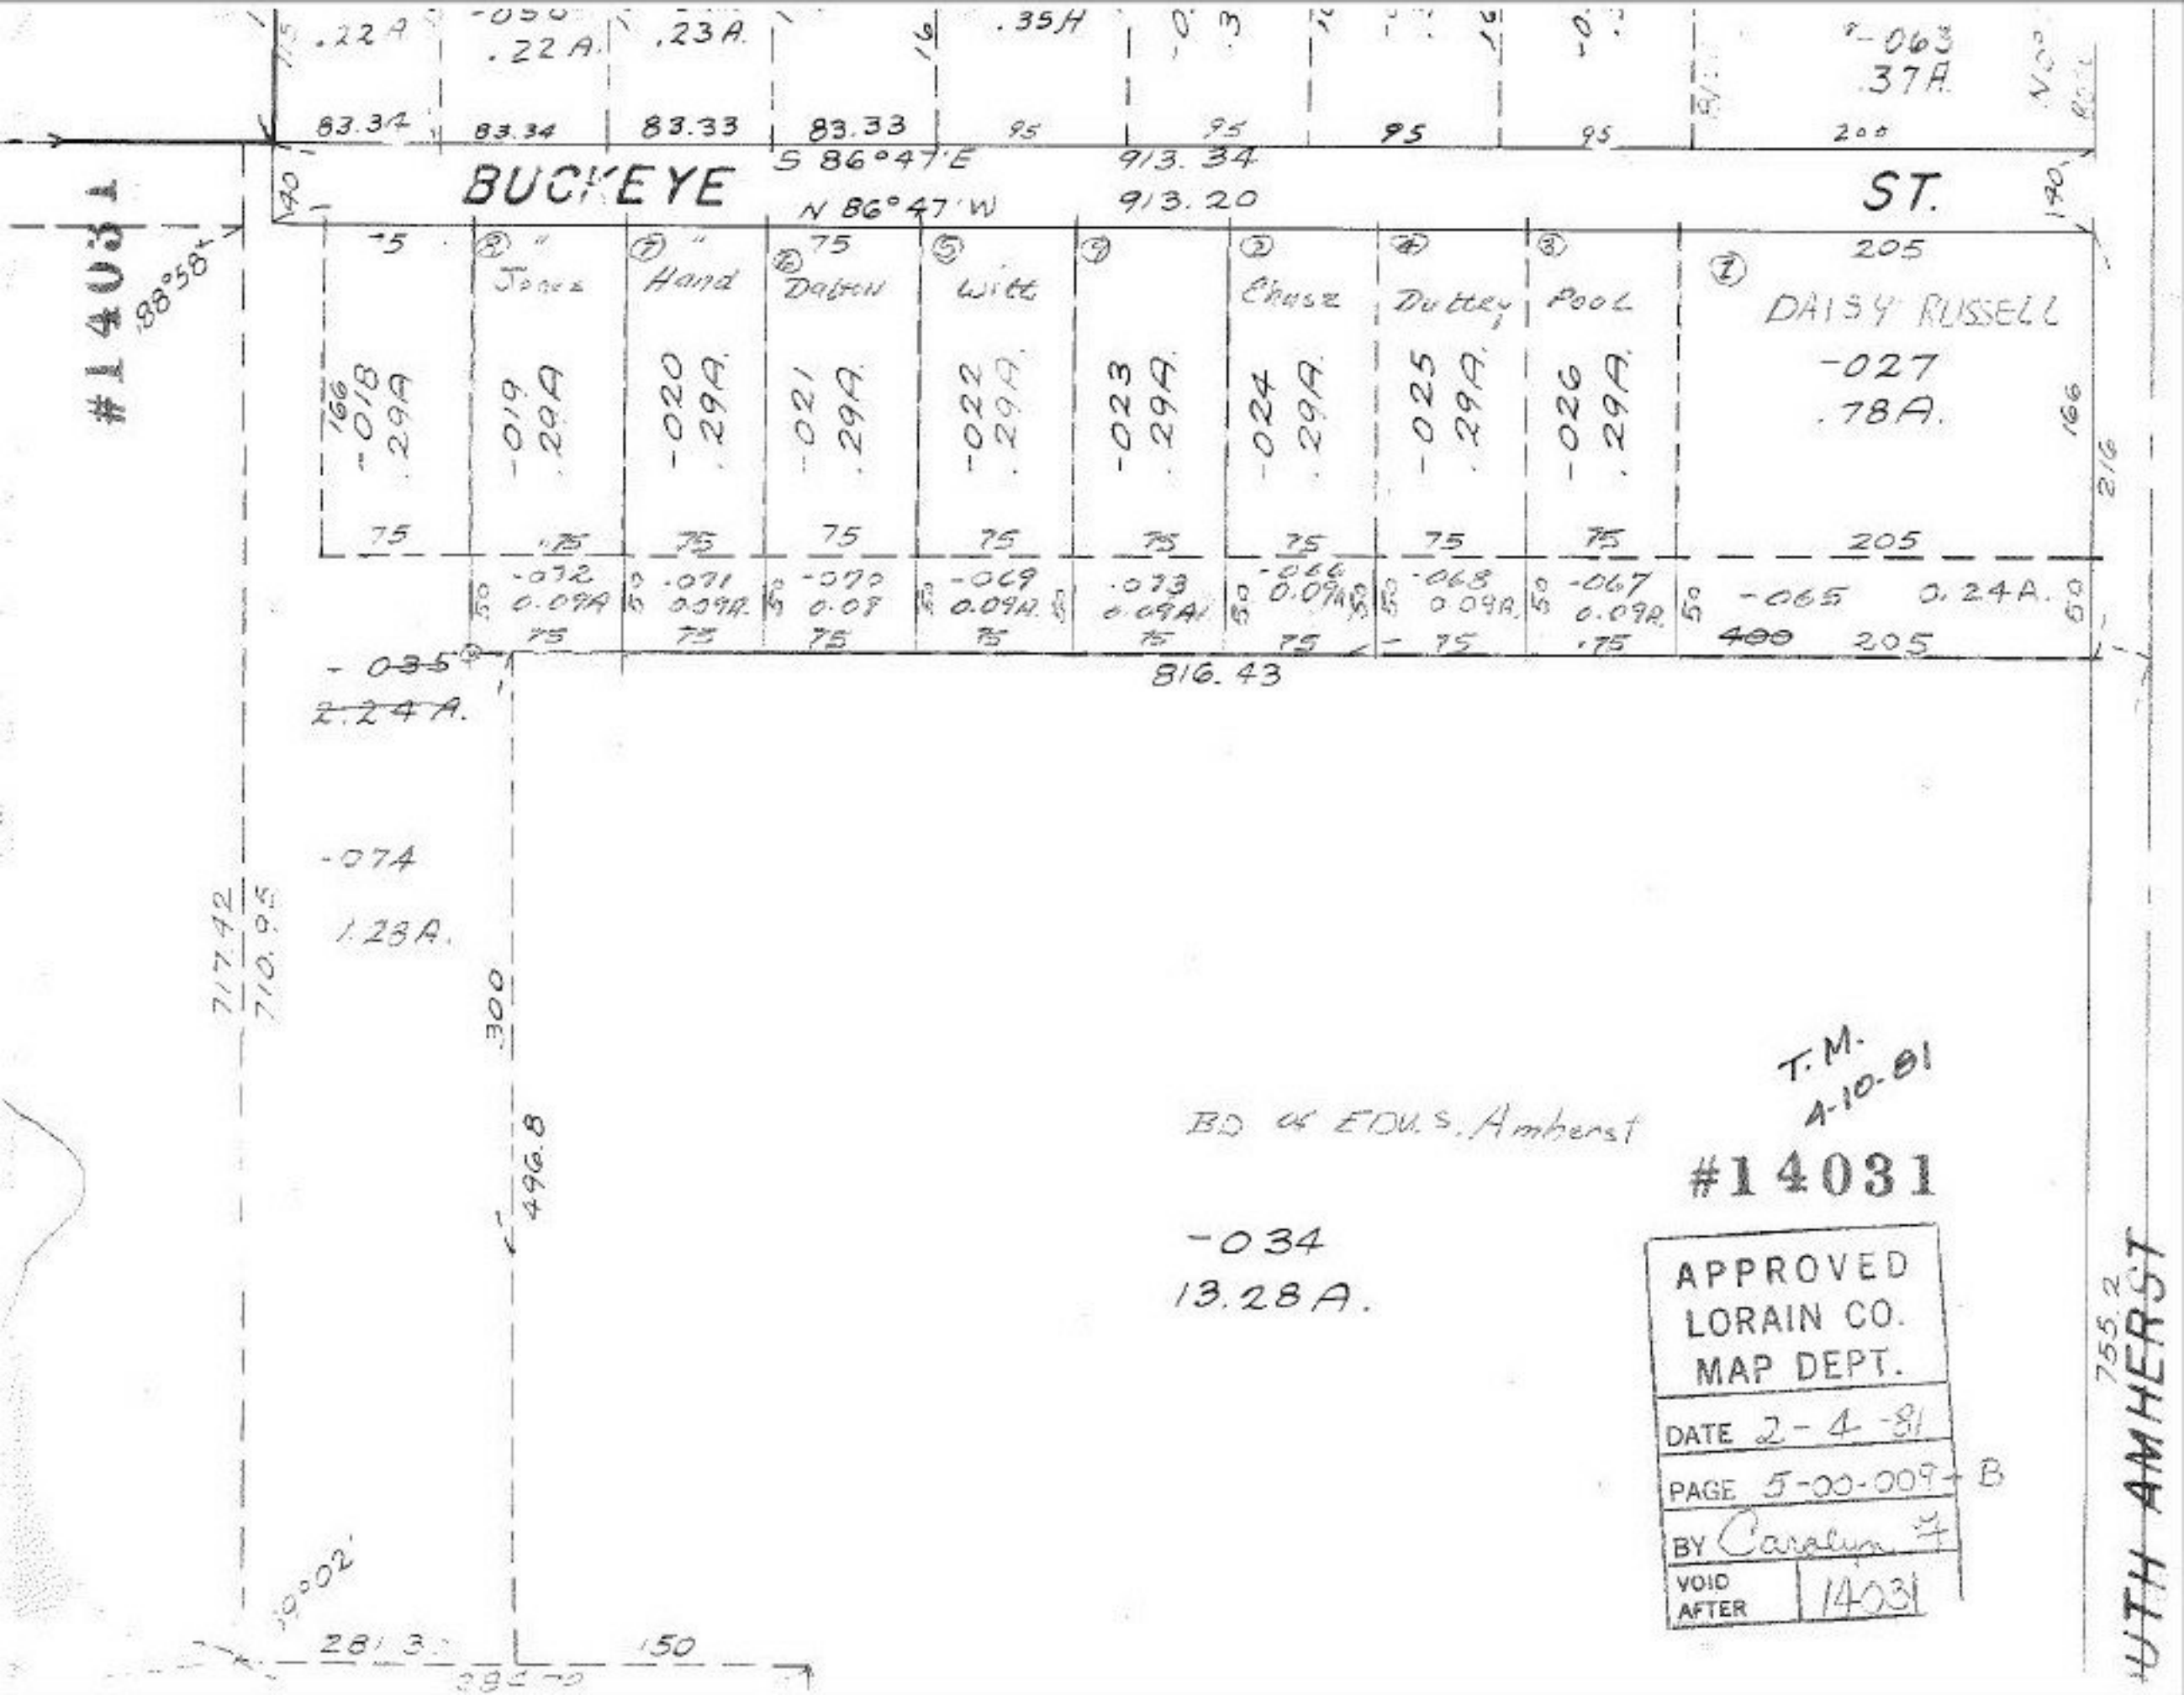

BUCKEYE ST.
S 86°47'E 913.34
N 86°47'W 913.20
#14031
88°58'
Jones
Hand
Dalton
Witt
Chase
Duttry
Pool
DAISY RUSSELL
-027
.78A.
-065 0.24A.
816.43
-035
2.24A.
-074
1.28A.
717.42
710.95
300
496.8
BD of EDU.S. Amherst
-034
13.28A.
T.M.
4-10-81
#14031
APPROVED
LORAIN CO.
MAP DEPT.
DATE 2-4-81
PAGE 5-00-009-B
BY Carolyn F
VOID AFTER 14031
755.2
UTH AMHERST