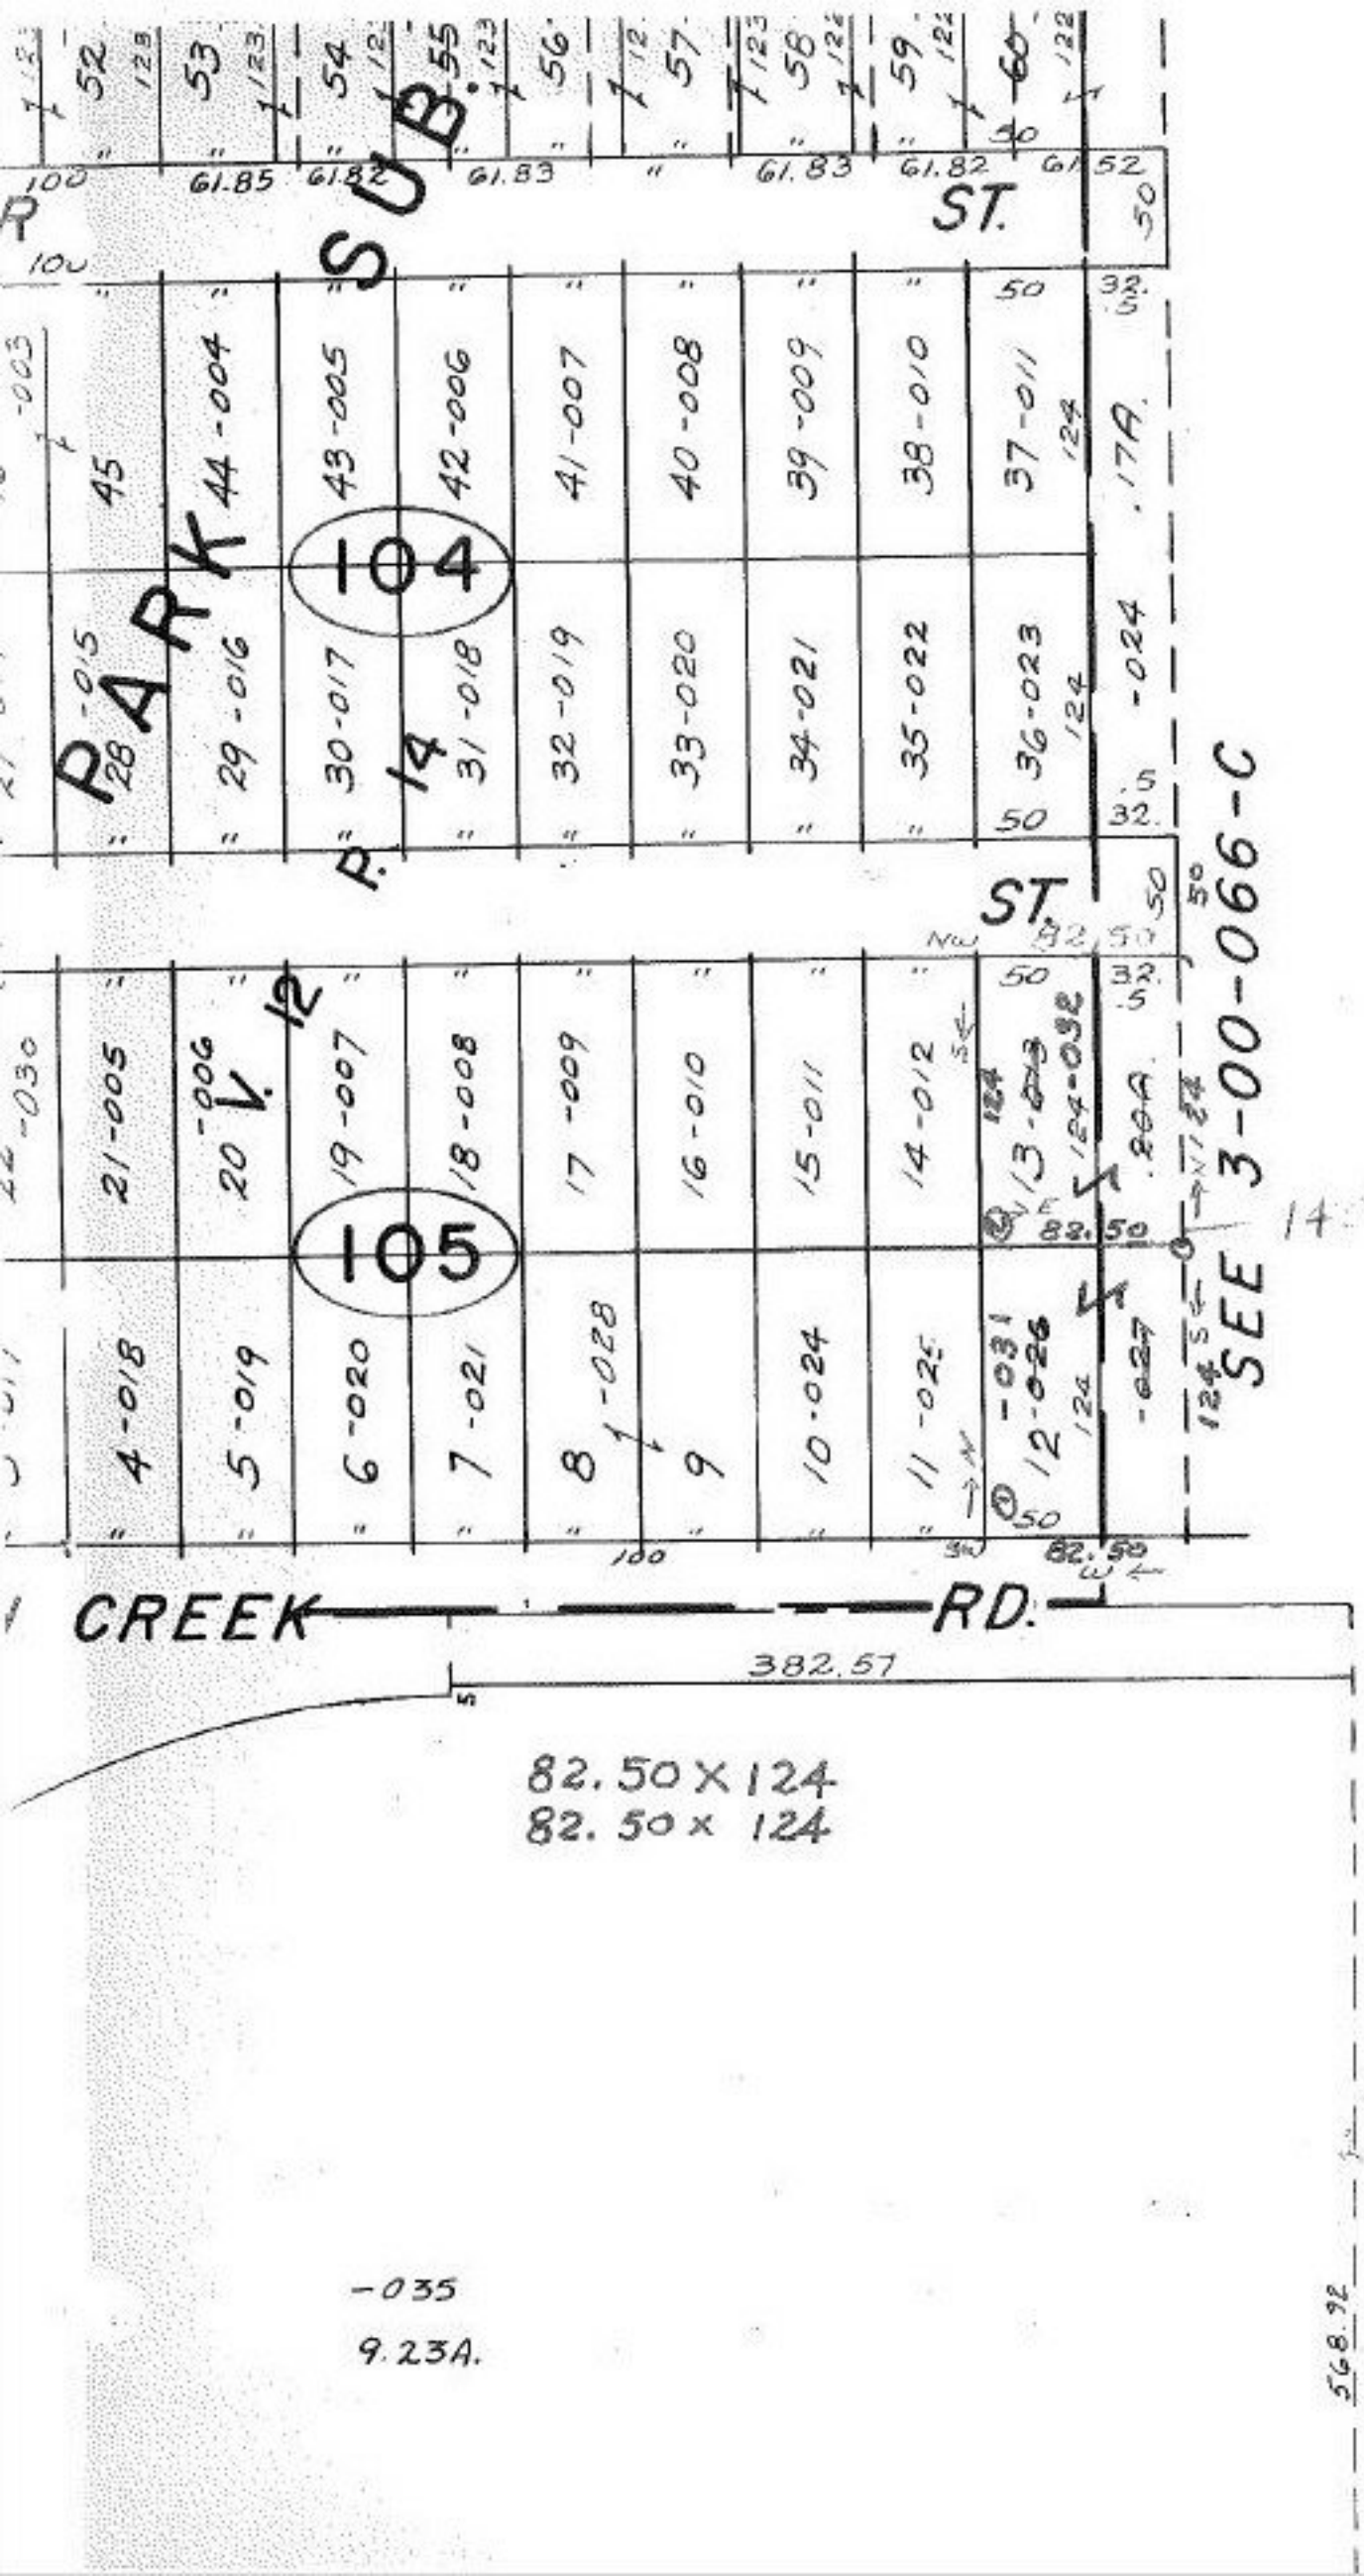

CORRECTION

#14040

T.M. 4.8.81

APPROVED
LORAIN CO.
MAP DEPT.

DATE 2-12-81

PAGE 03-00-066-B

BY [signature]

VOID AFTER 14040