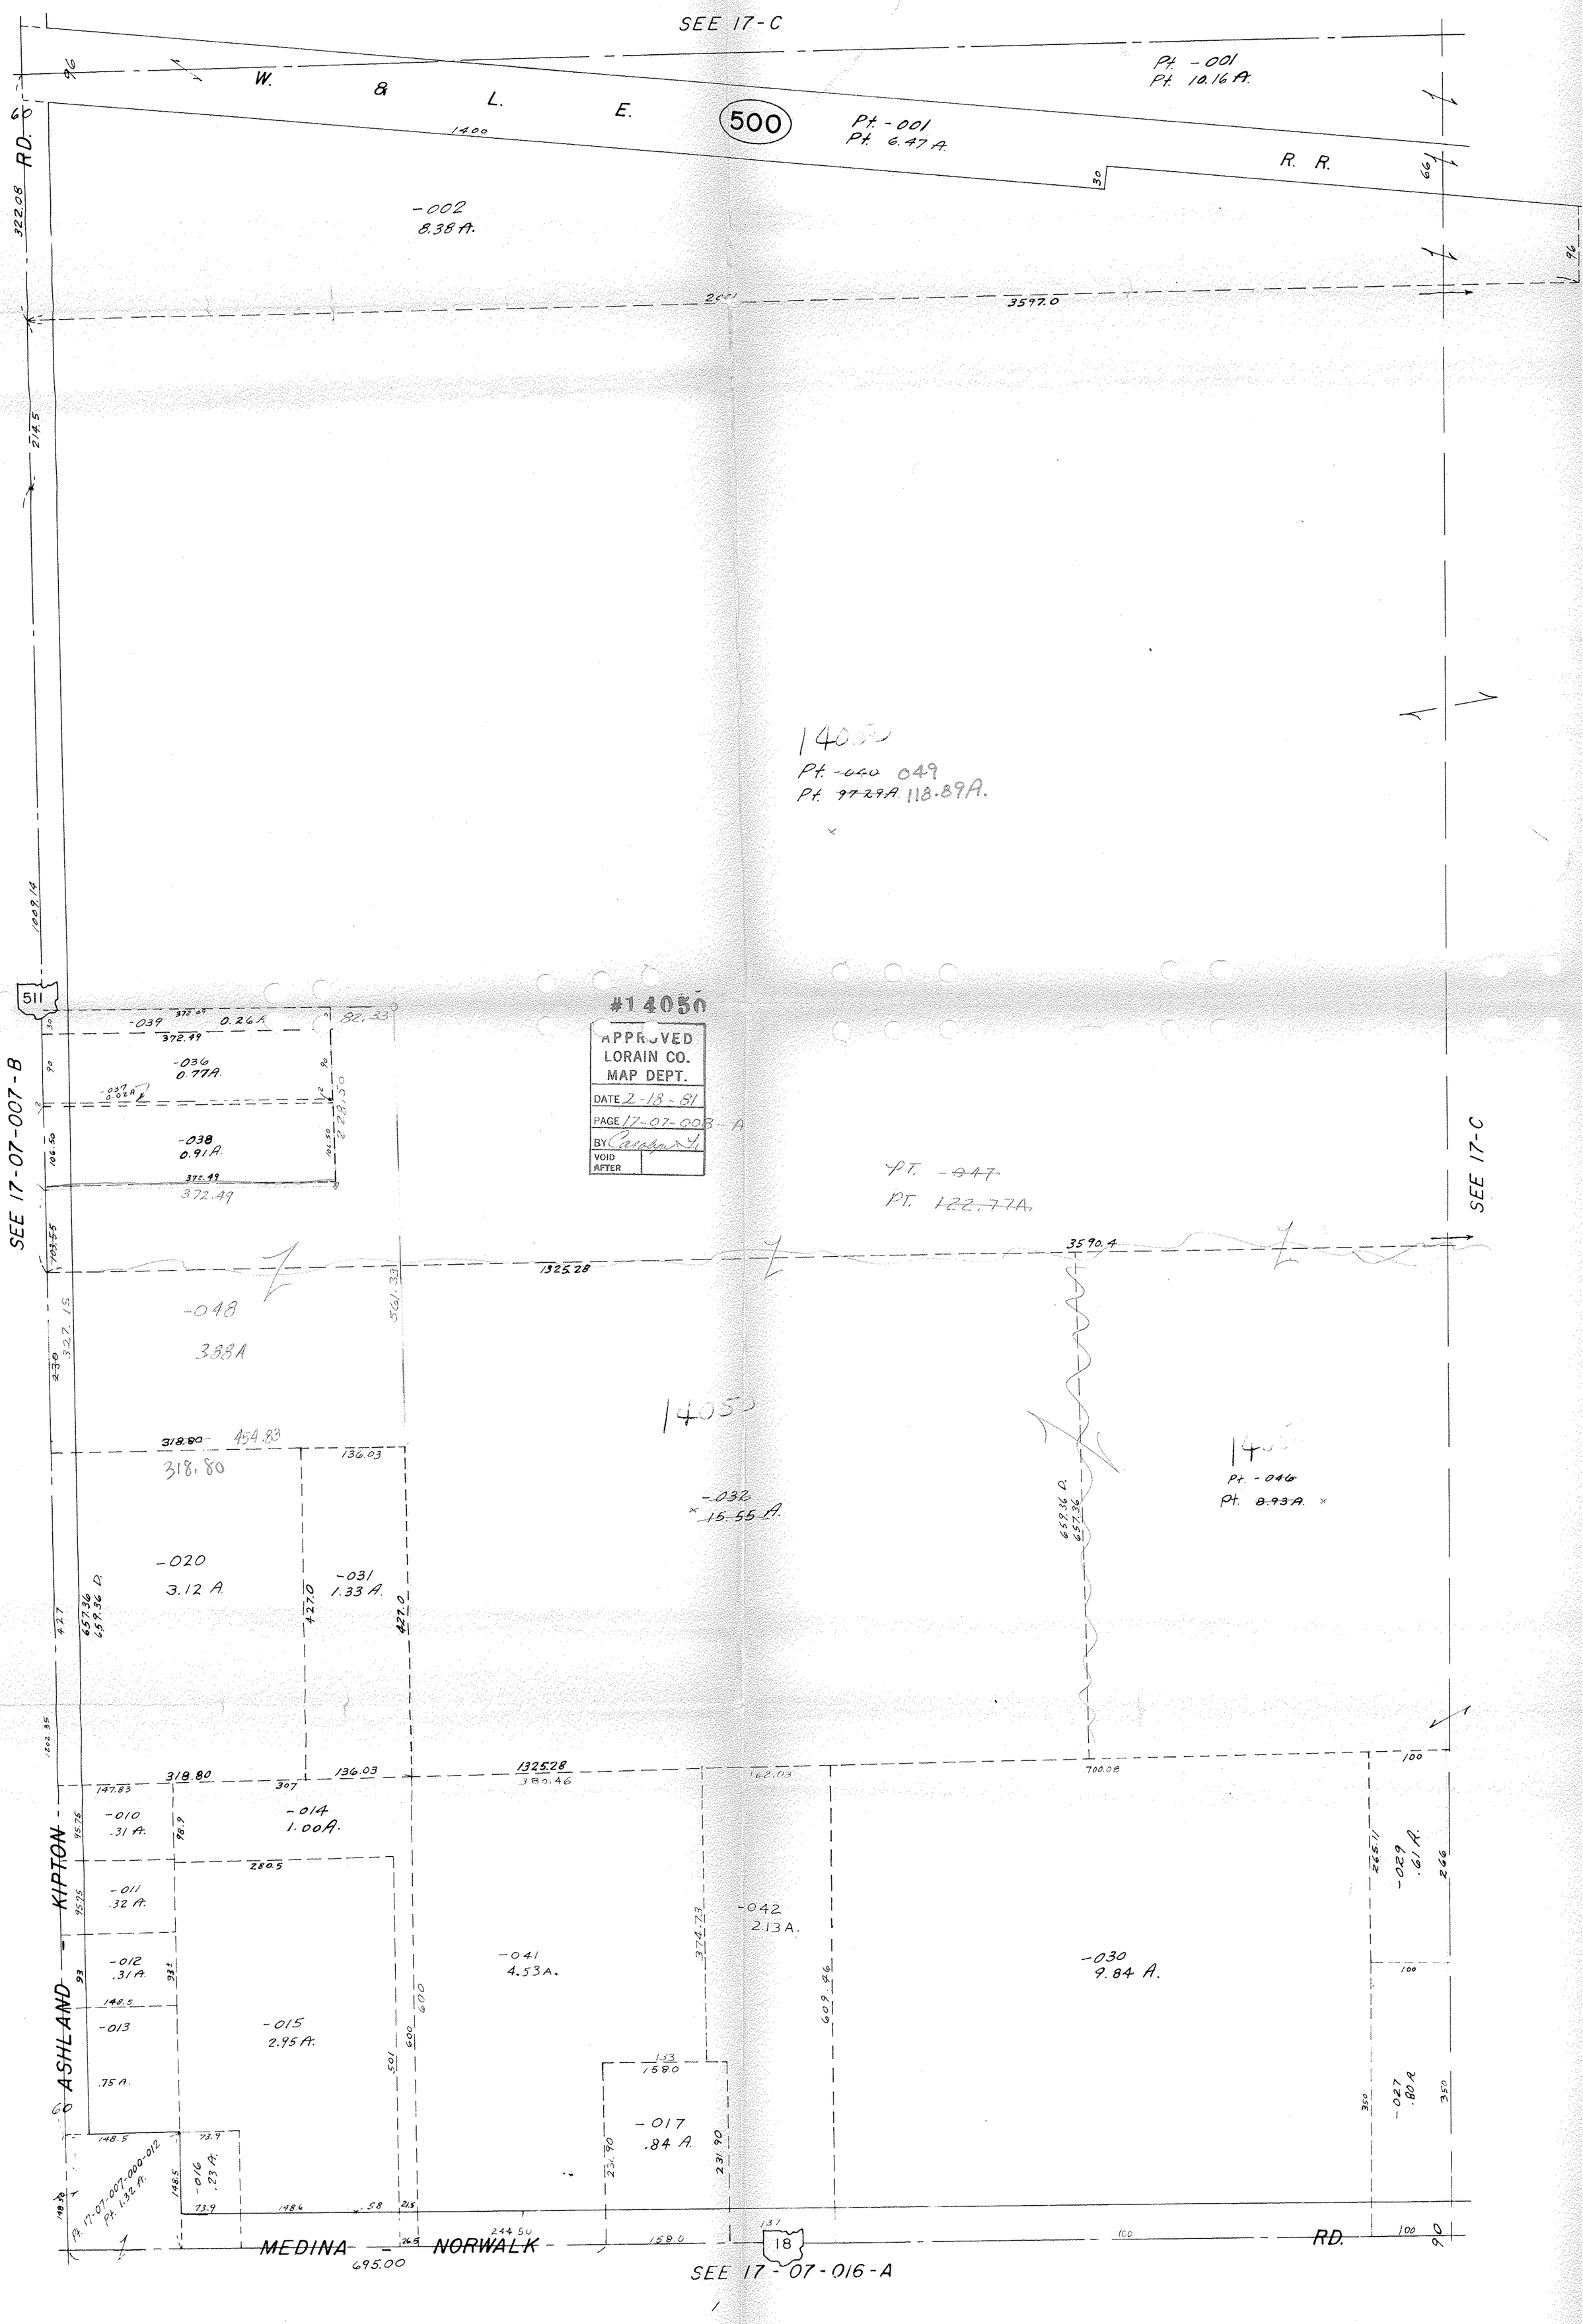

ght 1962

07-008-A

BRIGHTON TWP.

SCALE: 1" = 100'

TRACT 7 WLY. PT. LOT 8