#14062

103

24

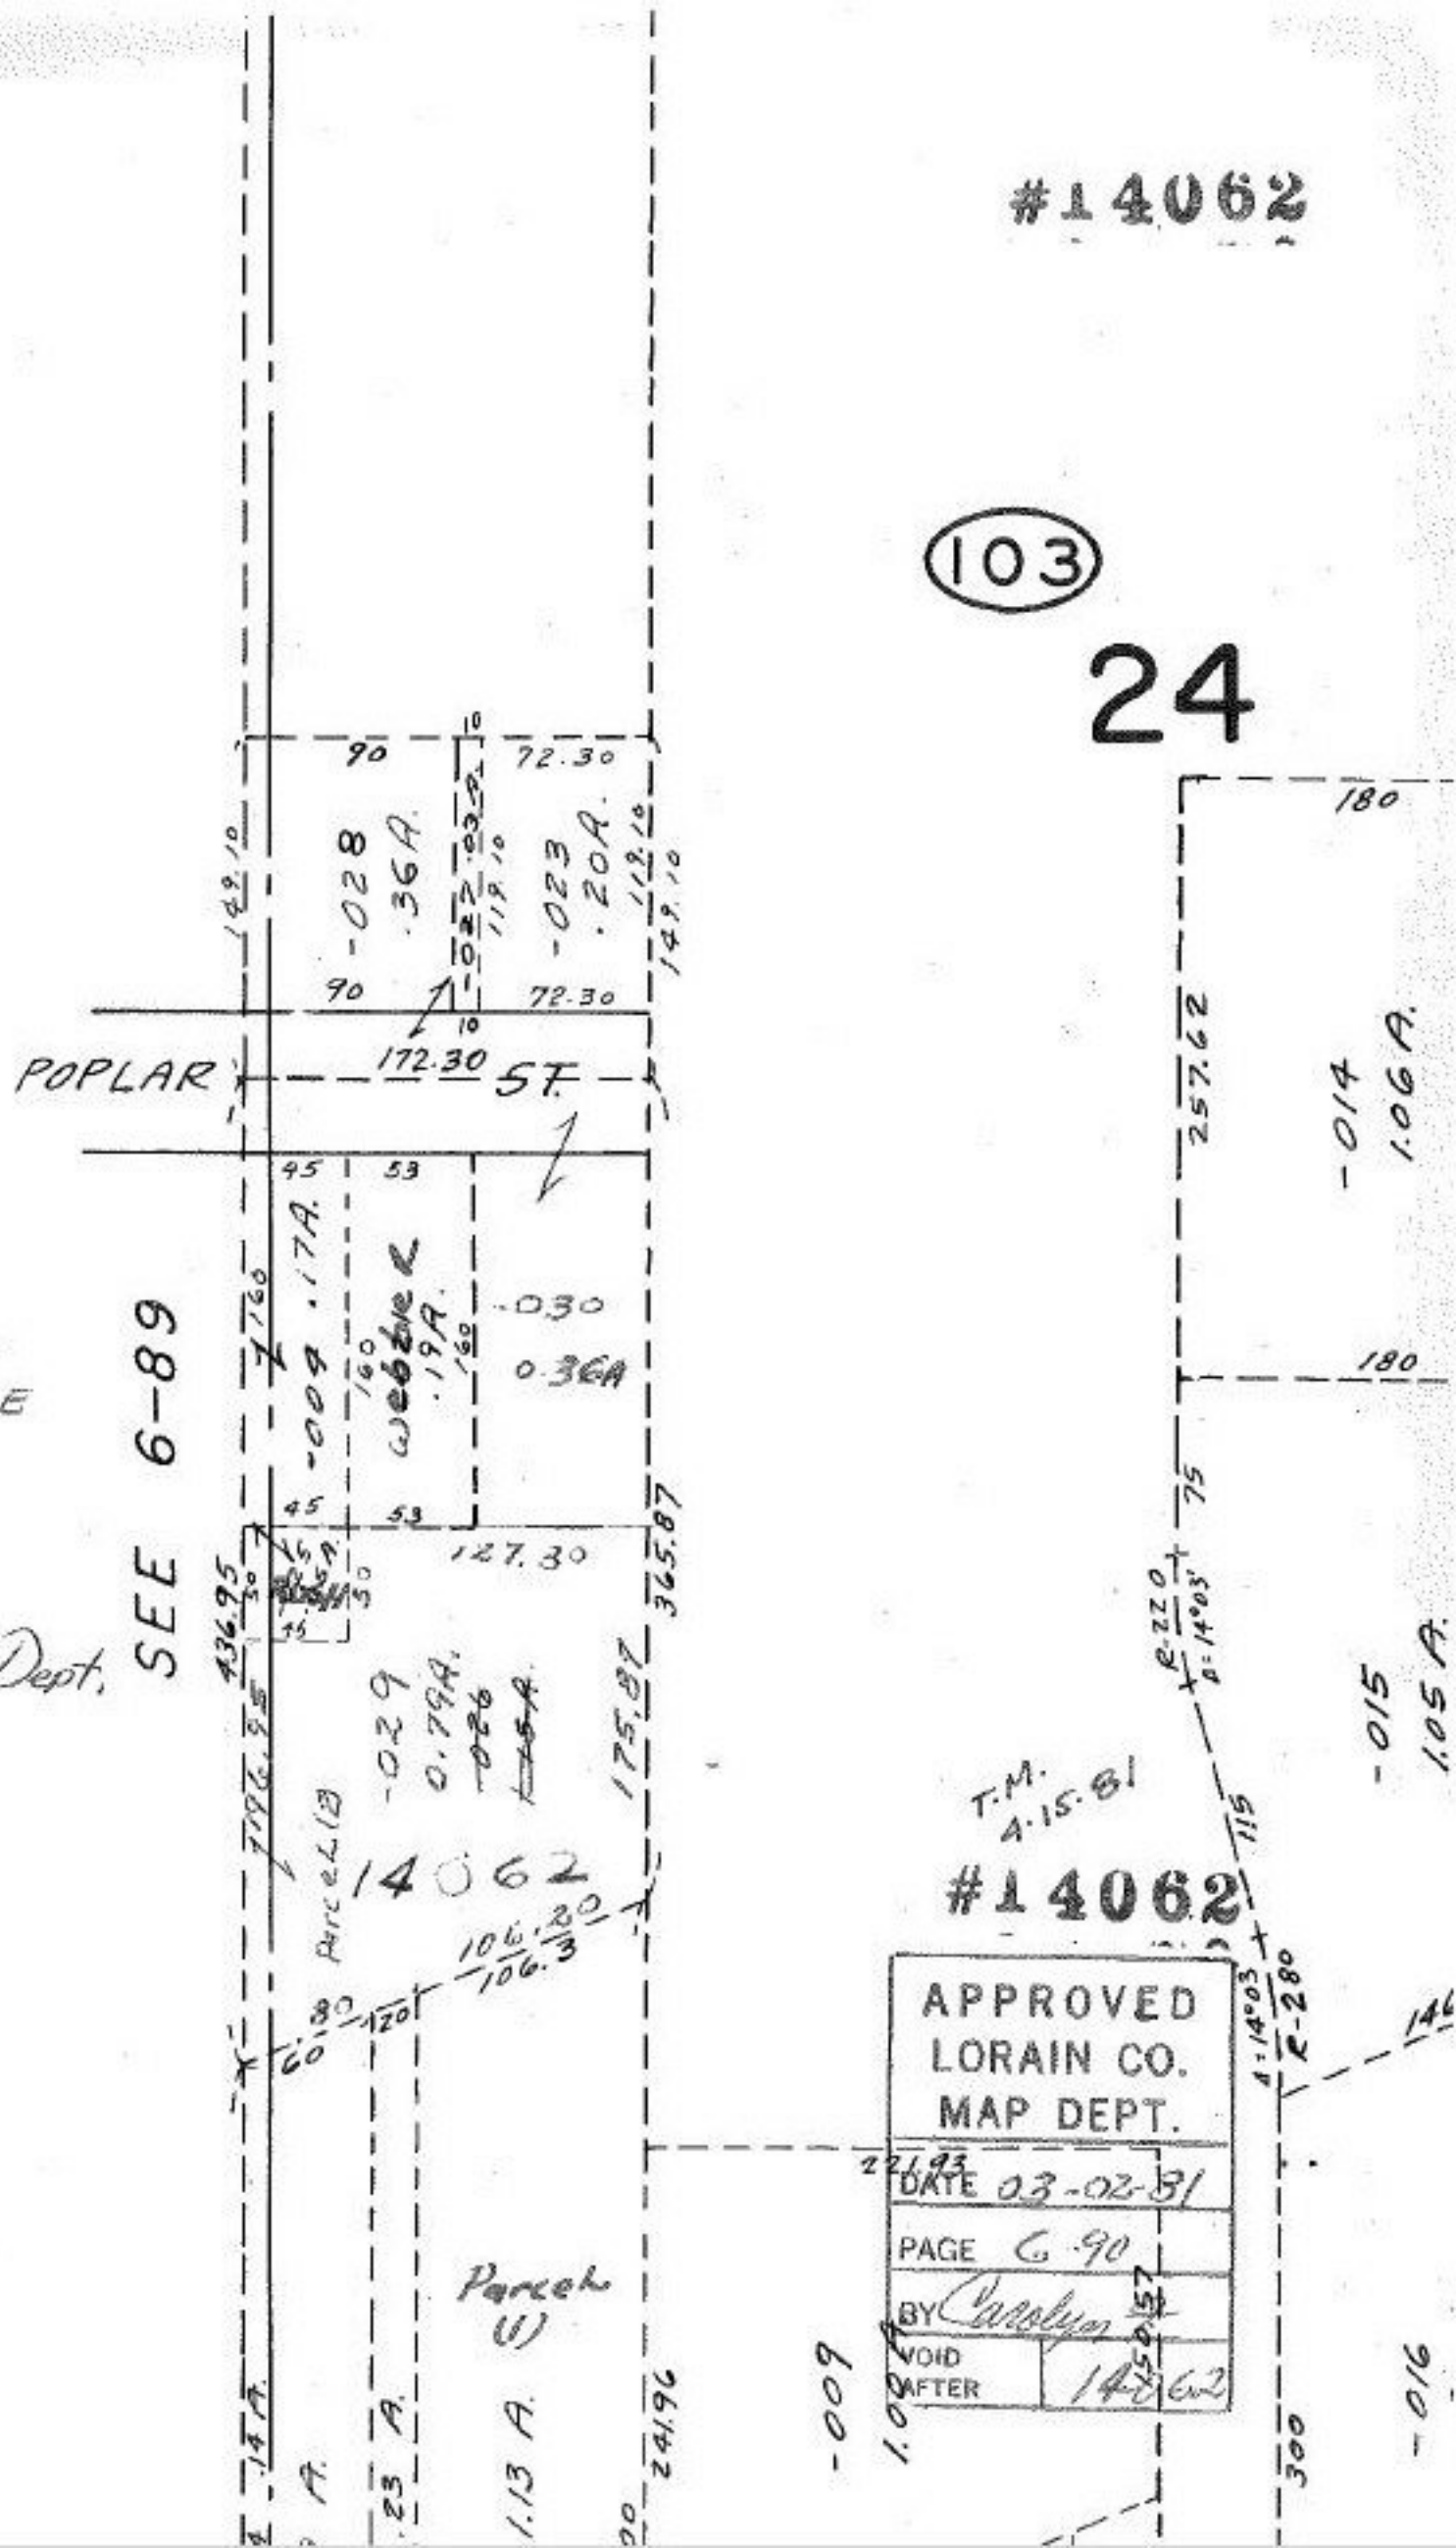

DEED 1266/27
USED TO CUT OUT
-029. NO ACREAGE
GIVEN
Acreages
Cal. Per Map Dept.

APPROVED
LORAIN CO.
MAP DEPT.
DATE 03-02-81
PAGE 6-90
BY Carolyn
VOID AFTER 14062