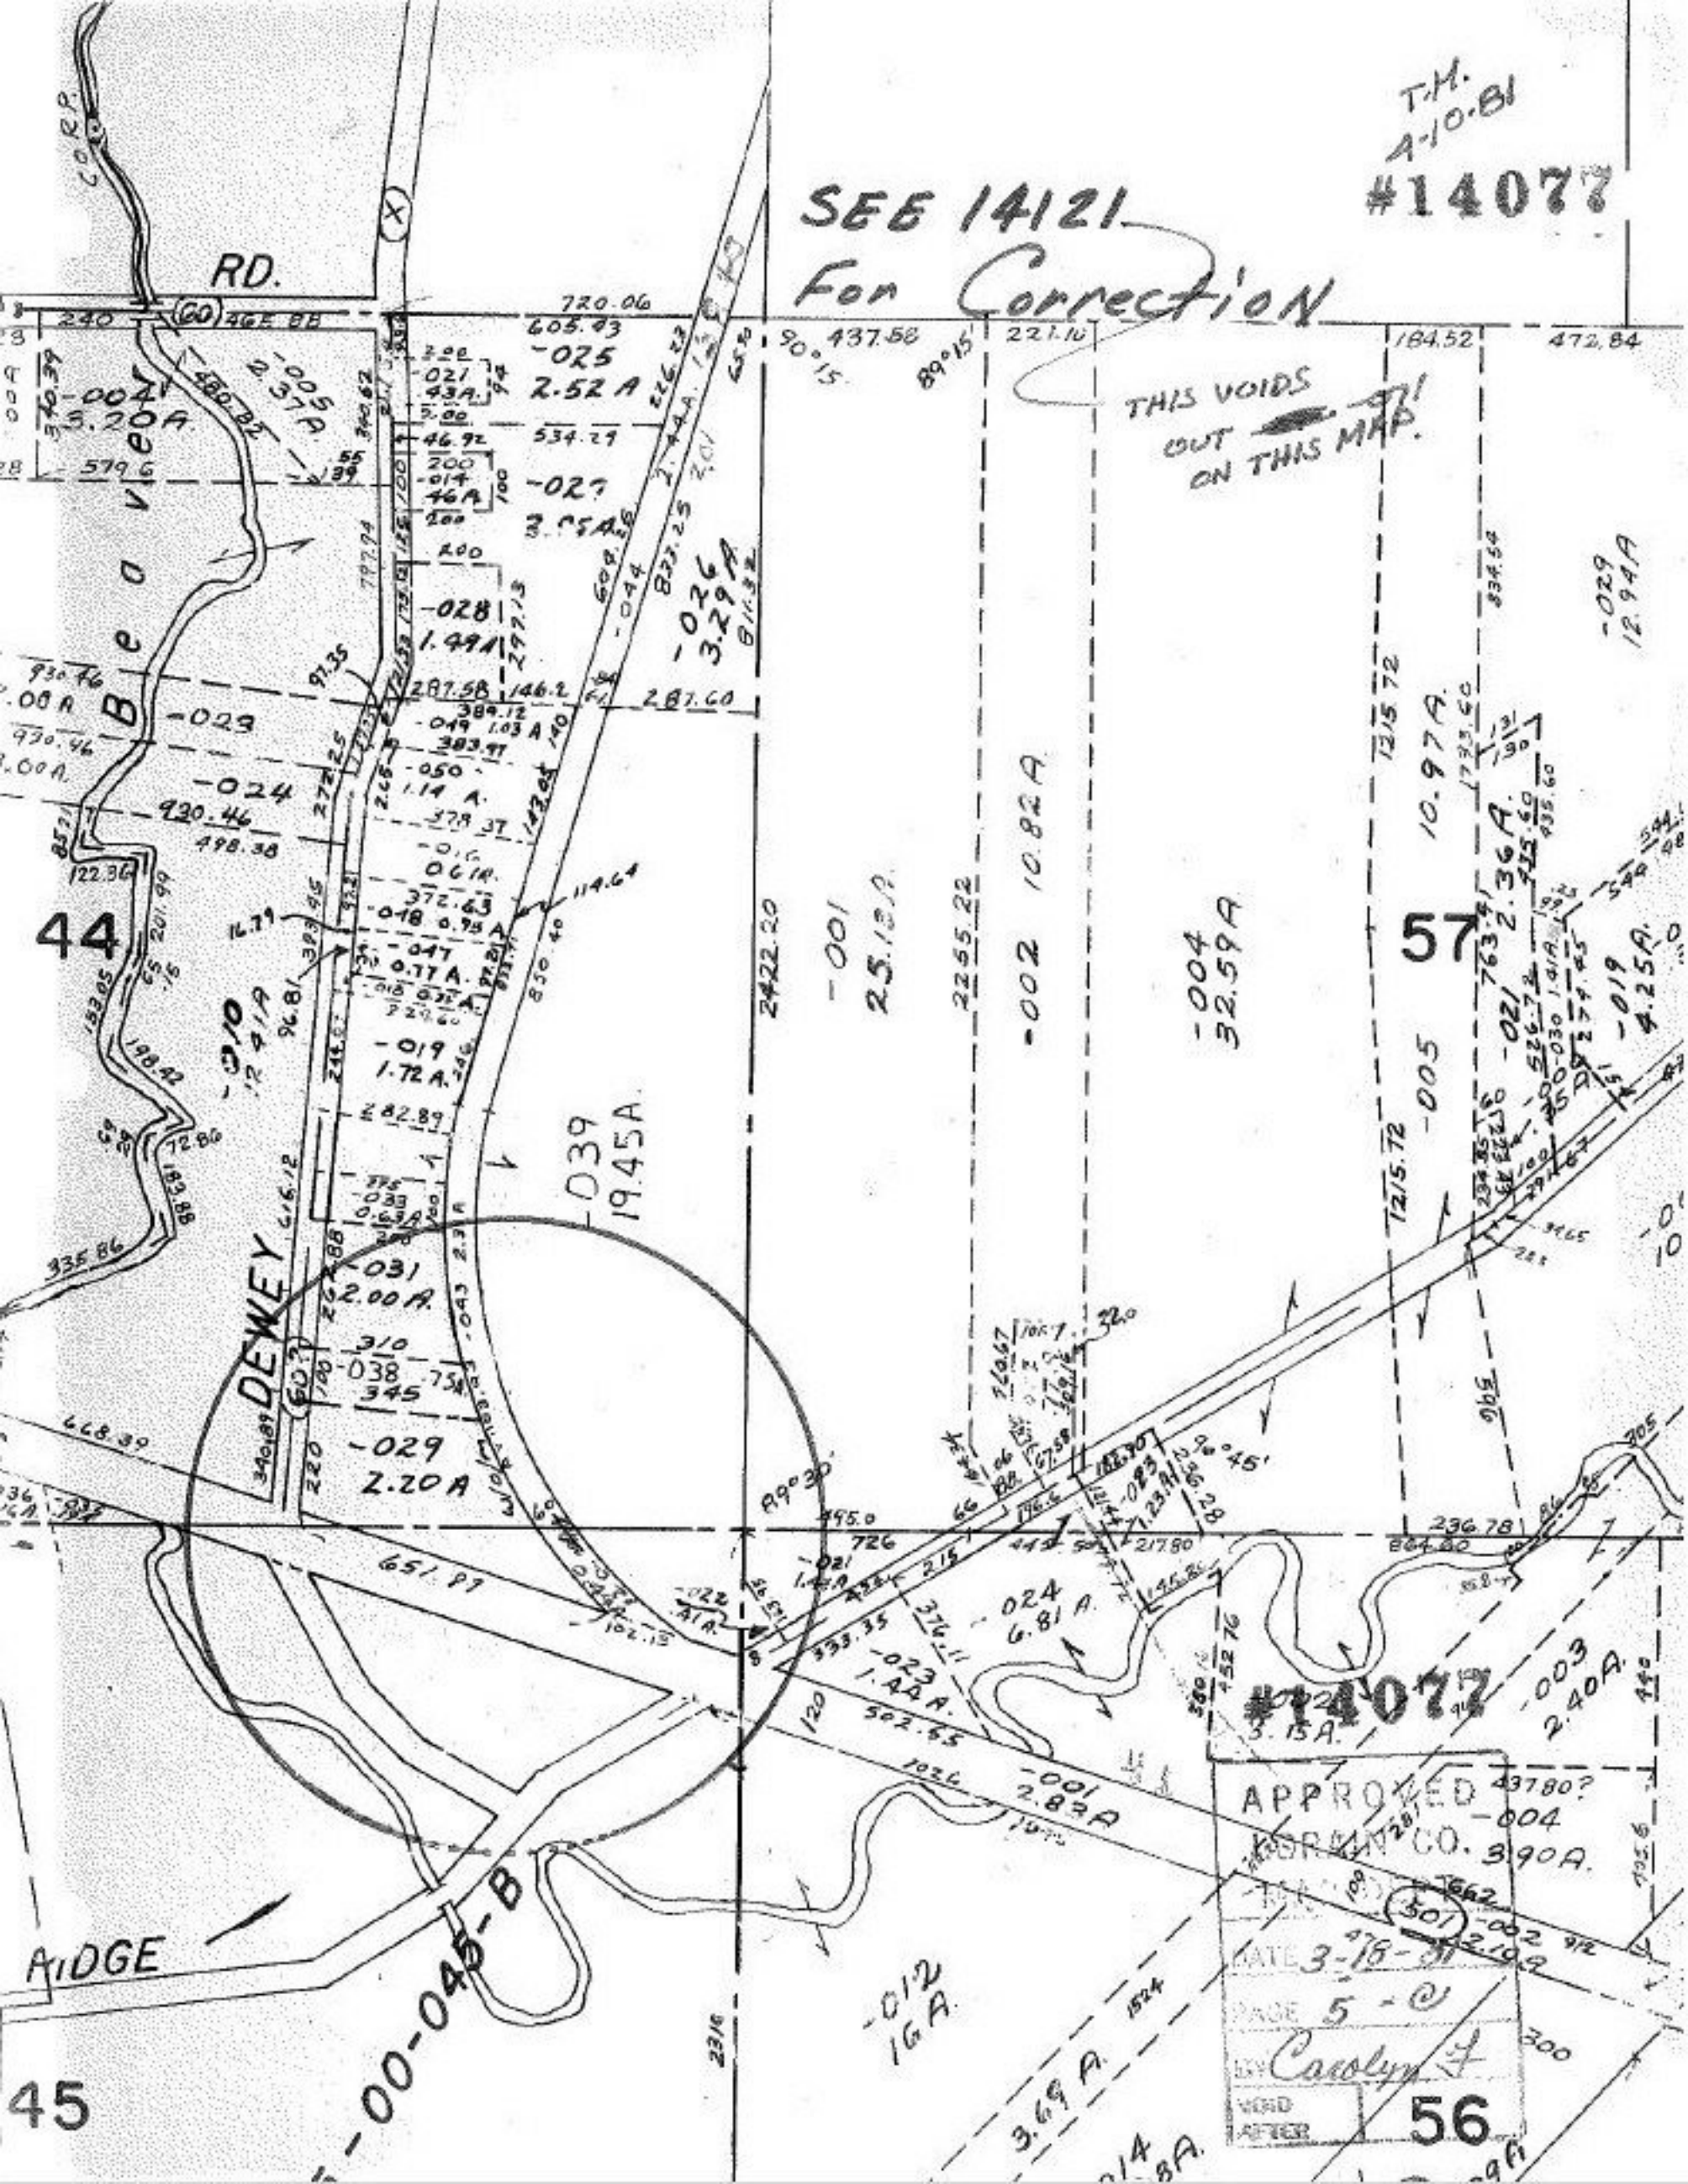

T.M.
4-10-81
#14077
SEE 14121
For Correction
THIS VOIDS OUT ON THIS MAP.
RD.
Beaver
DEWEY
RIDGE
44
45
57
56
#14077
APPROVED
LORAIN CO.
DATE 3-18-81
PAGE 5-C
BY Carolyn F
VOID AFTER