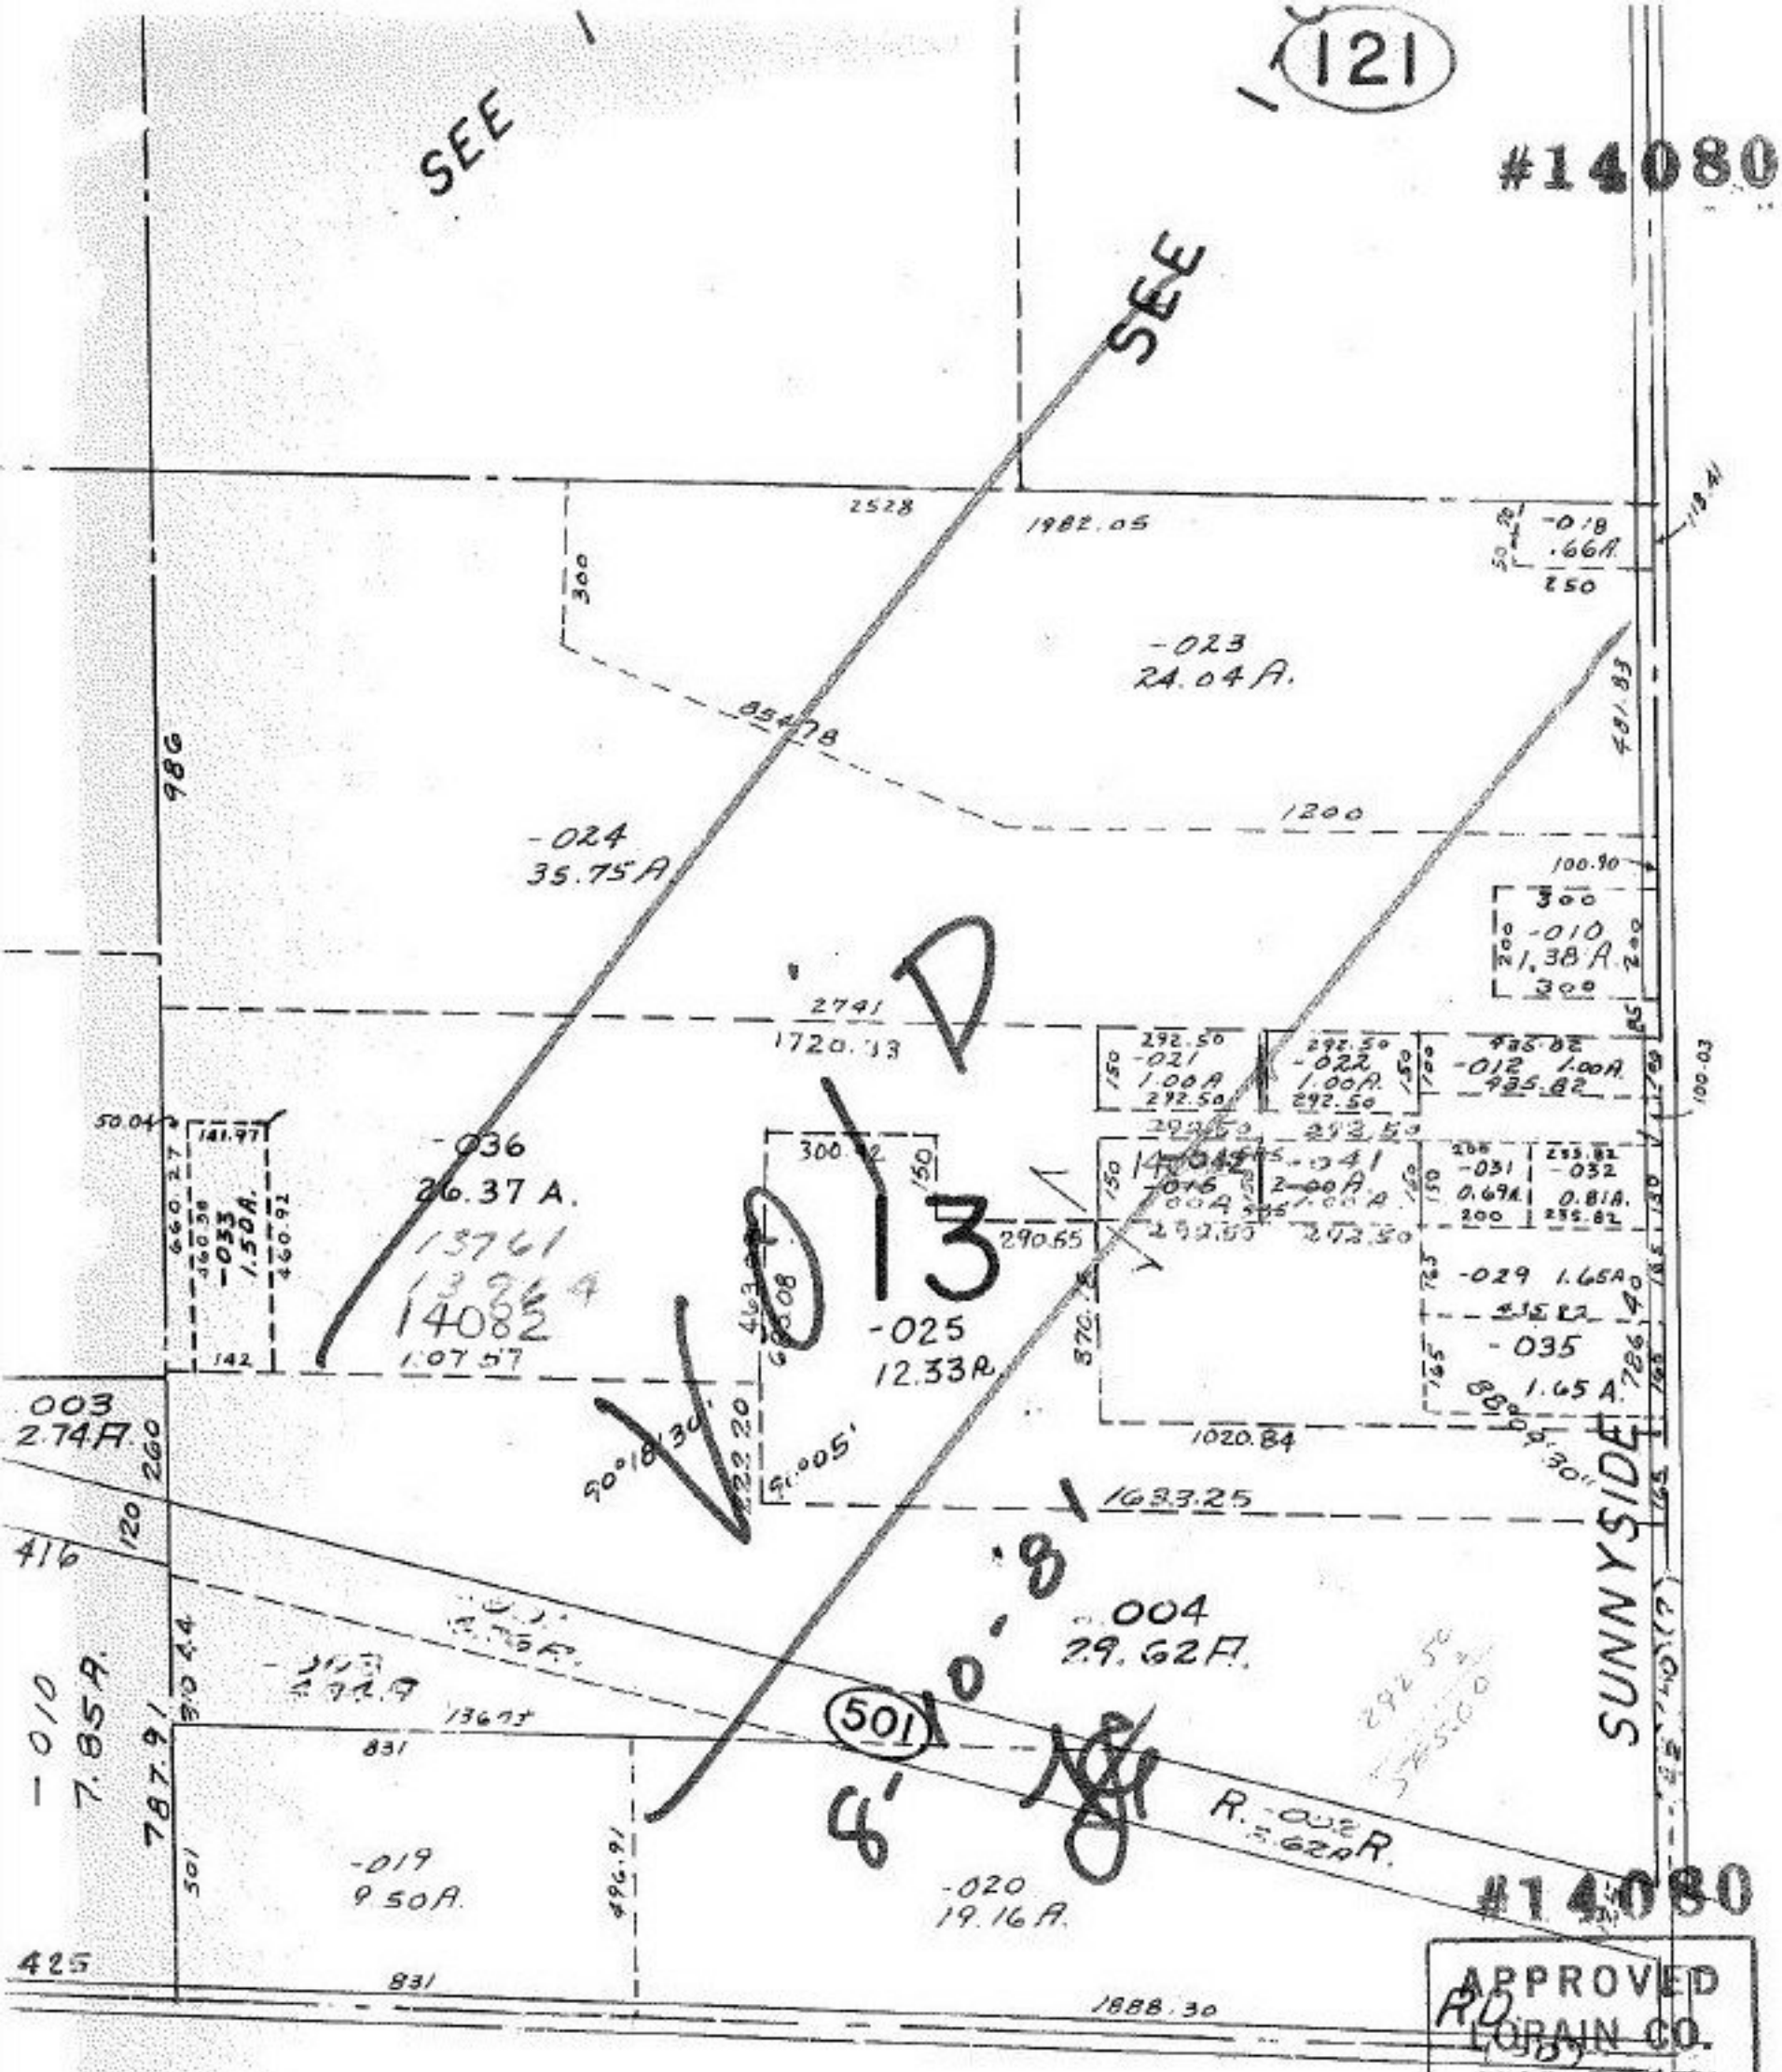
121
#14080
SEE
SEE
2528
1982.05
-018
.66A
250
300
-023
24.04 A.
854.78
481.83
986
1200
-024
35.75 A
100.90
300
-010
1.38 A
300
2741
1720.33
292.50
-021
1.00 A
292.50
292.50
-022
1.00 A
292.50
435.82
-012 1.00 A
435.82
100.03
50.04
141.97
-036
26.37 A.
13761
13964
14082
1.07 57
300.92
-013
-025
12.33 A.
290.65
-031
0.69 A
-032
0.81 A.
-029 1.65 A
-035
1.65 A.
-033
1.50 A.
660.27
460.92
142
.003
2.74 A
260
120
416
1020.84
1633.25
SUNNYSIDE
.004
29.62 A.
501
-010
7.85 A.
787.91
831
-019
9.50 A.
496.91
-020
19.16 A.
425
831
1888.30
#14080
APPROVED
LORAIN CO.
MAP DEPT.
DATE 3-11-81
PAGE 1-B
BY Carolyn F
VOID AFTER 14080