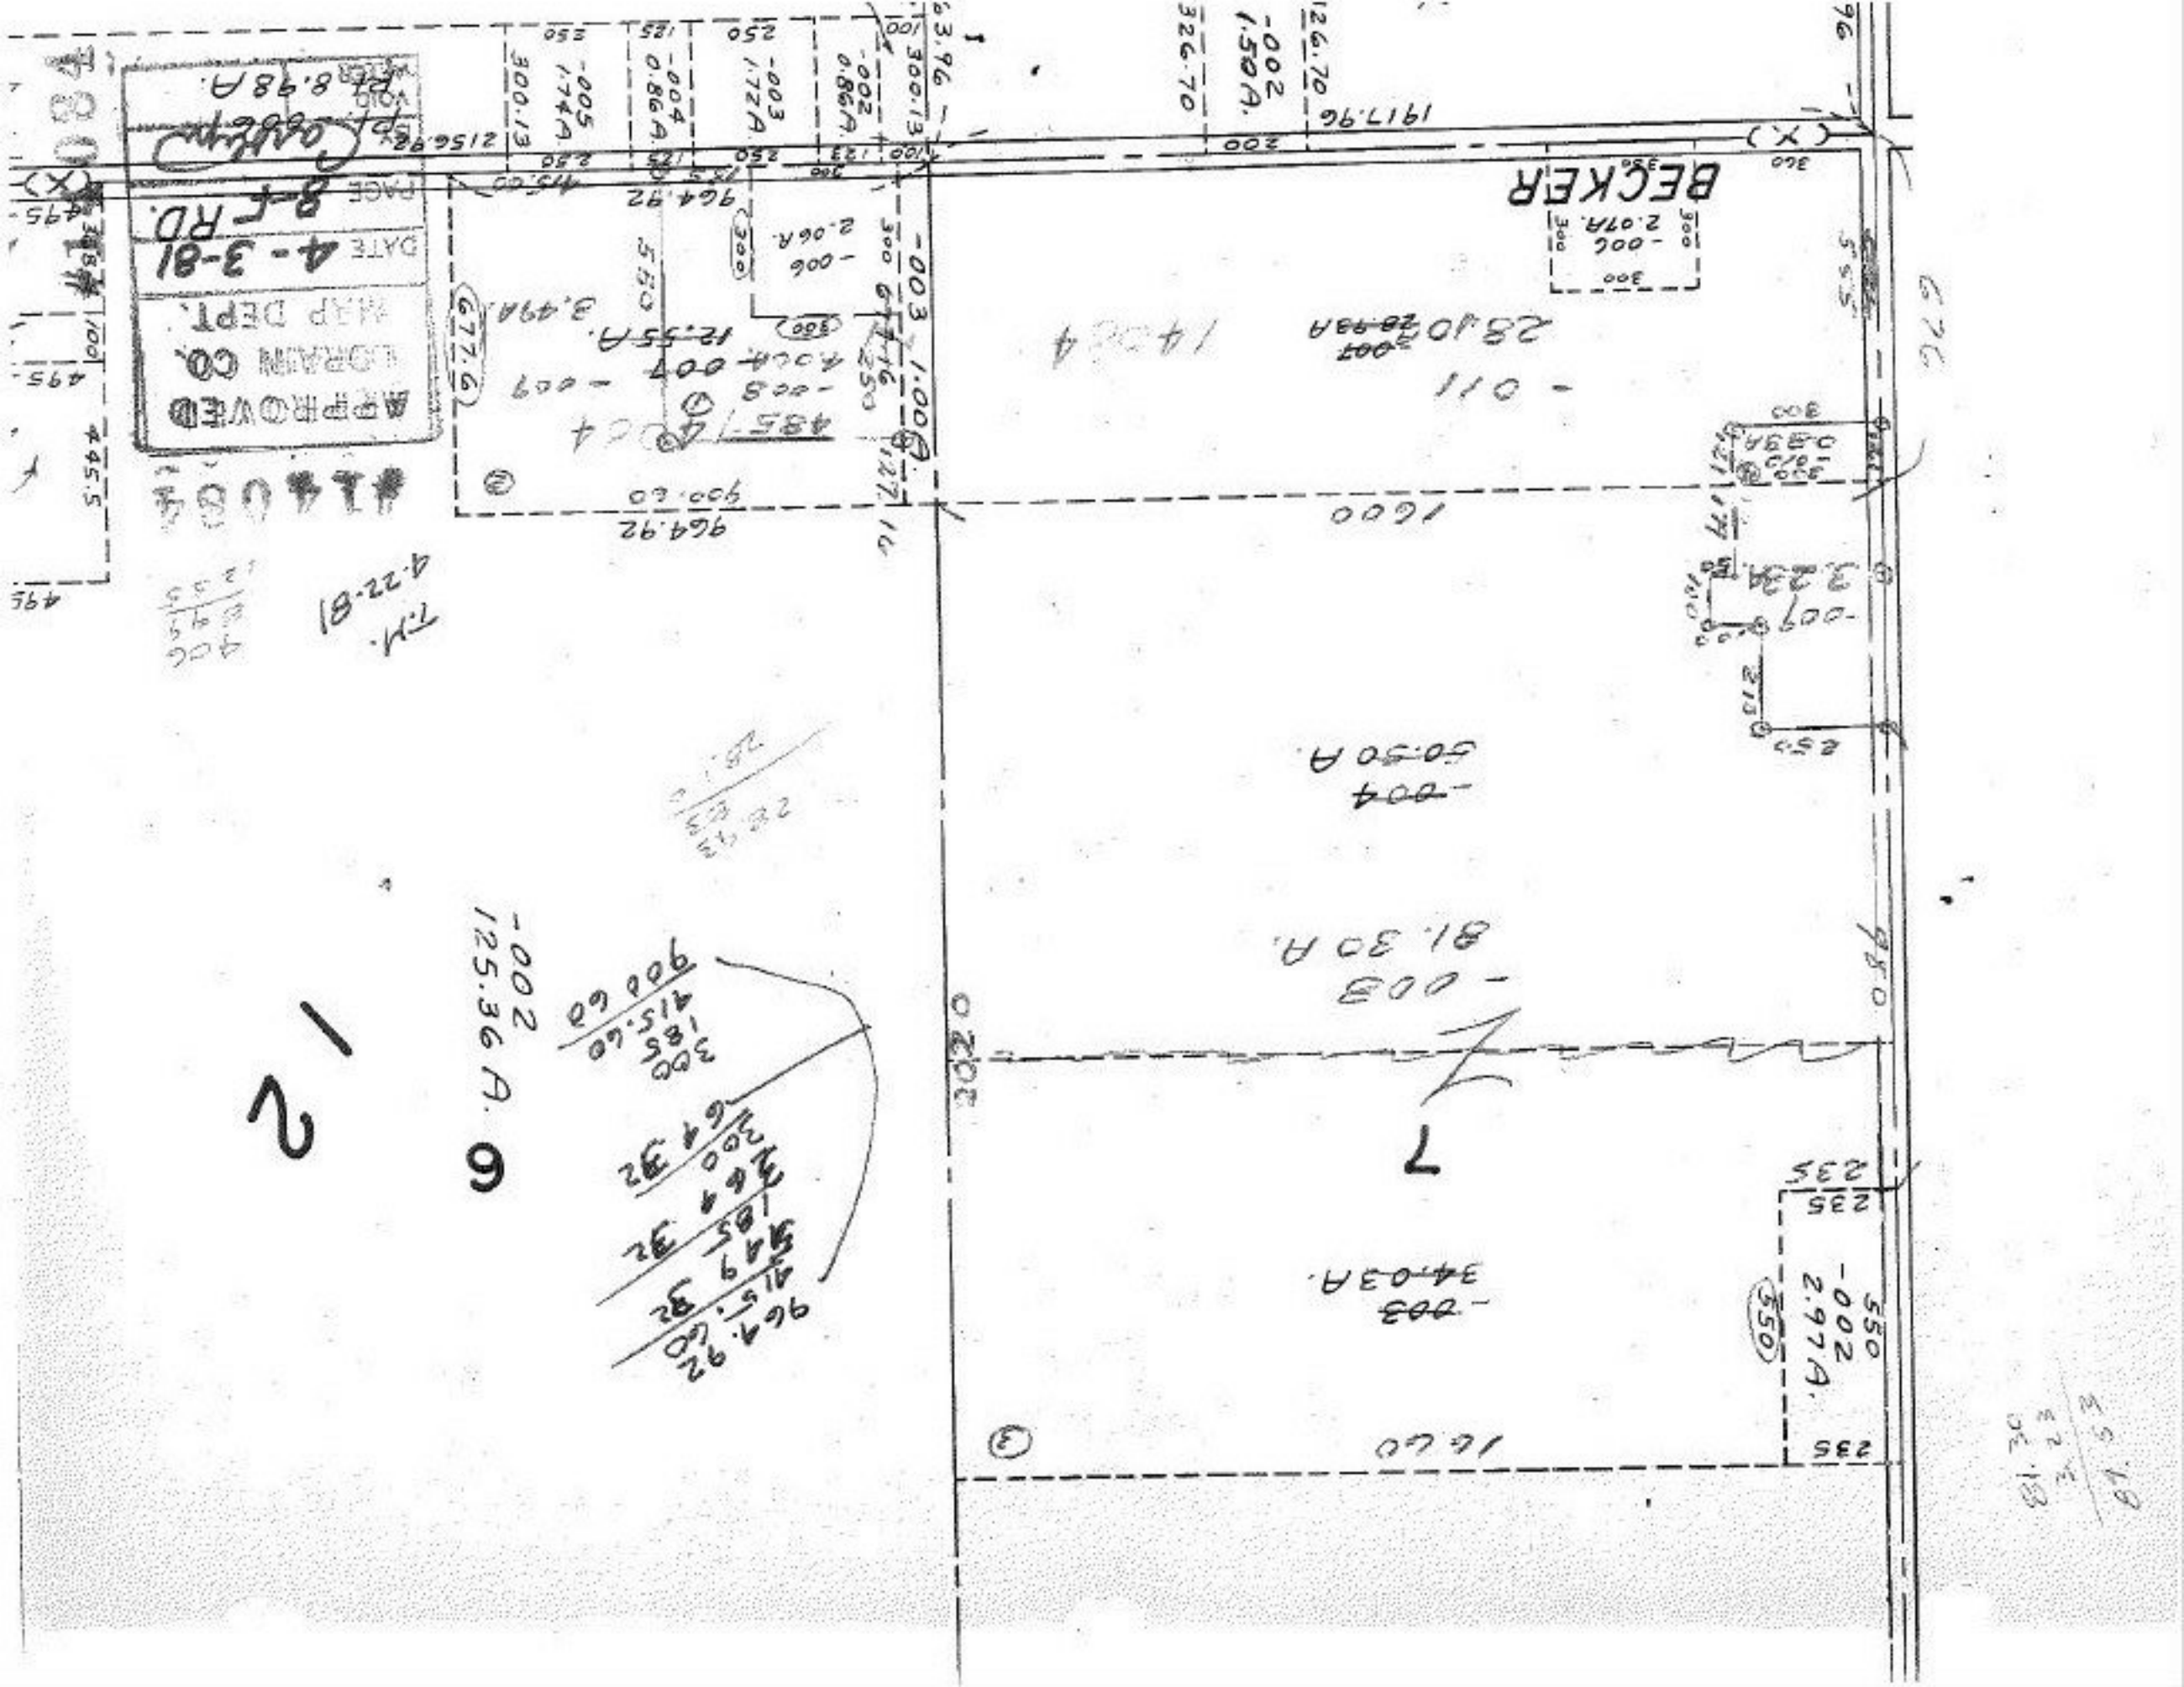

BECKER
APPROVED
LORAIN CO.
MAP DEPT.
DATE 4-3-81
PAGE 8-F RD.
VOID
METER
Pt. 8.98A.
Cabin
14084
T.M.
4-22-81
-002
125.36 A.
964.92
900.60
12.55A.
3.49A.
-006
2.06A.
-003
1.00A.
-004
50.50 A.
-003
81.30 A.
-003
34.03A.
-002
2.97A.
550
235
1600
1917.96
2156.92