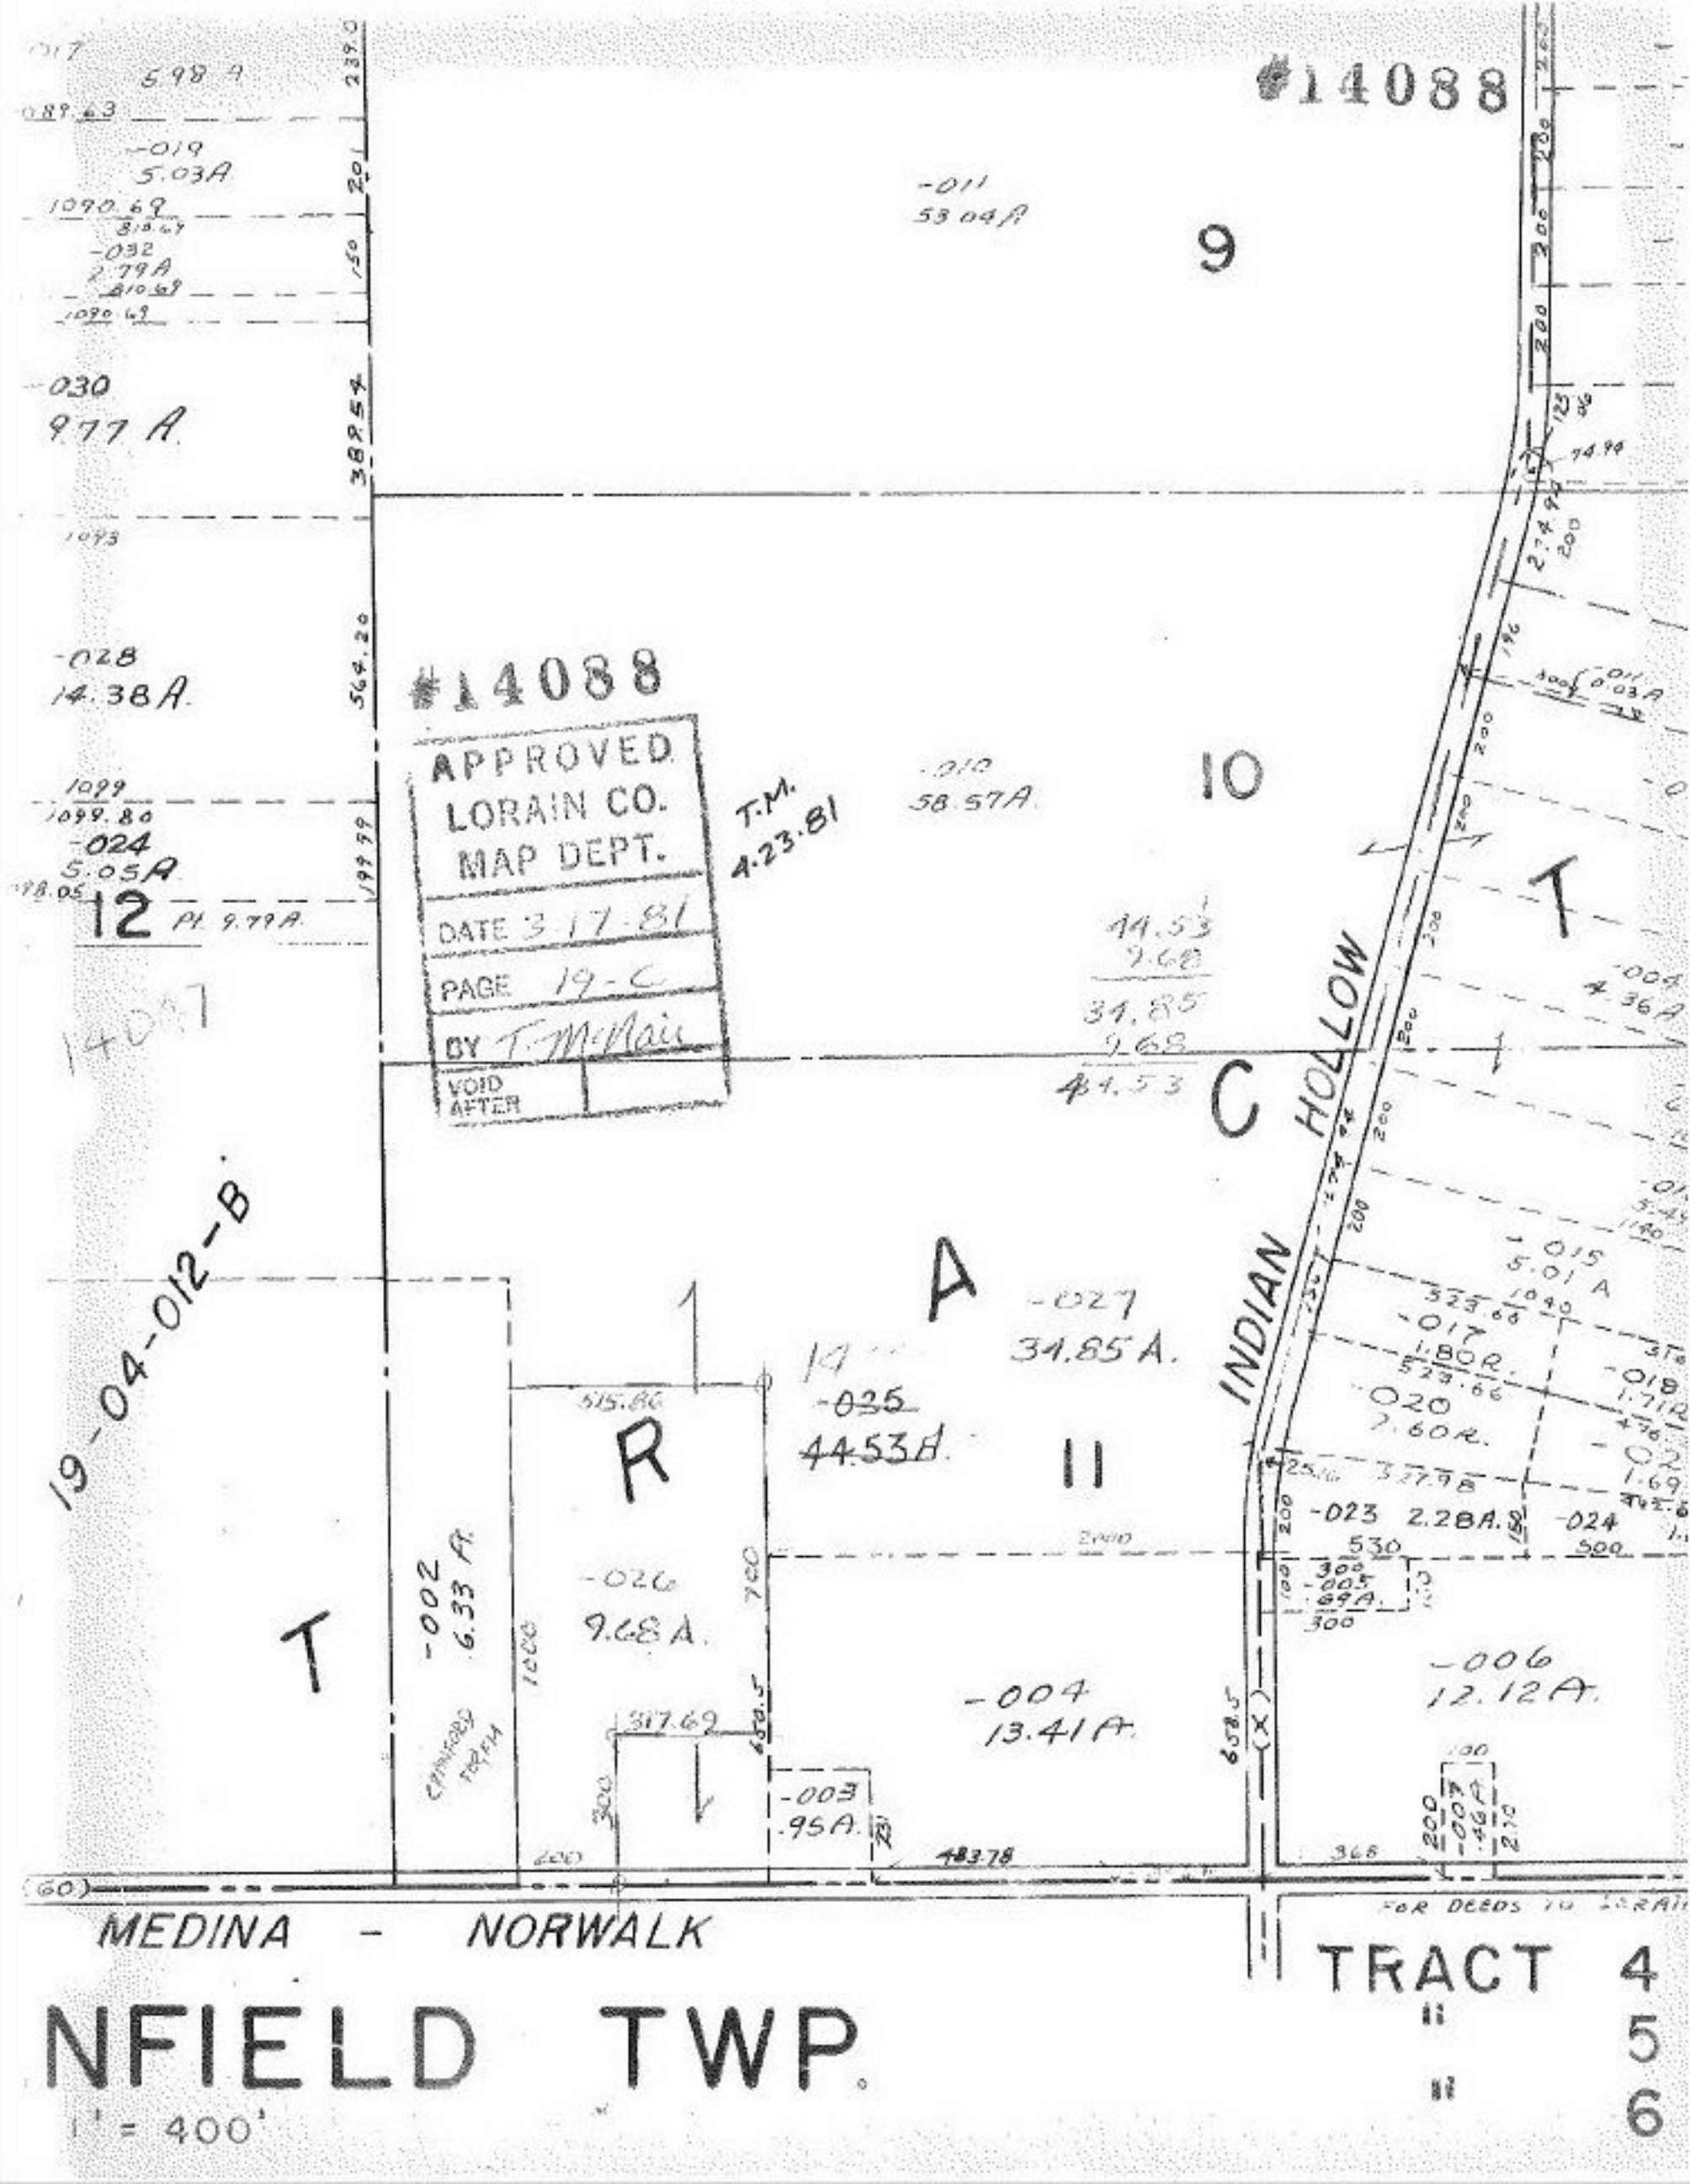
#14088
9
10
11
12
T
R
A
C
T
INDIAN HOLLOW
MEDINA - NORWALK
19-04-012-B
APPROVED
LORAIN CO.
MAP DEPT.
DATE 3-17-81
PAGE 19-C
BY T. McNair
VOID AFTER
T.M. 4.23.81
-011 53.04A
-010 58.57A
-027 34.85A.
-026 9.68A.
-004 13.41A.
-006 12.12A.
-002 6.33A.
-003 .95A.
-023 2.28A.
-024
-030 9.77A.
-028 14.38A.
-024 5.05A
-019 5.03A
-032 2.79A
-015 5.01A
-017 1.80R.
-020 2.60R.
44.53
9.68
34.85
9.68
44.53
FOR DEEDS TO LORAIN
TRACT 4
" 5
" 6
NFIELD TWP.
1" = 400'