

#14089

#14089


APPROVED
LORAIN CO.
MAP DEPT.
DATE 3-17-81
PAGE 3-00-033-A
BY T. McNeil
VOID AFTER

T.M.
4.23.81

6/2

SEE 3-00-033-A

124.86	153.03
83.86	116.03
43.00	43

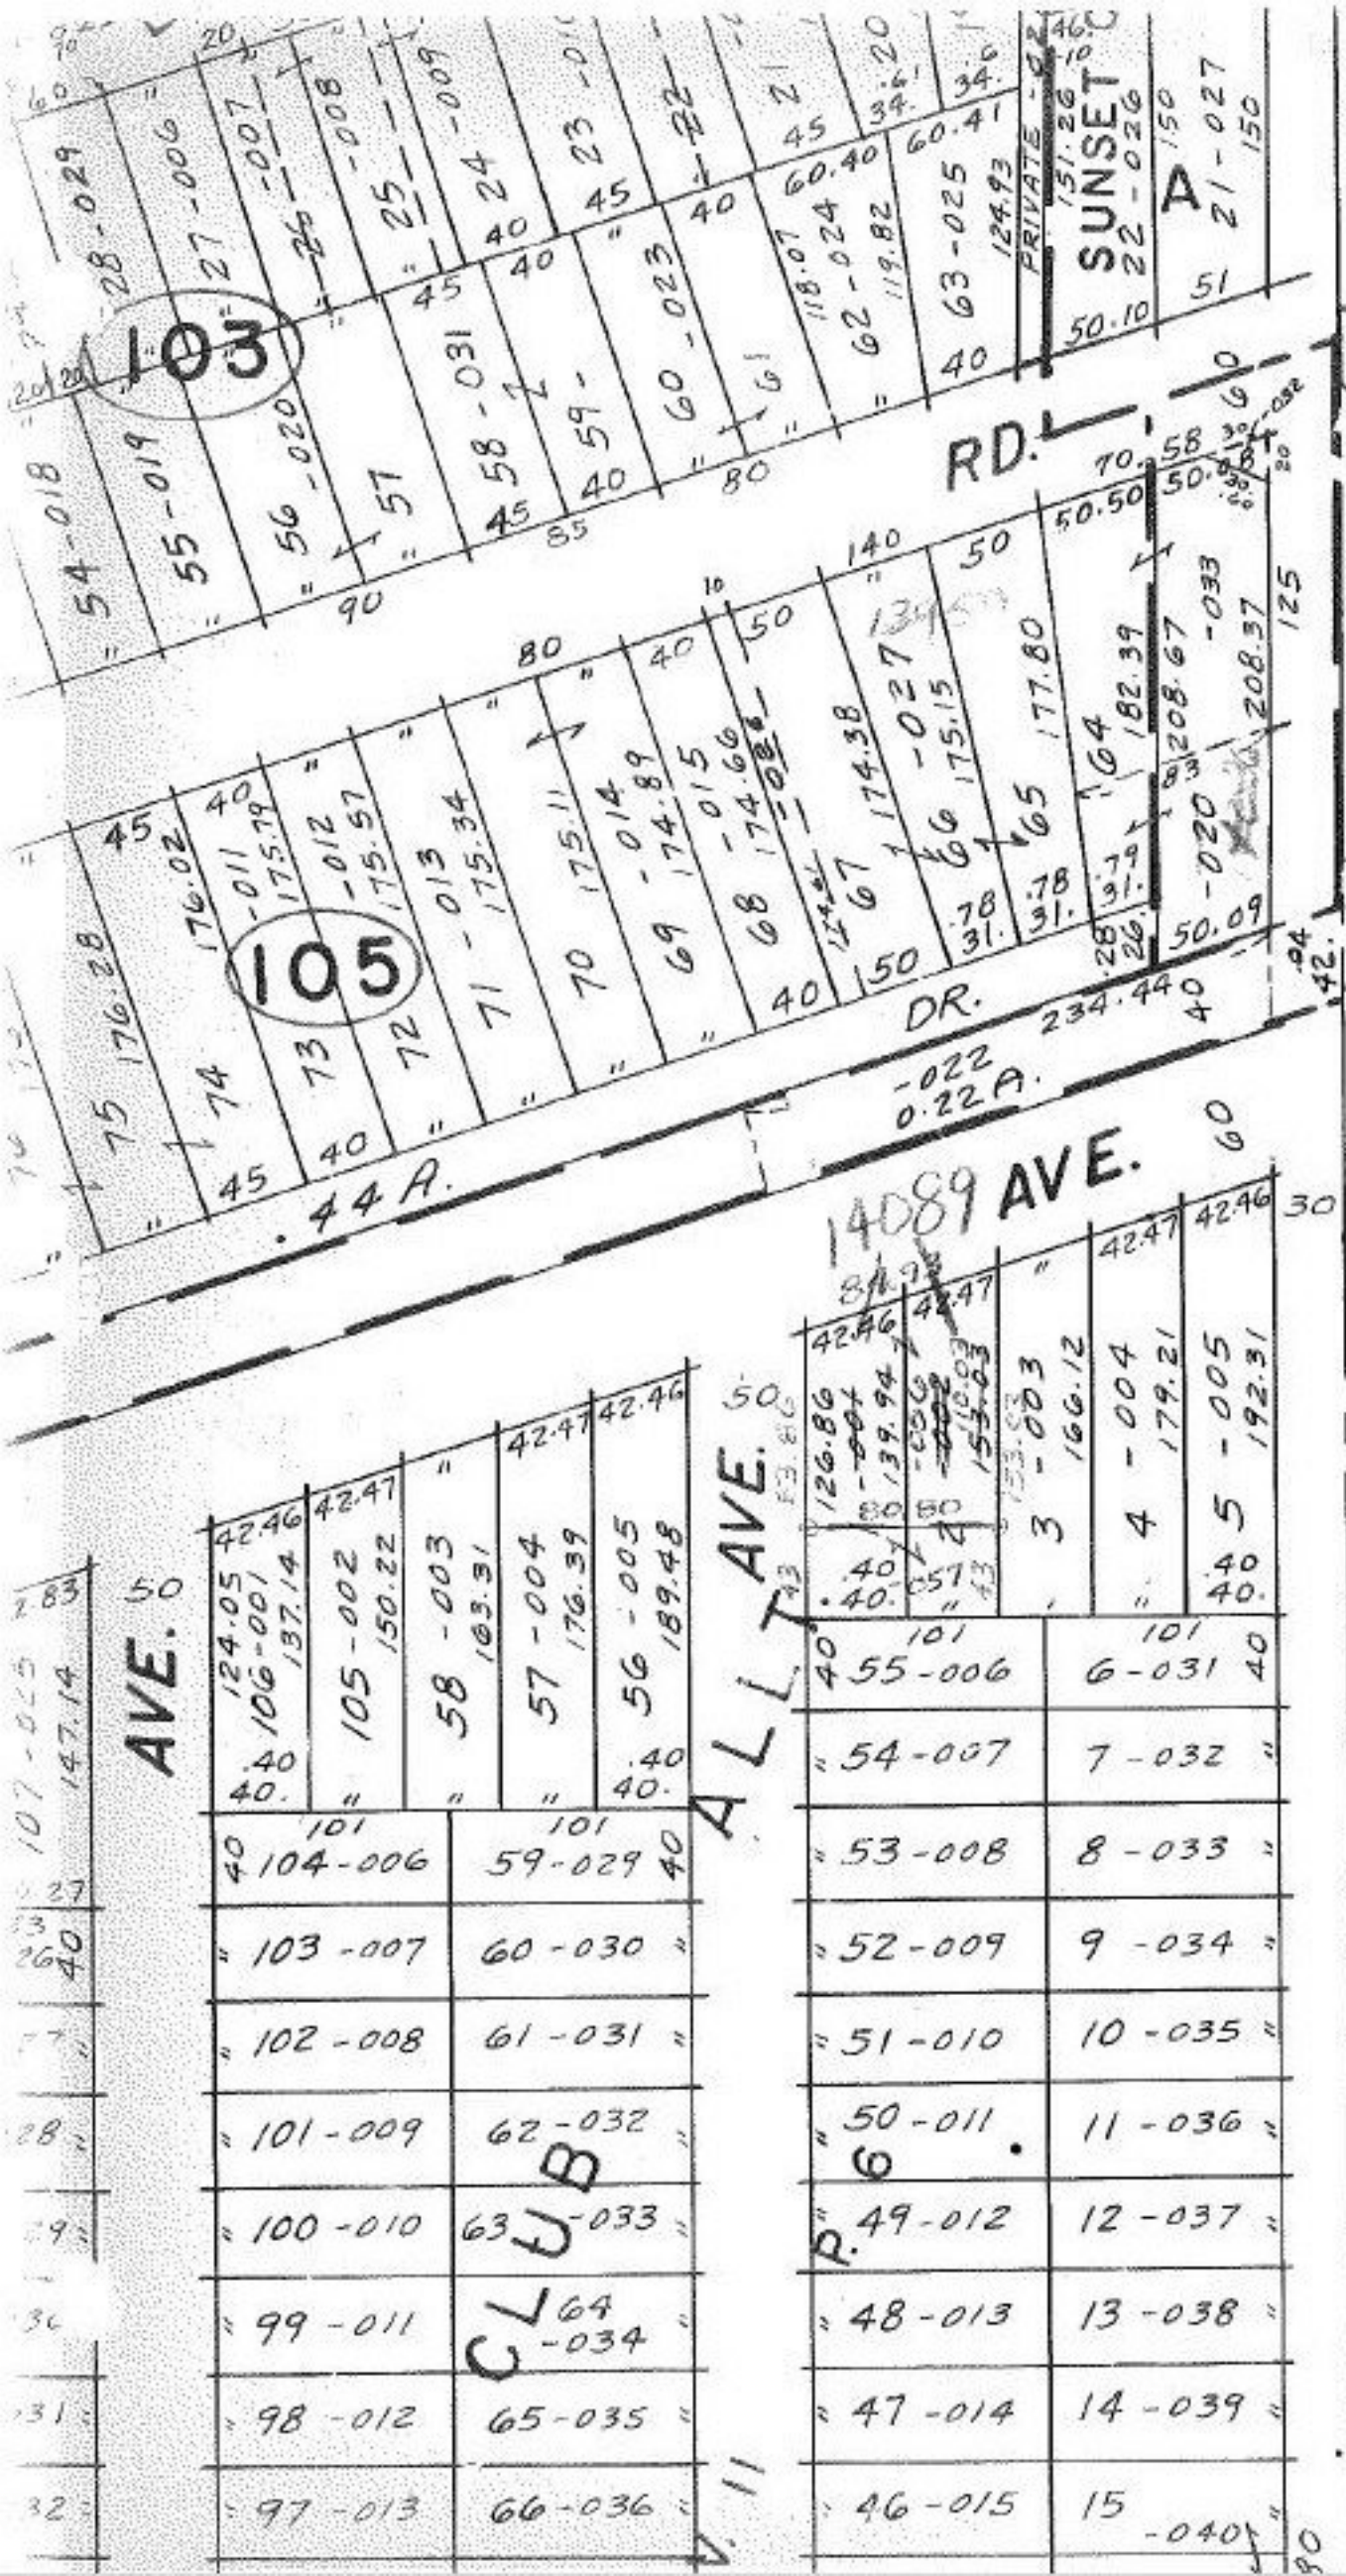

107-025	124.05	42.46
147.14	106-001	137.14
AVE. 50	105-002	150.22
	58-003	163.31
	57-004	176.39
	56-005	189.48

104-006	59-029
103-007	60-030
102-008	61-031
101-009	62-032
100-010	63-033
99-011	64-034
98-012	65-035
97-013	66-036
55-006	6-031
54-007	7-032
53-008	8-033
52-009	9-034
51-010	10-035
50-011	11-036
49-012	12-037
48-013	13-038
47-014	14-039
46-015	15-040

126.86	42.46
139.94	42.47

176.02	175.79
175.57	175.34
175.11	174.89
174.66	174.44
