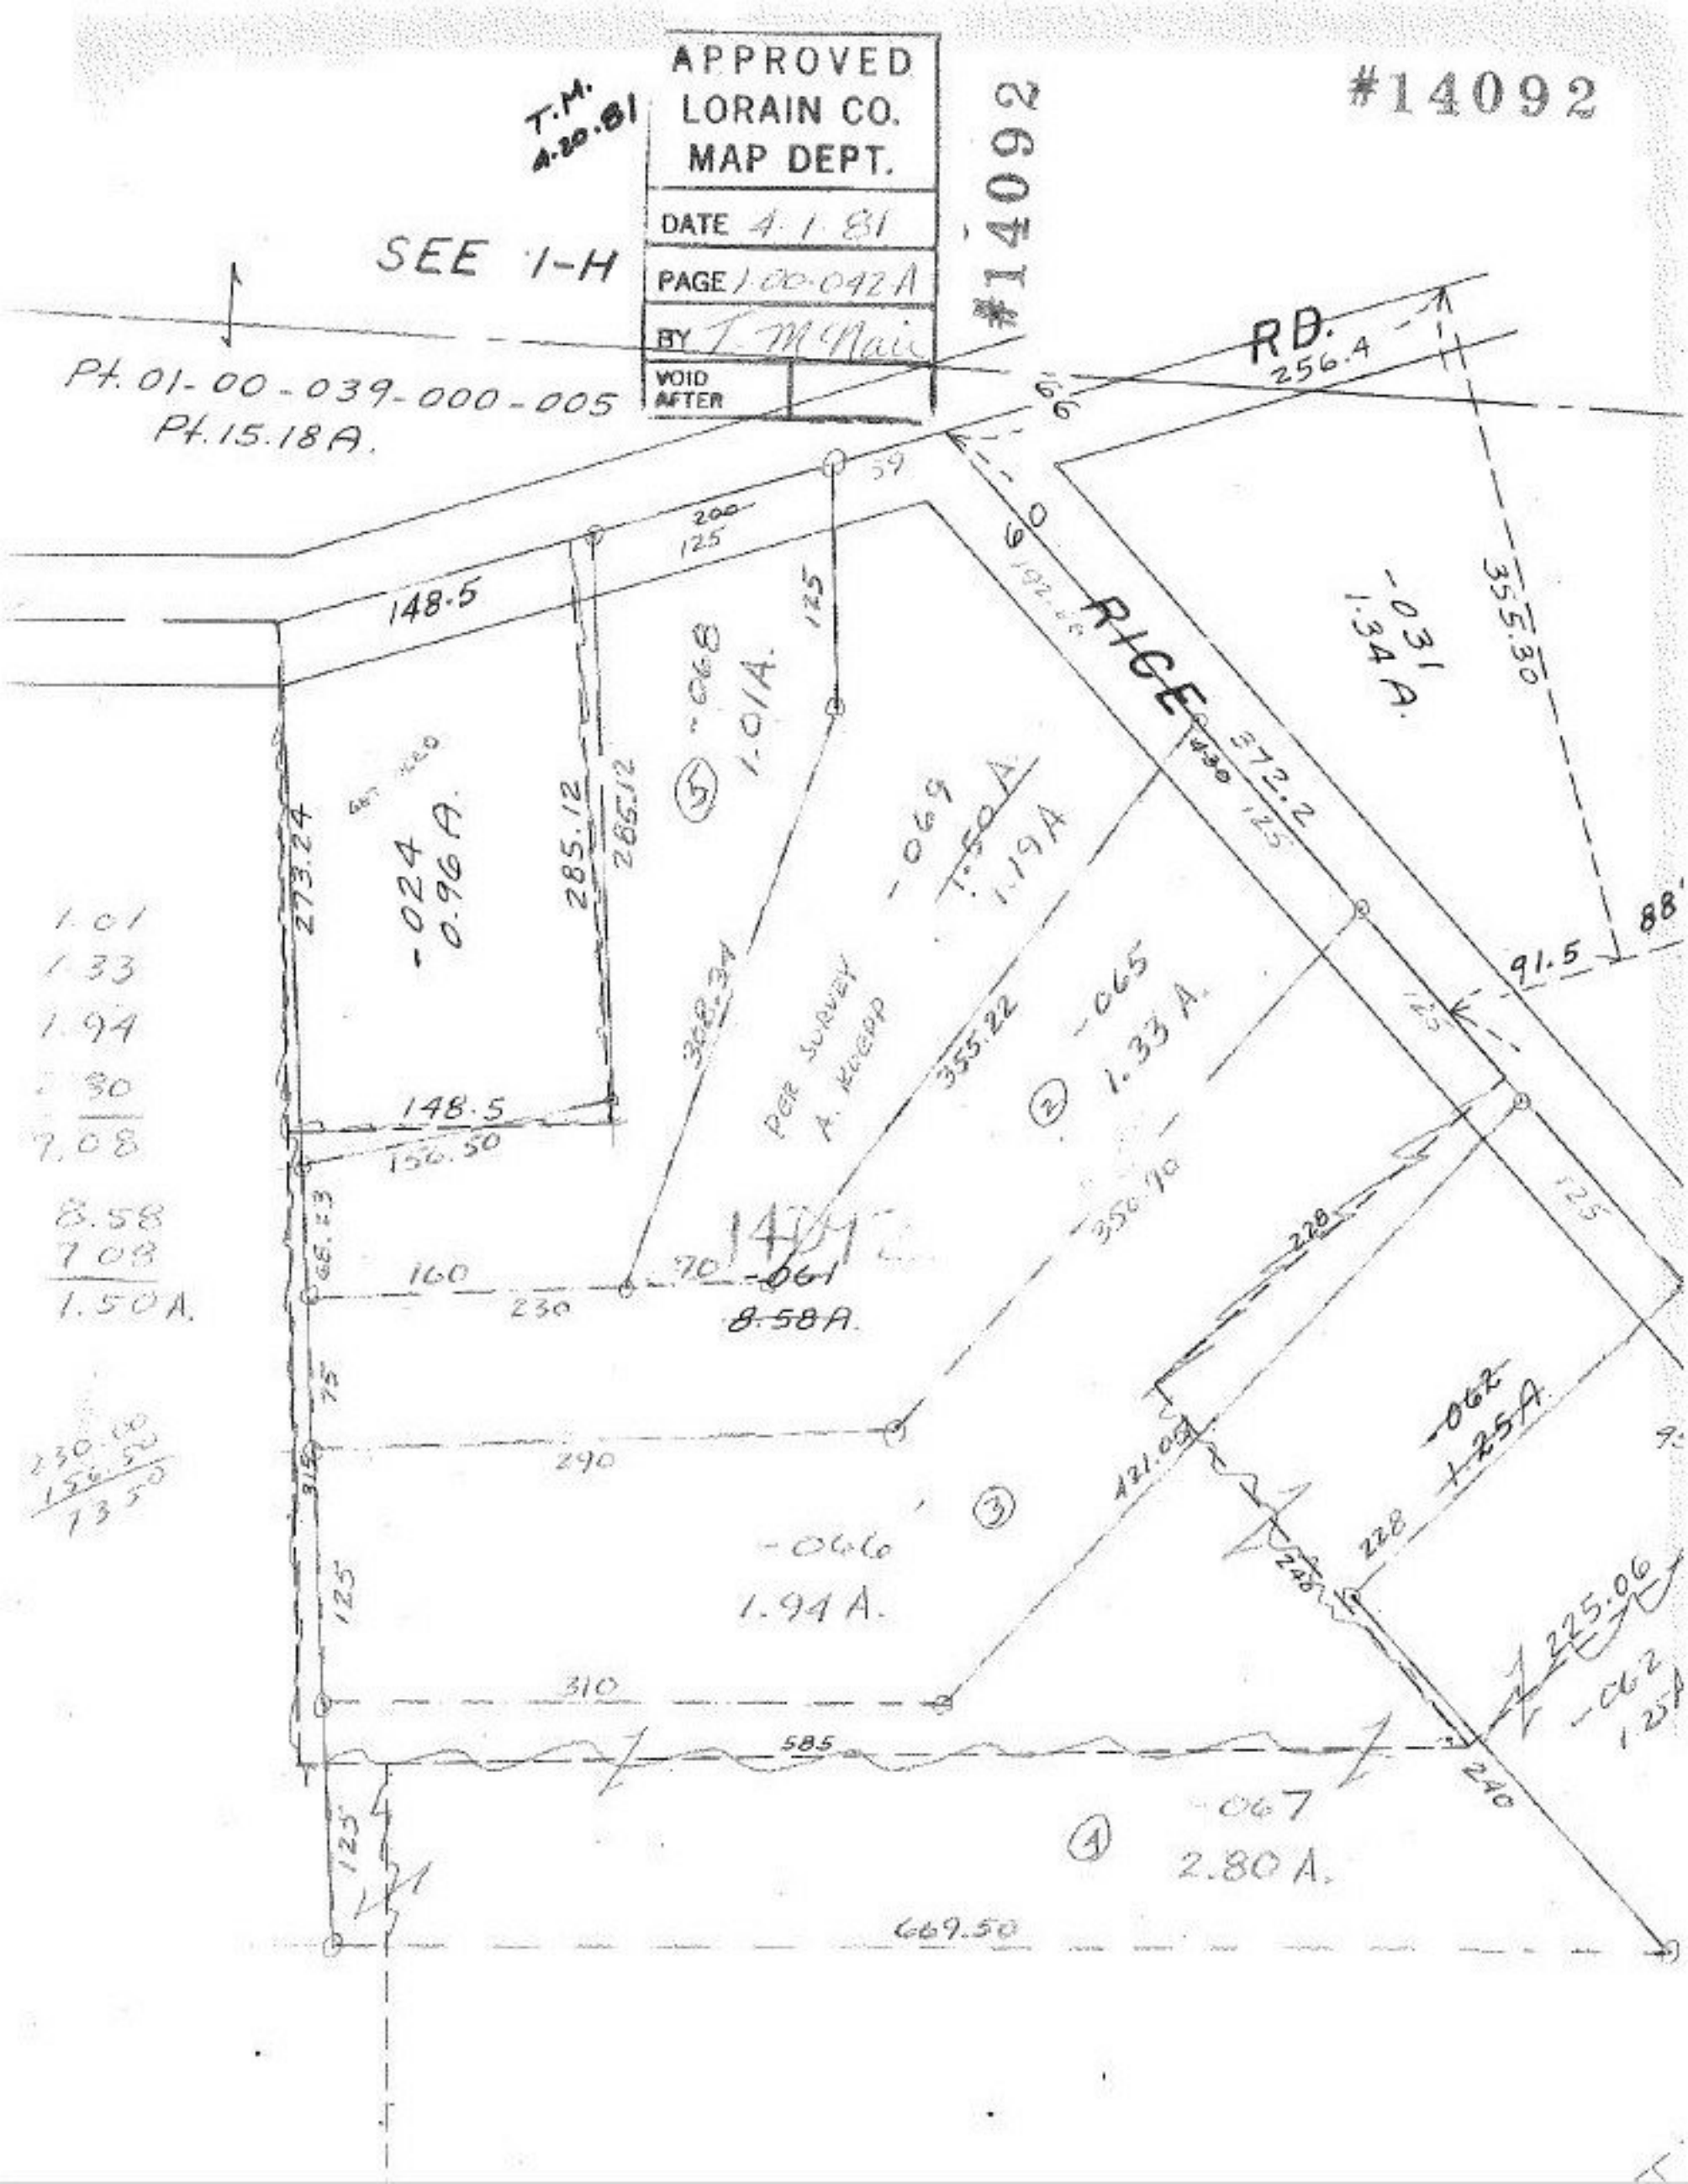

#14092
APPROVED
LORAIN CO.
MAP DEPT.
DATE 4.1.81
PAGE 1.00.042A
BY T. McNair
VOID AFTER
T.M. 4.20.81
#14092
SEE 1-H
Pt. 01-00-039-000-005
Pt. 15.18A.
RD.
256.4
RICE
148.5
-068
1.01A.
-031
1.34A.
355.30
372.2
-024
0.96A.
273.24
285.12
285.12
-069
1.50A.
1.19A
308.34
PER SURVEY
A. KOEPP
355.22
-065
1.33A.
91.5
148.5
156.50
160
230
-061
8.58A.
350.70
228
-062
1.25A.
290
-066
1.94A.
431.05
228
225.06
-062
1.25A
310
585
-067
2.80A.
669.50
1.01
1.33
1.94
2.80
7.08
8.58
7.08
1.50A.
230.00
156.50
73.50