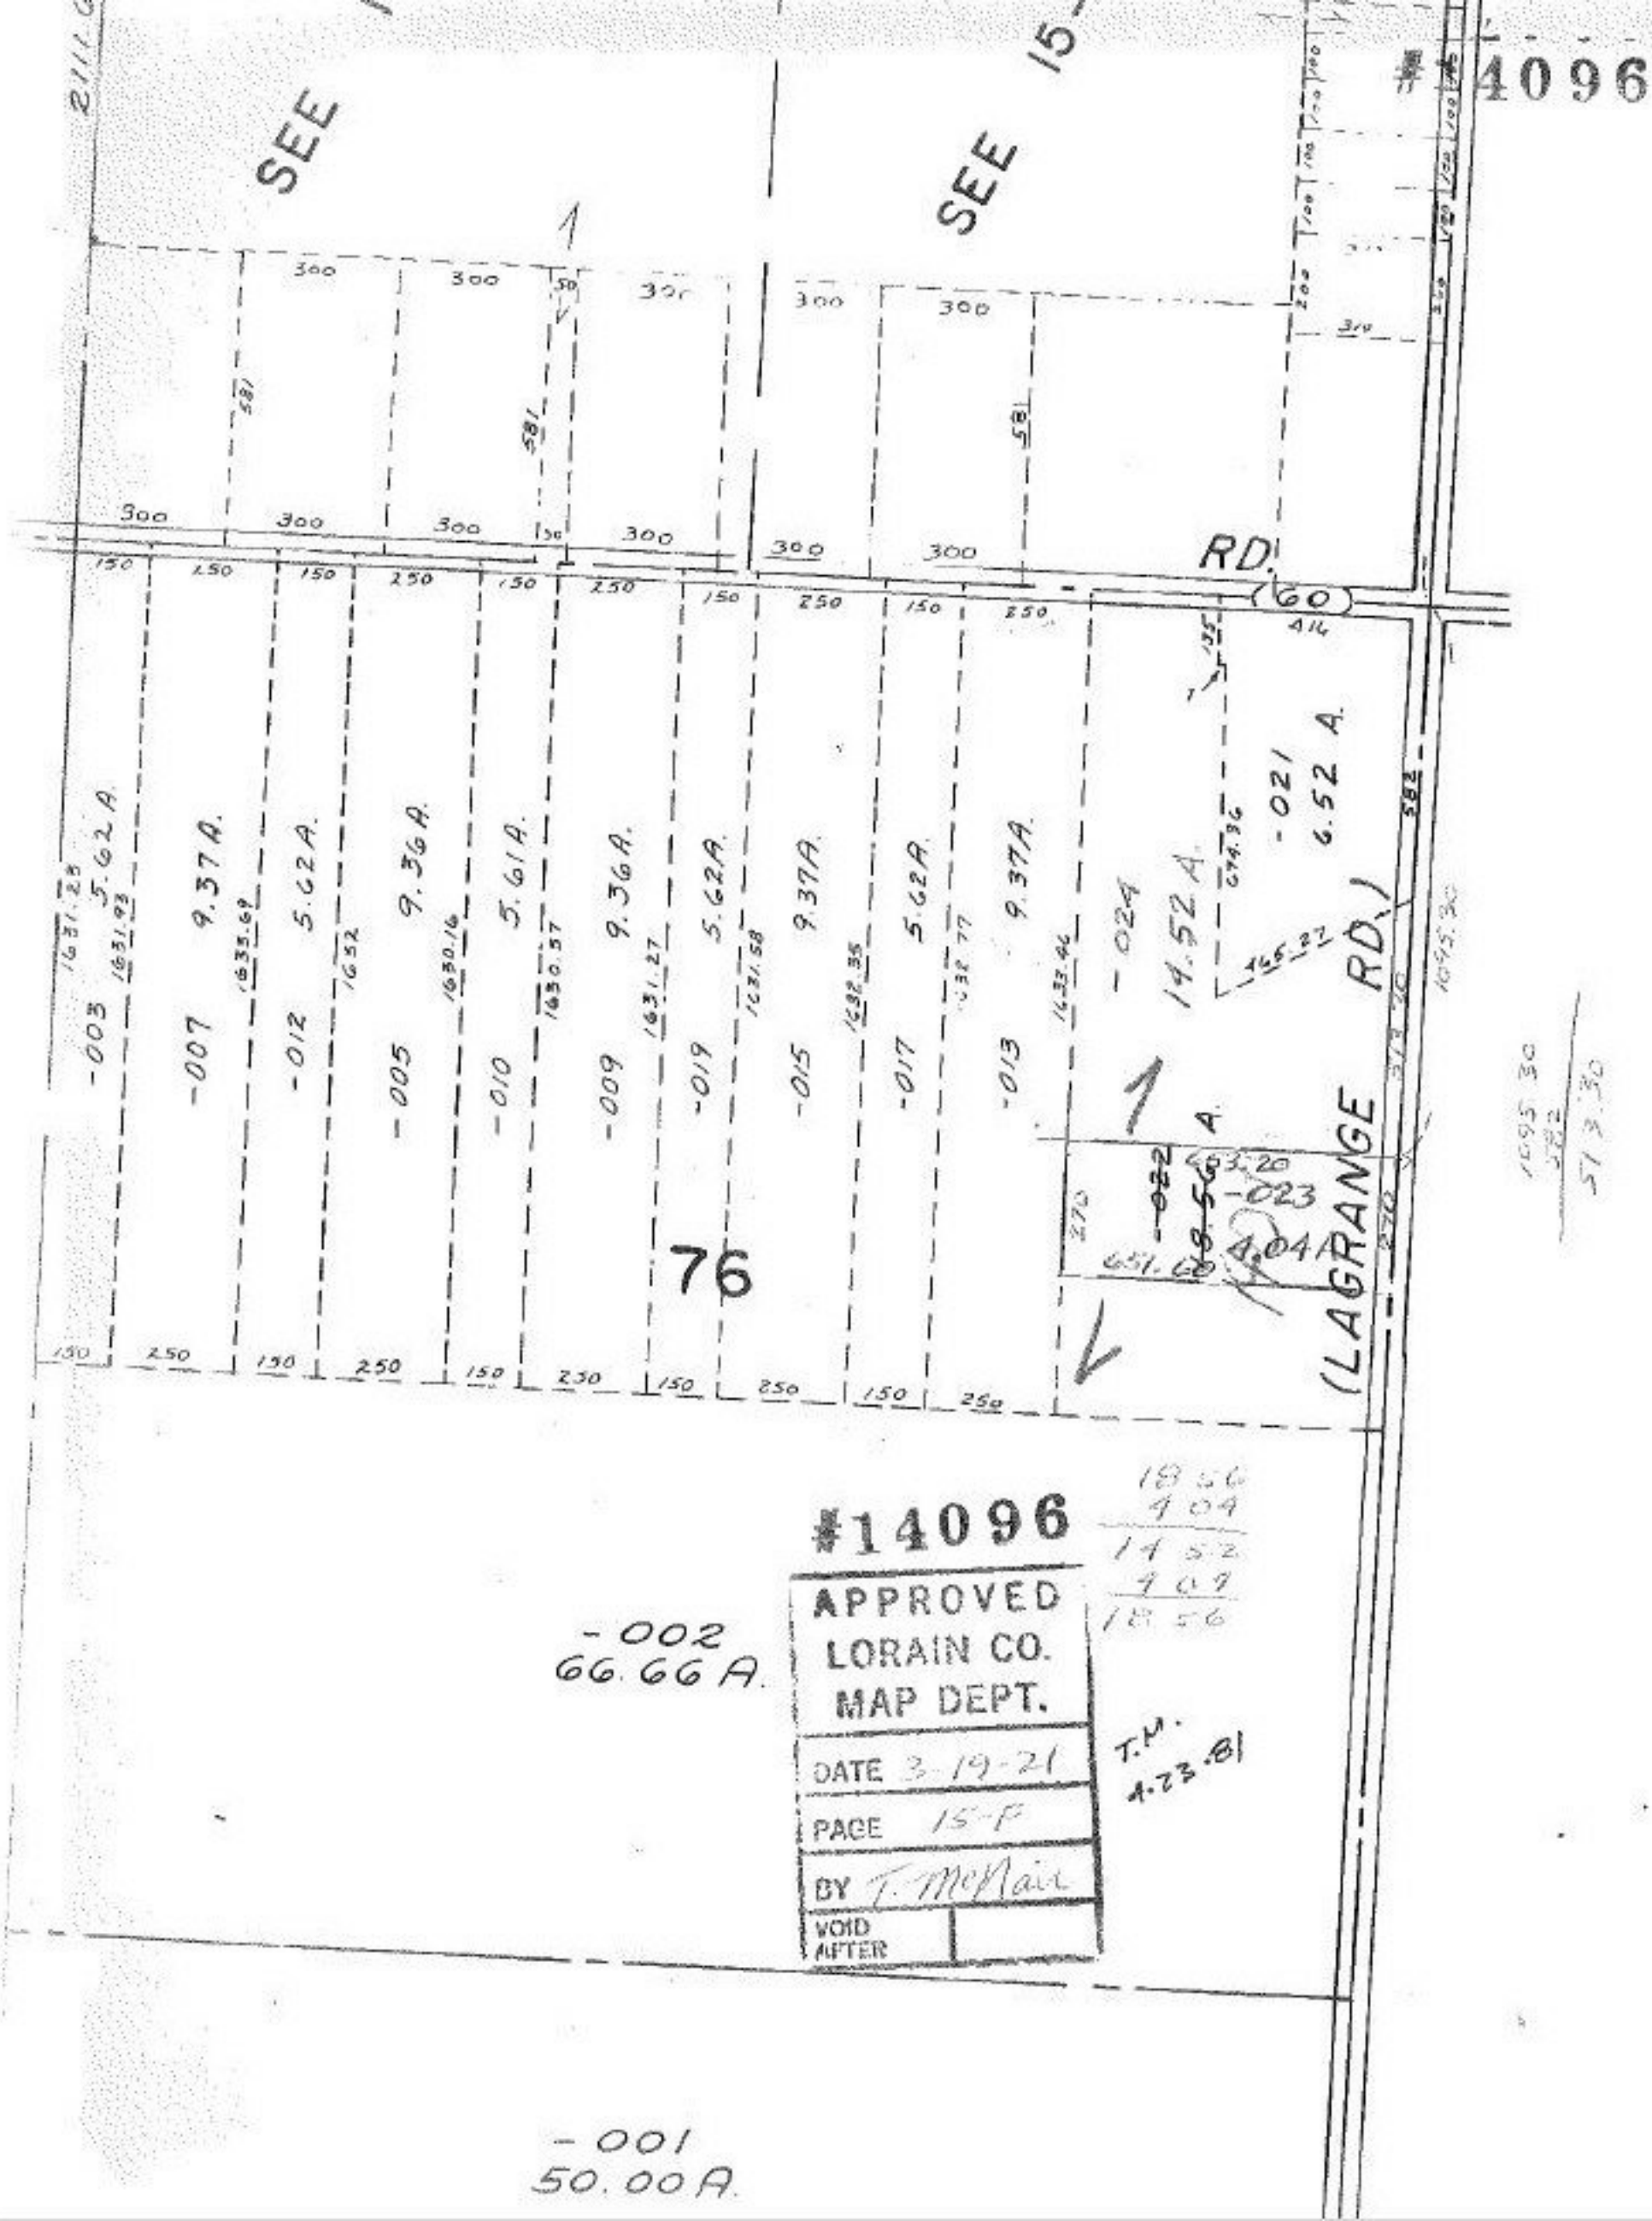

#14096

APPROVED
LORAIN CO.
MAP DEPT.
DATE 3-19-21
PAGE 15-F
BY T. McNair
VOID AFTER

18.56
4.04
14.52
4.04
18.56

T.M.
4.23.81