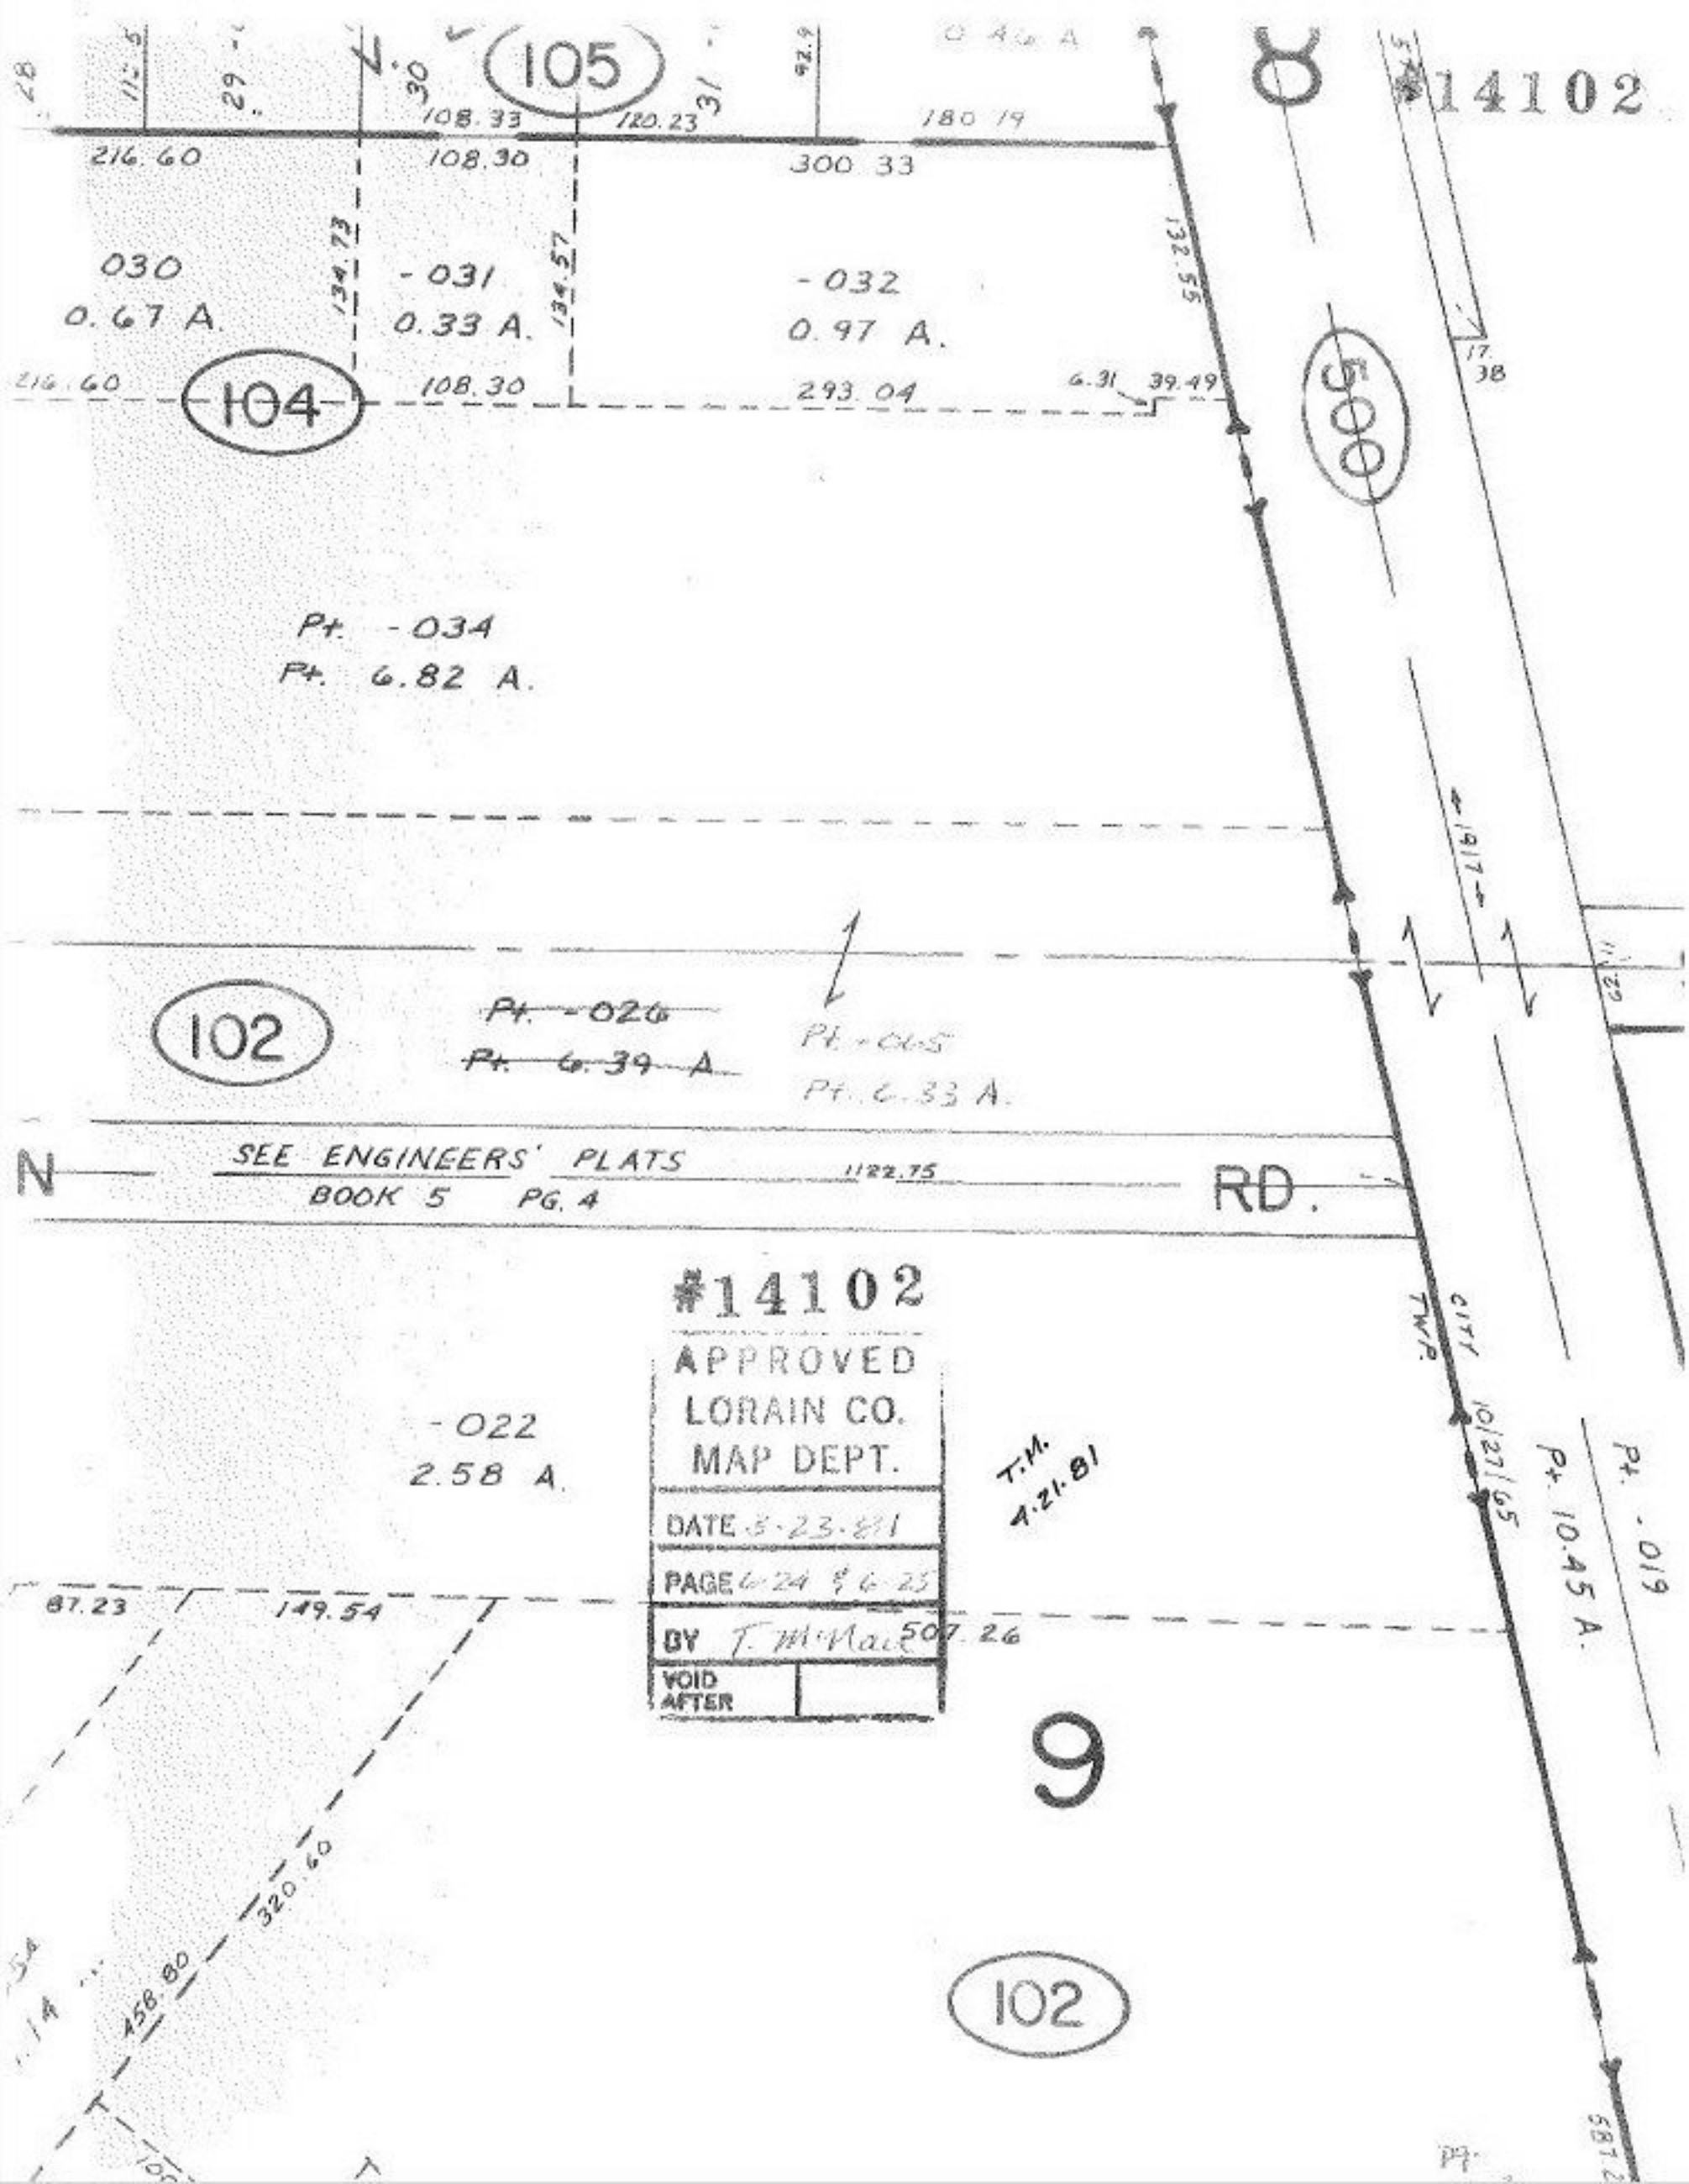

#14102
APPROVED
LORAIN CO.
MAP DEPT.
DATE 3-23-81
PAGE 6-24 & 6-25
BY T. McNair
VOID AFTER