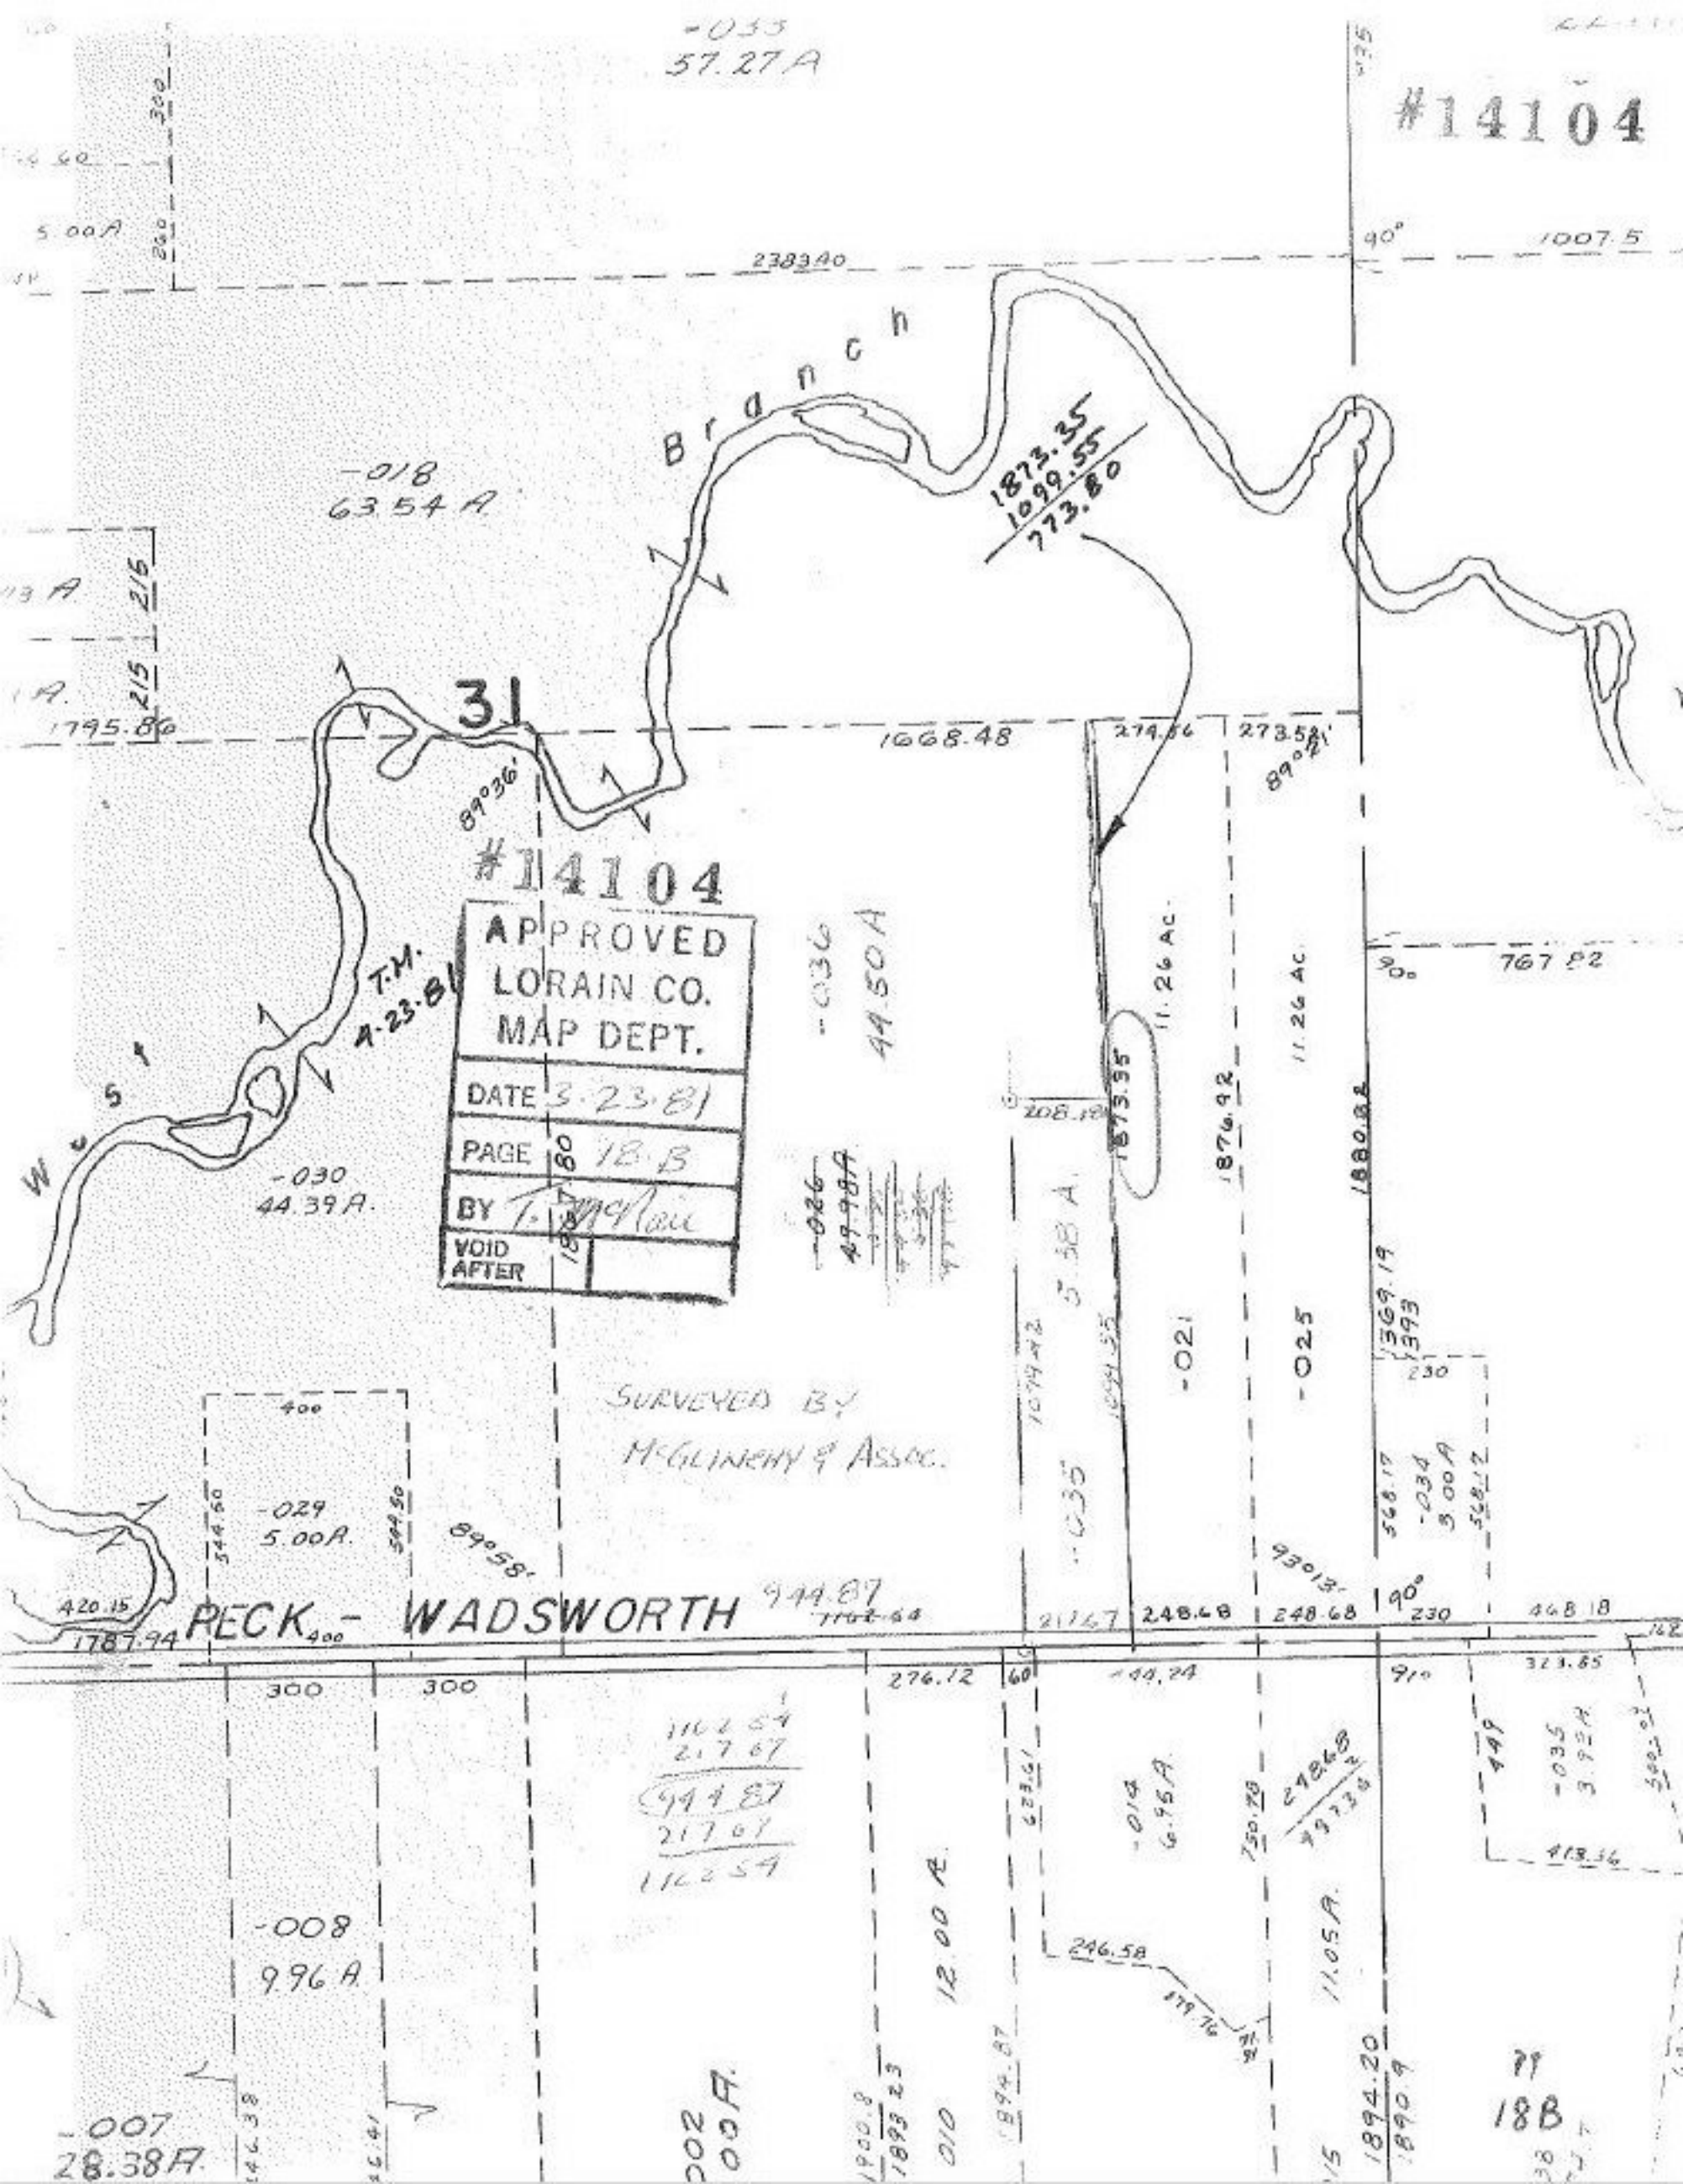

#14104
-033
57.27 A
5.00 A
2383.40
90°
1007.5
Branch
-018
63.54 A
1873.35
1099.55
773.80
31
1795.86
1668.48
274.56
273.52
89°36'
89°21'
#14104
APPROVED
LORAIN CO.
MAP DEPT.
DATE 3-23-81
PAGE 18-B
BY T. McNair
VOID AFTER
T.M.
4-23-81
West
-036
44.50 A
11.26 Ac.
11.26 Ac.
767.82
90°
208.18
1873.35
1876.92
1880.82
-030
44.39 A.
-026
49.98 A
5.38 A.
-021
-025
1369.19
1393
230
SURVEYED BY
McGLINCHY & ASSOC.
400
-029
5.00 A.
544.50
544.50
89°58'
-035
568.17
-034
3.00 A
568.17
93°13'
420.15
1787.94
PECK - WADSWORTH
944.87
1162.54
217.67
248.68
248.68
90°
230
468.18
300
300
276.12
60
444.24
91°
323.85
1162.54
217.67
944.87
217.67
1162.54
-014
6.95 A
248.68
-035
3.93 A
449
413.36
-008
9.96 A
12.00 A
246.58
11.05 A
-007
28.38 A
1894.20
1890.9
18B