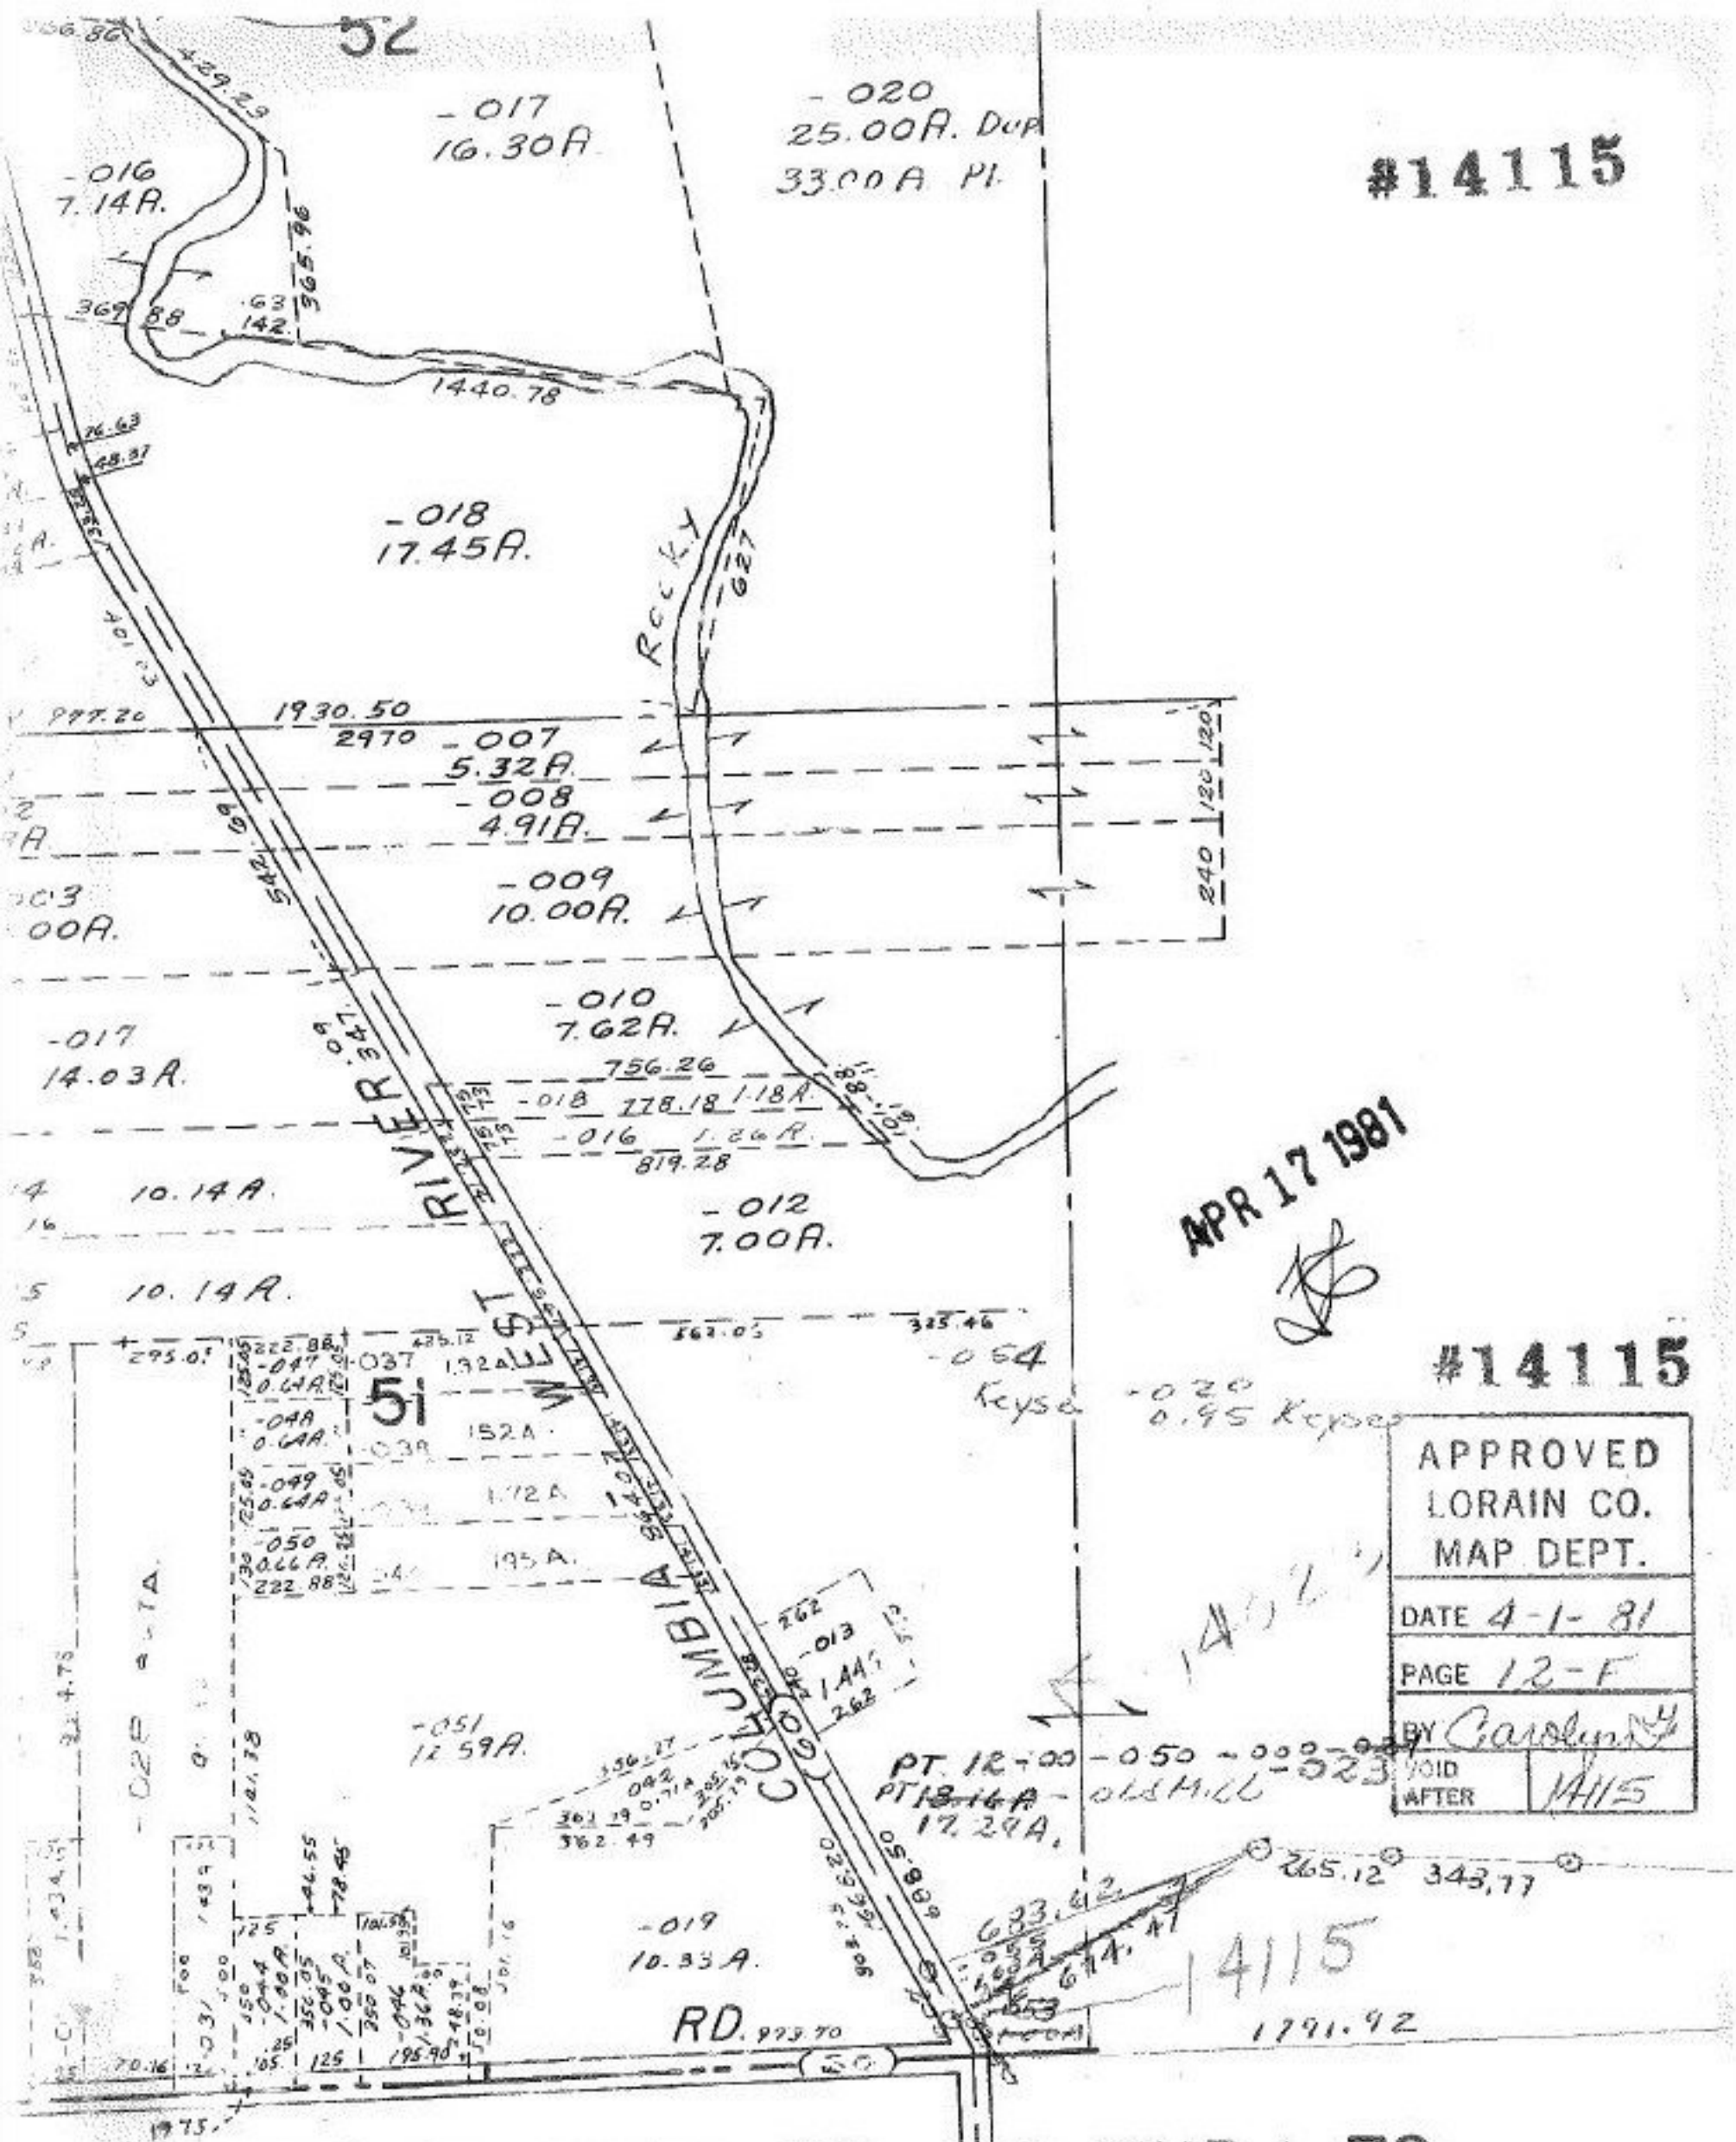
52
-017
16.30A
-020
25.00A. Dup
33.00A Pl.
#14115
-016
7.14A.
-018
17.45A.
Rocky
-007
5.32A.
-008
4.91A.
-009
10.00A.
-010
7.62A.
-017
14.03A.
-012
7.00A.
10.14A.
10.14A.
51
-054
Keyse
-020
0.95 Keyse
#14115
APPROVED
LORAIN CO.
MAP DEPT.
DATE 4-1-81
PAGE 12-F
BY Carolyn
VOID AFTER 14115
COLUMBIA WEST RIVER
-051
12.59A.
-019
10.33A.
RD.
14115
1791.92
LOTS 51 THRU 55, 66 THR 70