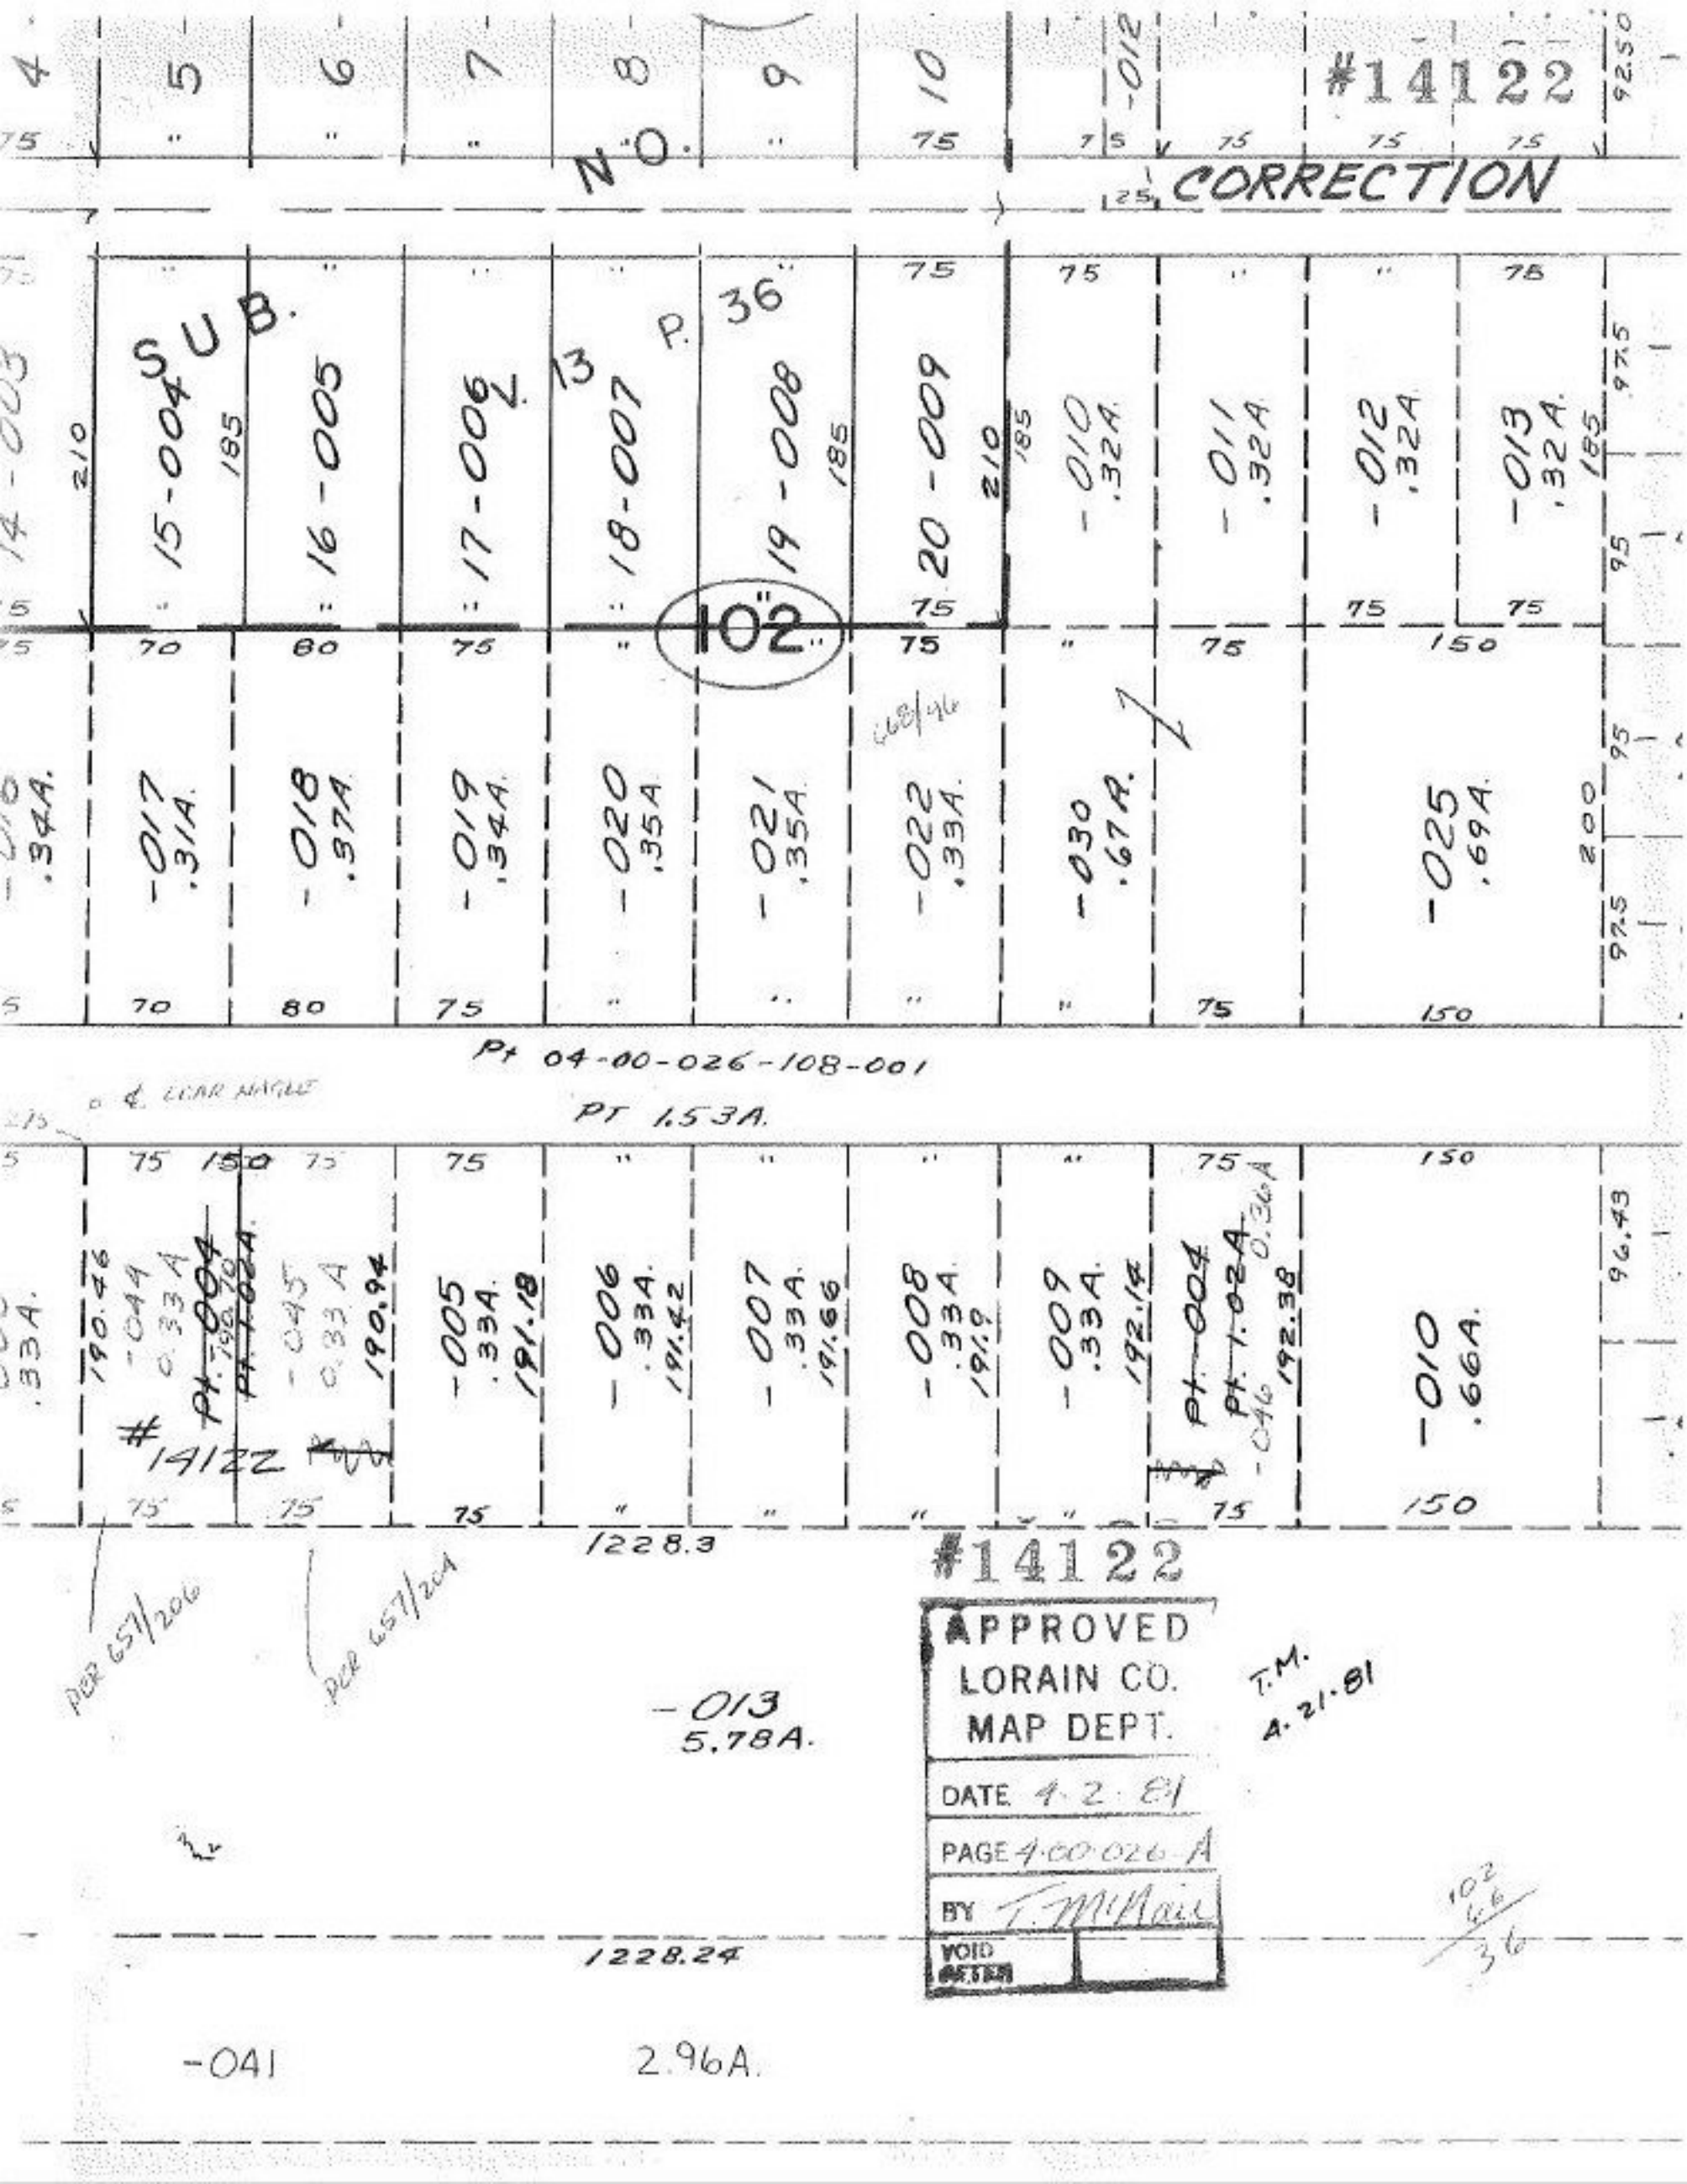

#14122
CORRECTION
NO.
SUB.
V. 13 P. 36
102
15-004
16-005
17-006
18-007
19-008
20-009
-010 .32A.
-011 .32A
-012 .32A
-013 .32A.
-017 .31A.
-018 .37A.
-019 .34A.
-020 .35A
-021 .35A.
-022 .33A.
-030 .67A.
-025 .69A.
Pt 04-00-026-108-001
PT 1.53A.
-005 .33A. 191.18
-006 .33A. 191.42
-007 .33A. 191.66
-008 .33A. 191.9
-009 .33A. 192.14
-010 .66A.
1228.3
#14122
PER 657/206
PER 657/204
-013 5.78A.
1228.24
-041
2.96A.
APPROVED
LORAIN CO.
MAP DEPT.
DATE 4-2-81
PAGE 4-00-026-A
BY T. McNair
VOID
T.M.
4-21-81