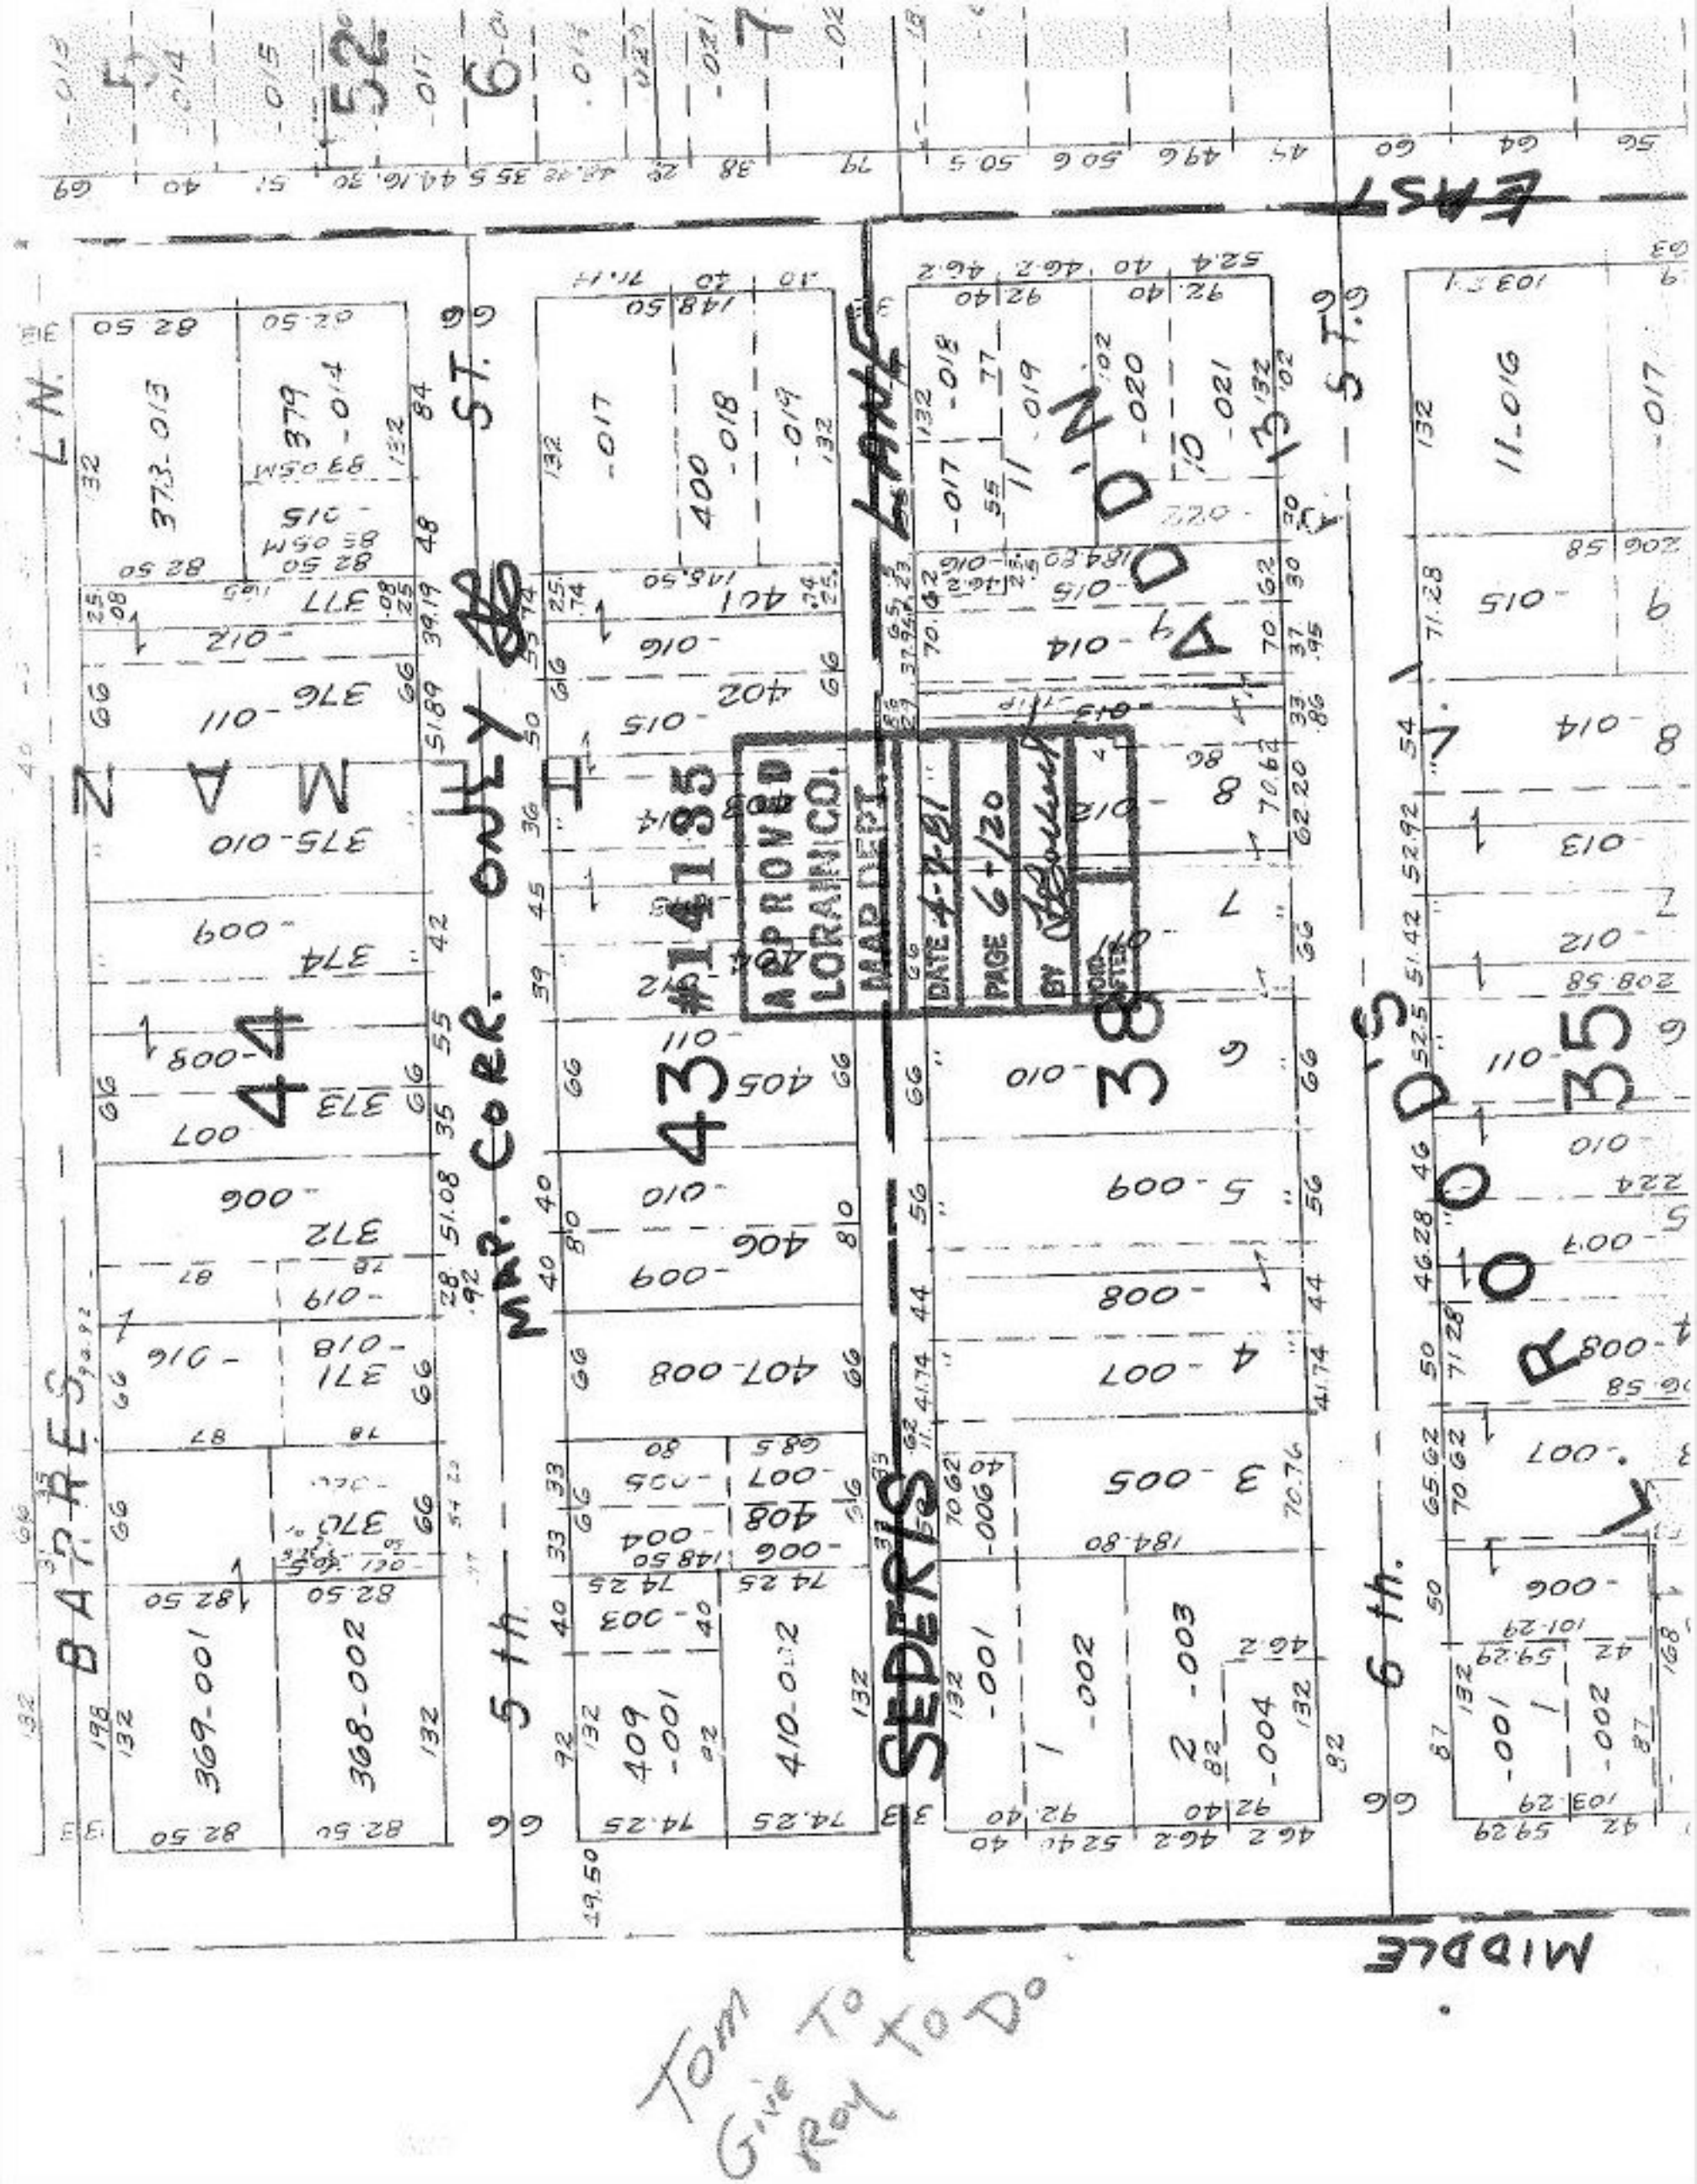
ST. 9
MAP
APPROVED
LORAIN CO.
MAP DEPT.
DATE 4-7-81
PAGE 6+120
BY
ADDITIONS
SEDERS
5th.
6th.
MIDDLE
MAY
373-013
379
-014
-015
377
-012
376-011
375-010
374
-009
373
-008
-007
372
-019
-018
-016
371
370
369-001
368-002
401
-016
402
-015
405
-010
406
-009
407-008
408
-006
-004
-005
-003
409
-001
410-002
-017
400
-018
-019
Tom
Give To
Roy To Do