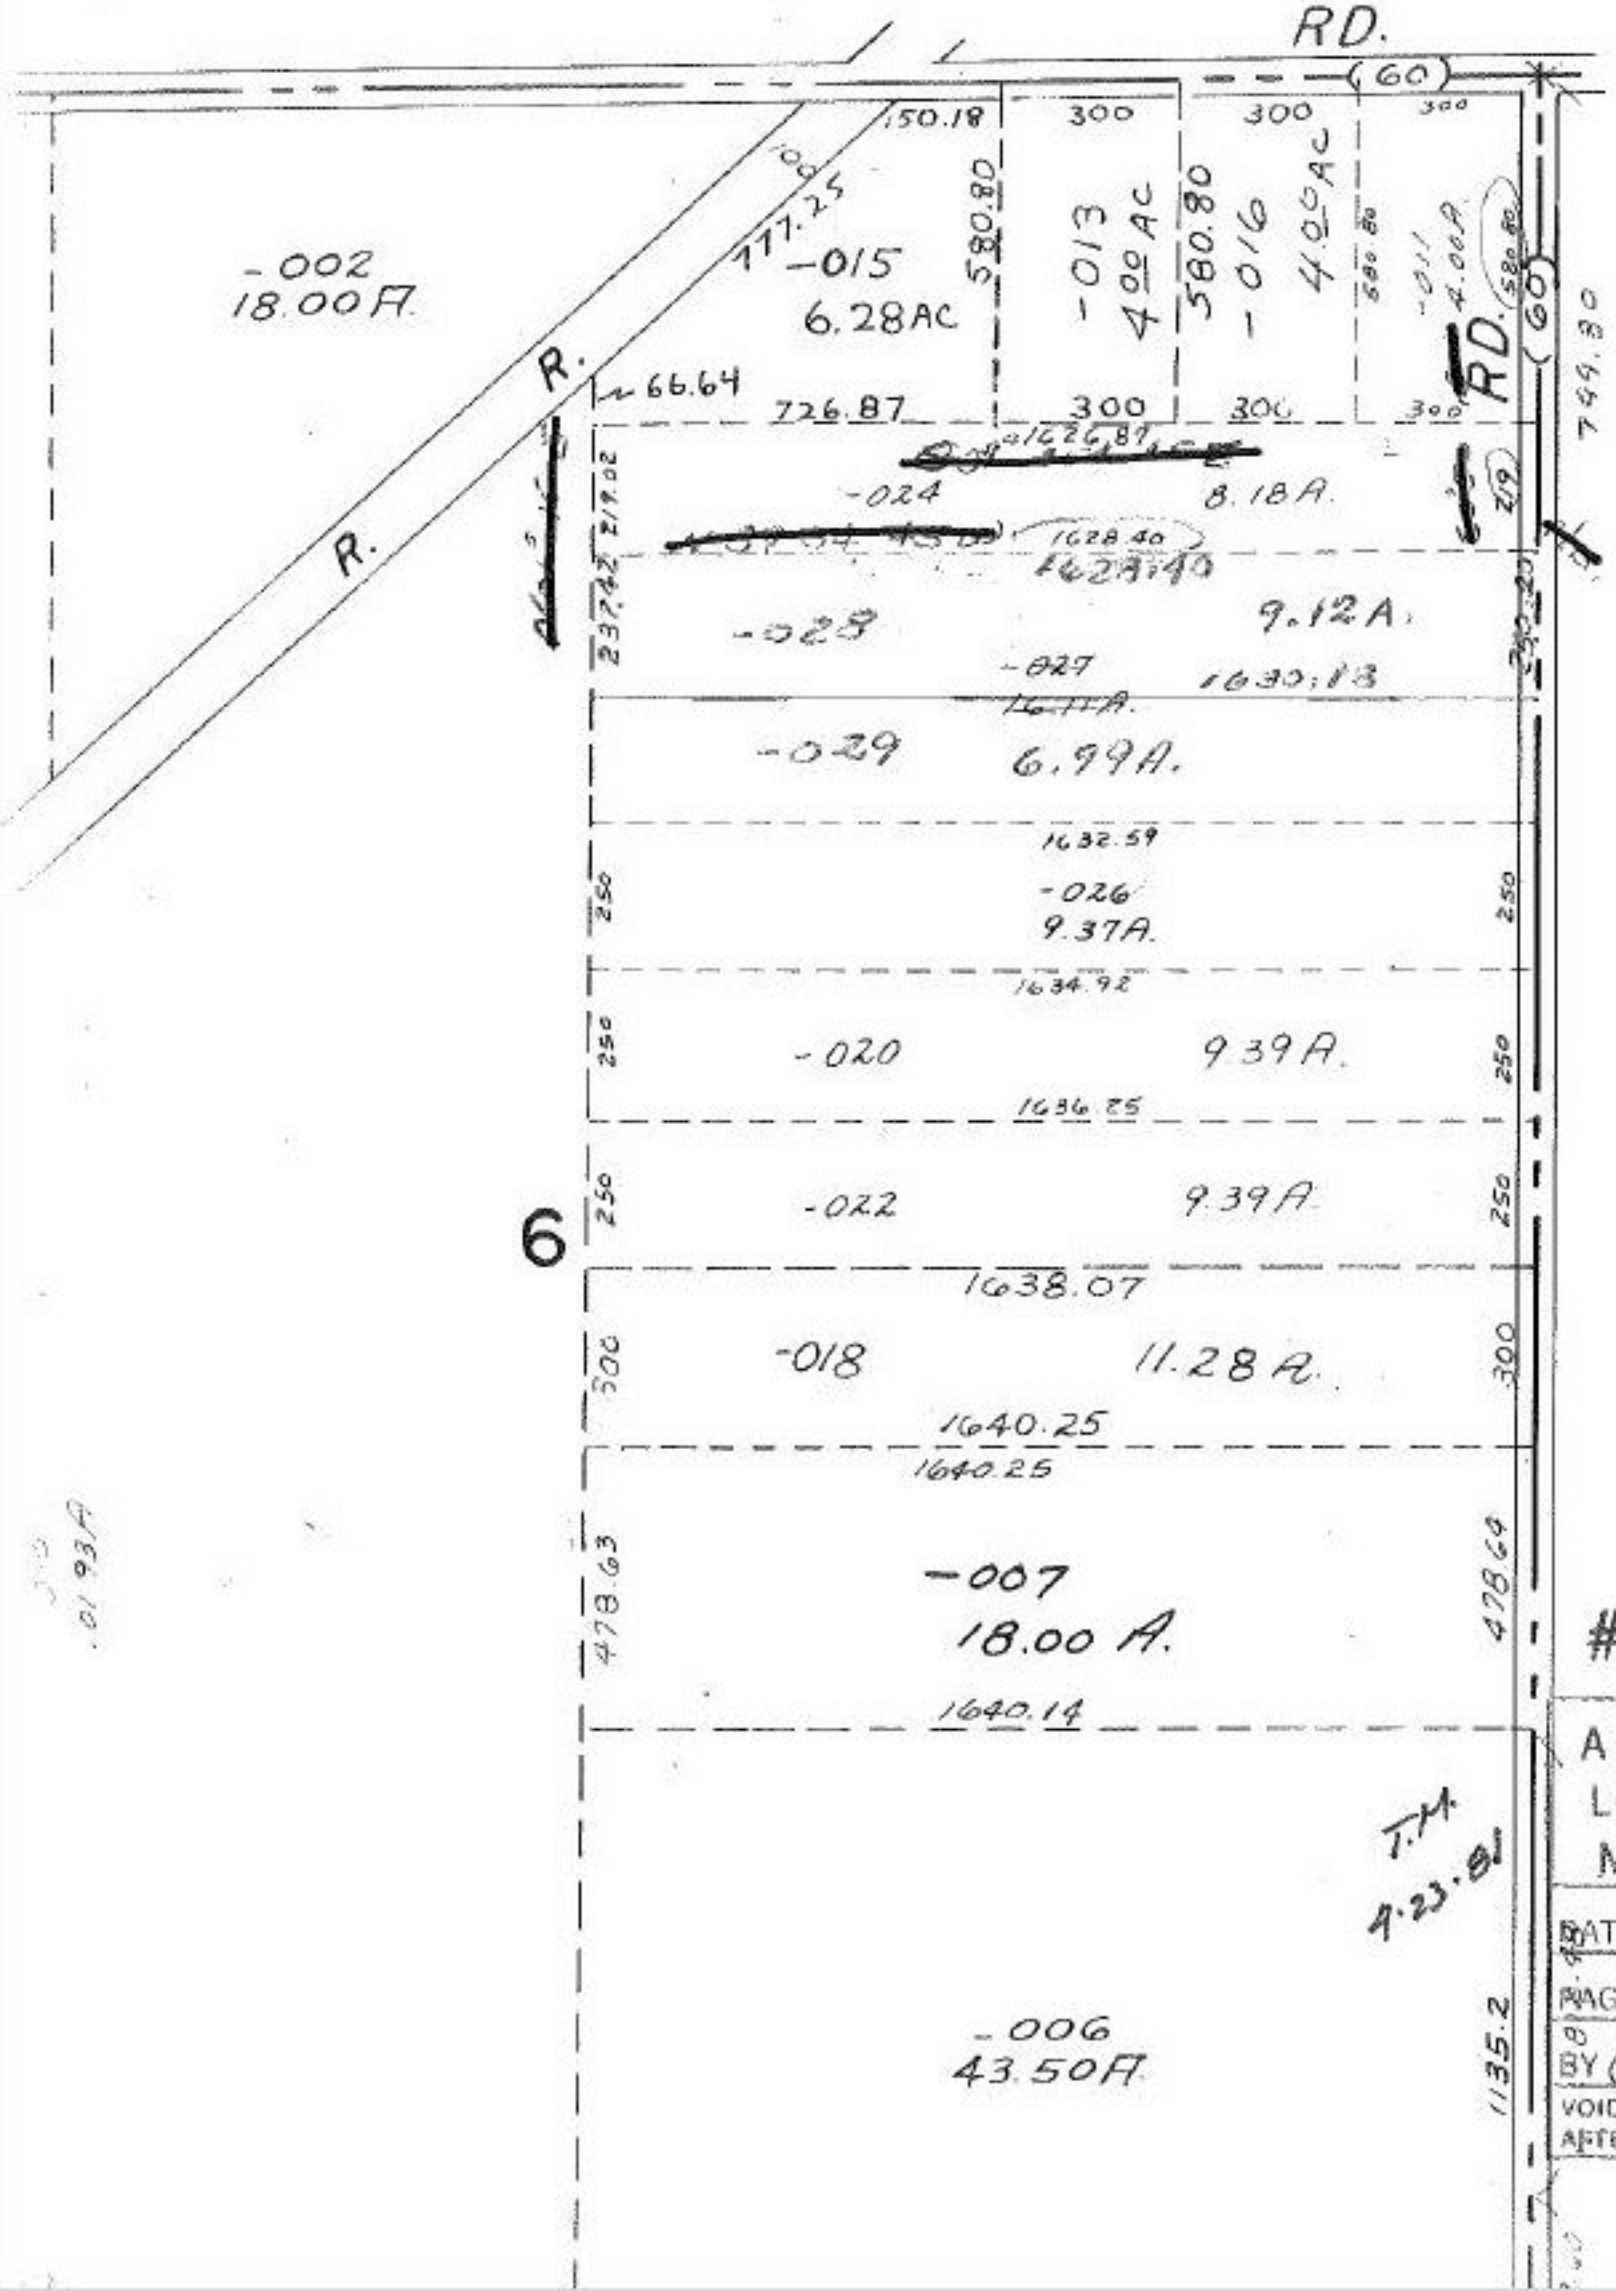
RD.
(60)
150.18
300
300
300
580.80
580.80
580.80
-002
18.00A.
R.
R.
R.
117.25
-015
6.28AC
-013
4.00AC
-016
4.00AC
-011
4.00A.
RD.
(60)
749.30
66.64
726.87
300
300
300
1626.87
-024
8.18A.
1628.40
1629.40
237.42
-023
9.12A.
-027
1630.13
-029
6.99A.
1632.59
250
-026
9.37A.
250
1634.92
250
-020
9.39A.
250
1636.25
250
-022
9.39A.
250
1638.07
300
-018
11.28A.
300
1640.25
1640.25
478.63
-007
18.00A.
478.64
1640.14
-006
43.50A.
1135.2
6
.01 93A
T.M.
4-23-81
#14143
APPROVED
LORAIN CO.
MAP DEPT.
DATE 4-14-81
PAGE 18-D
BY Carolyn T
VOID AFTER 1443