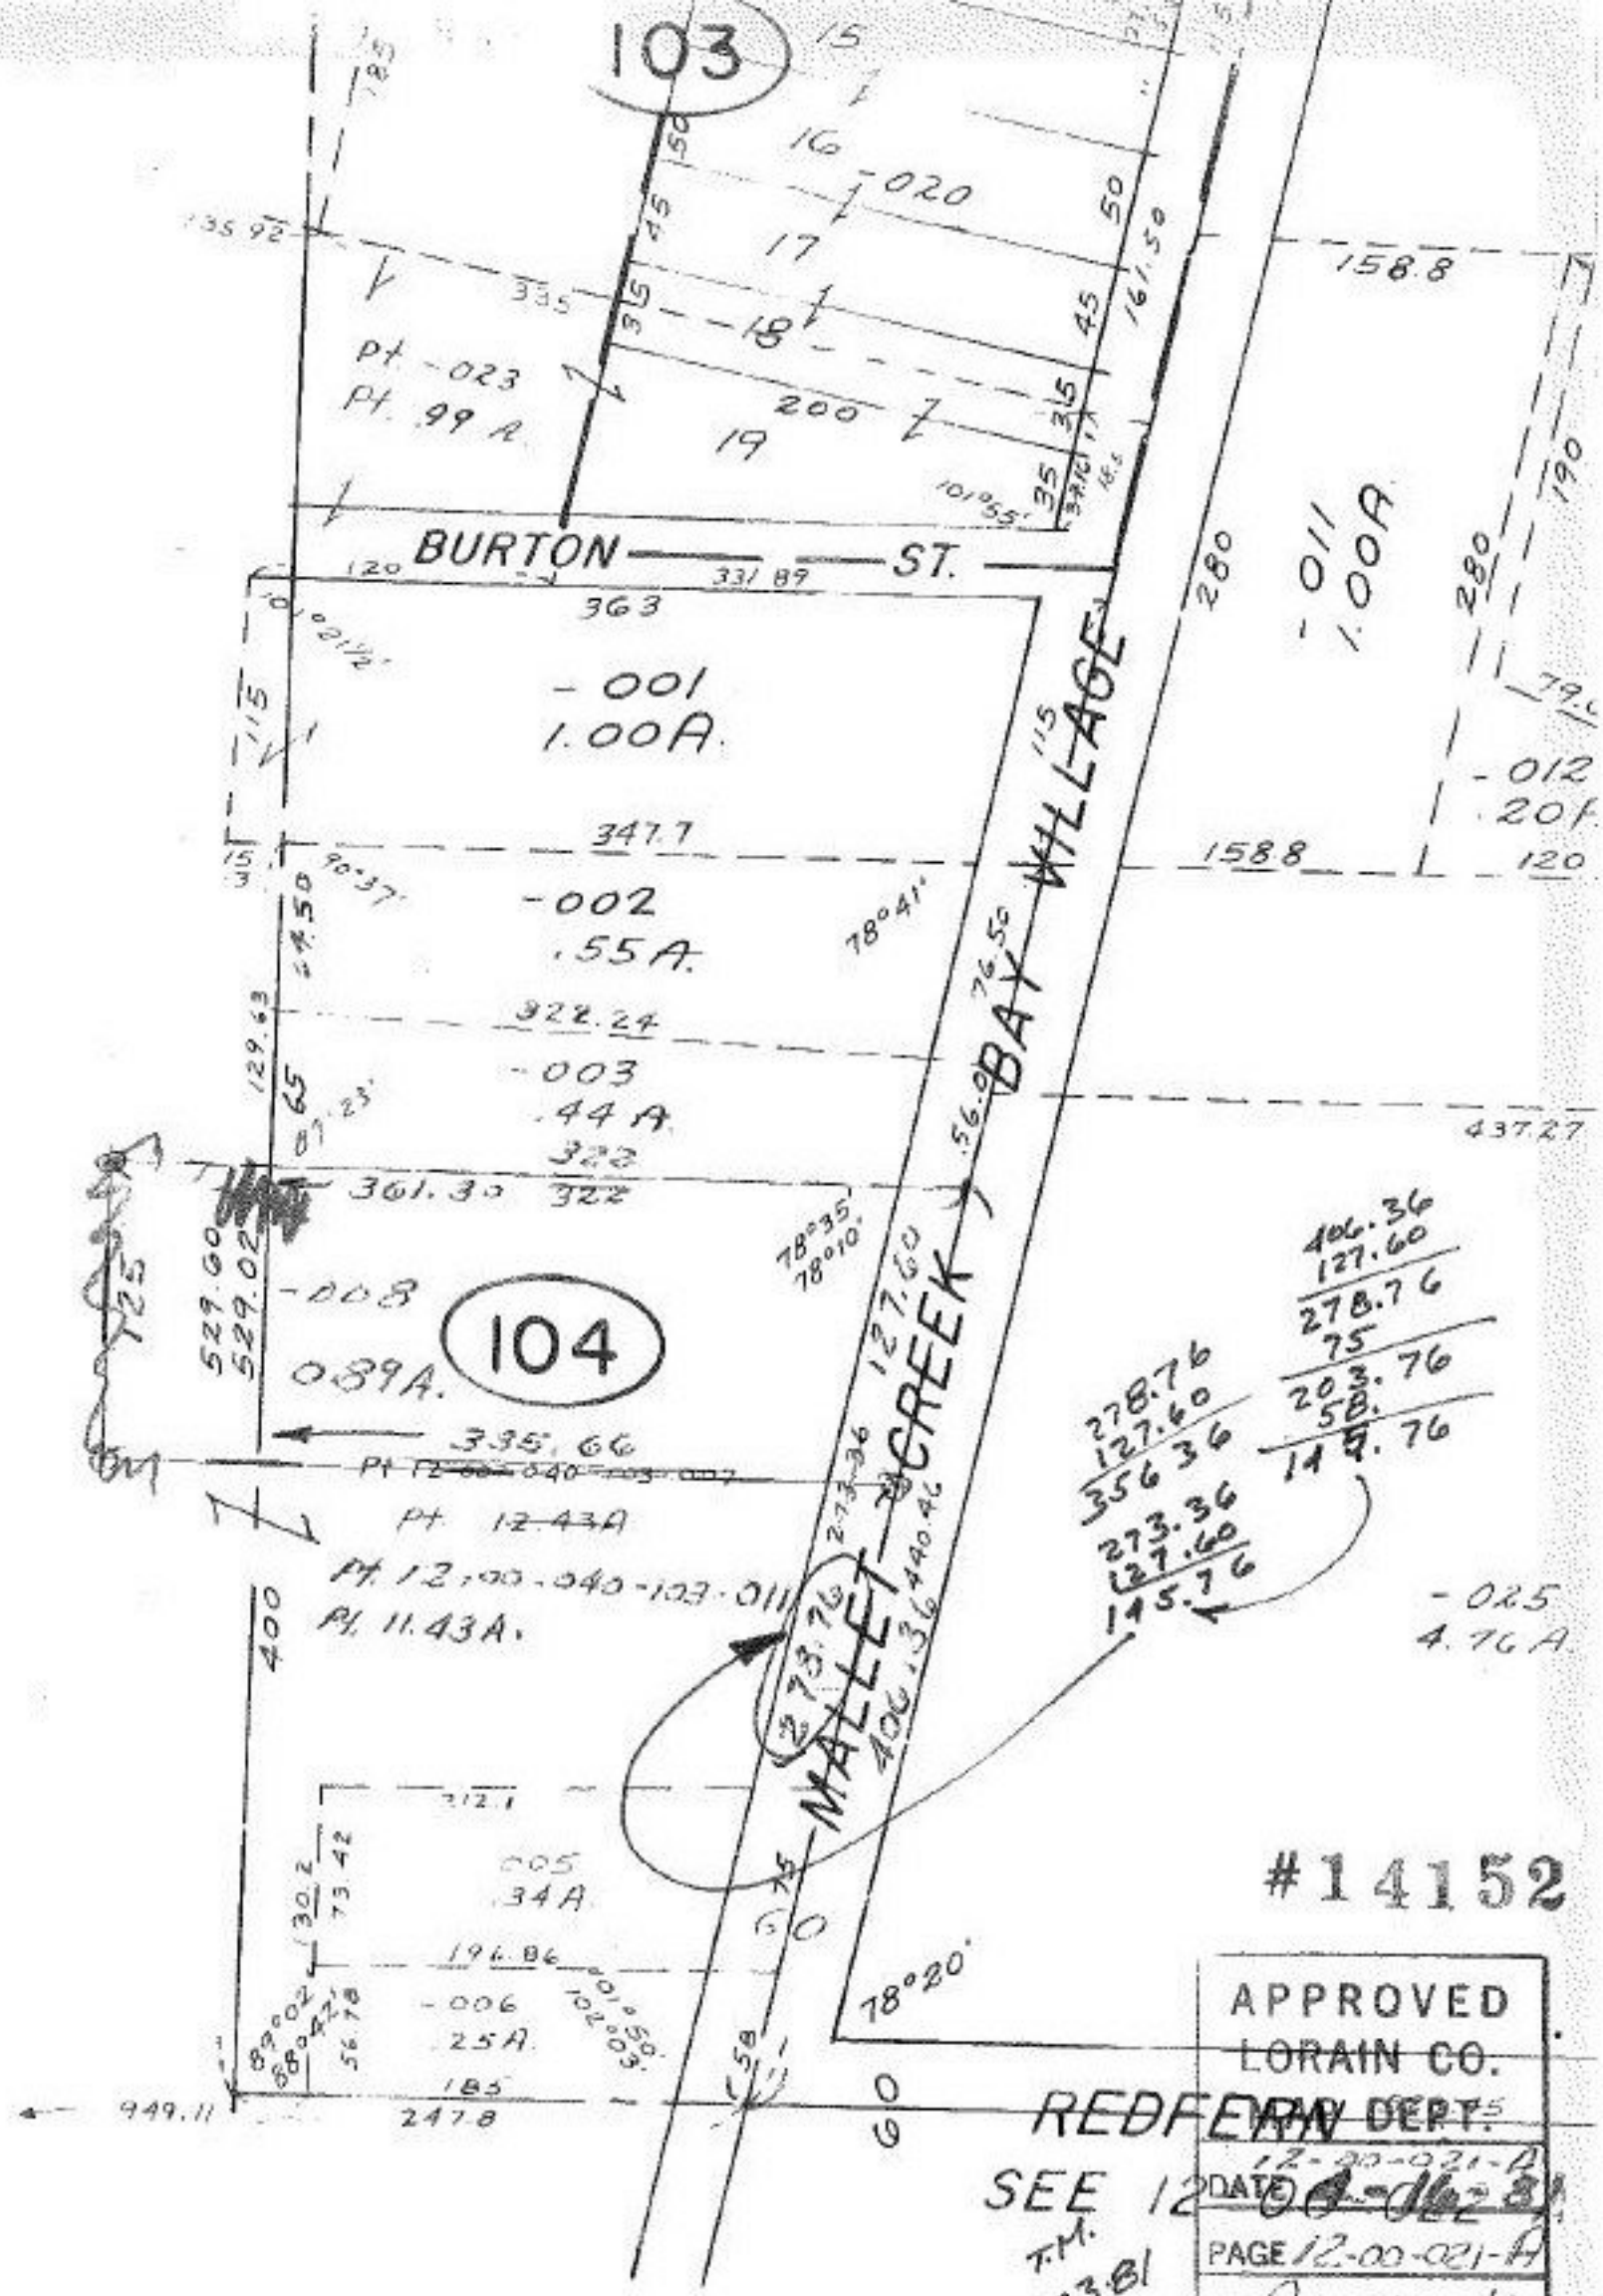

#14152

APPROVED
LORAIN CO.
PLAN DEPT.
DATE 12-00-021-A
PAGE 12-00-021-A
BY Carolyn
VOID AFTER

COLUMBIA TWP.

SCALE: 1" = 100'

WL