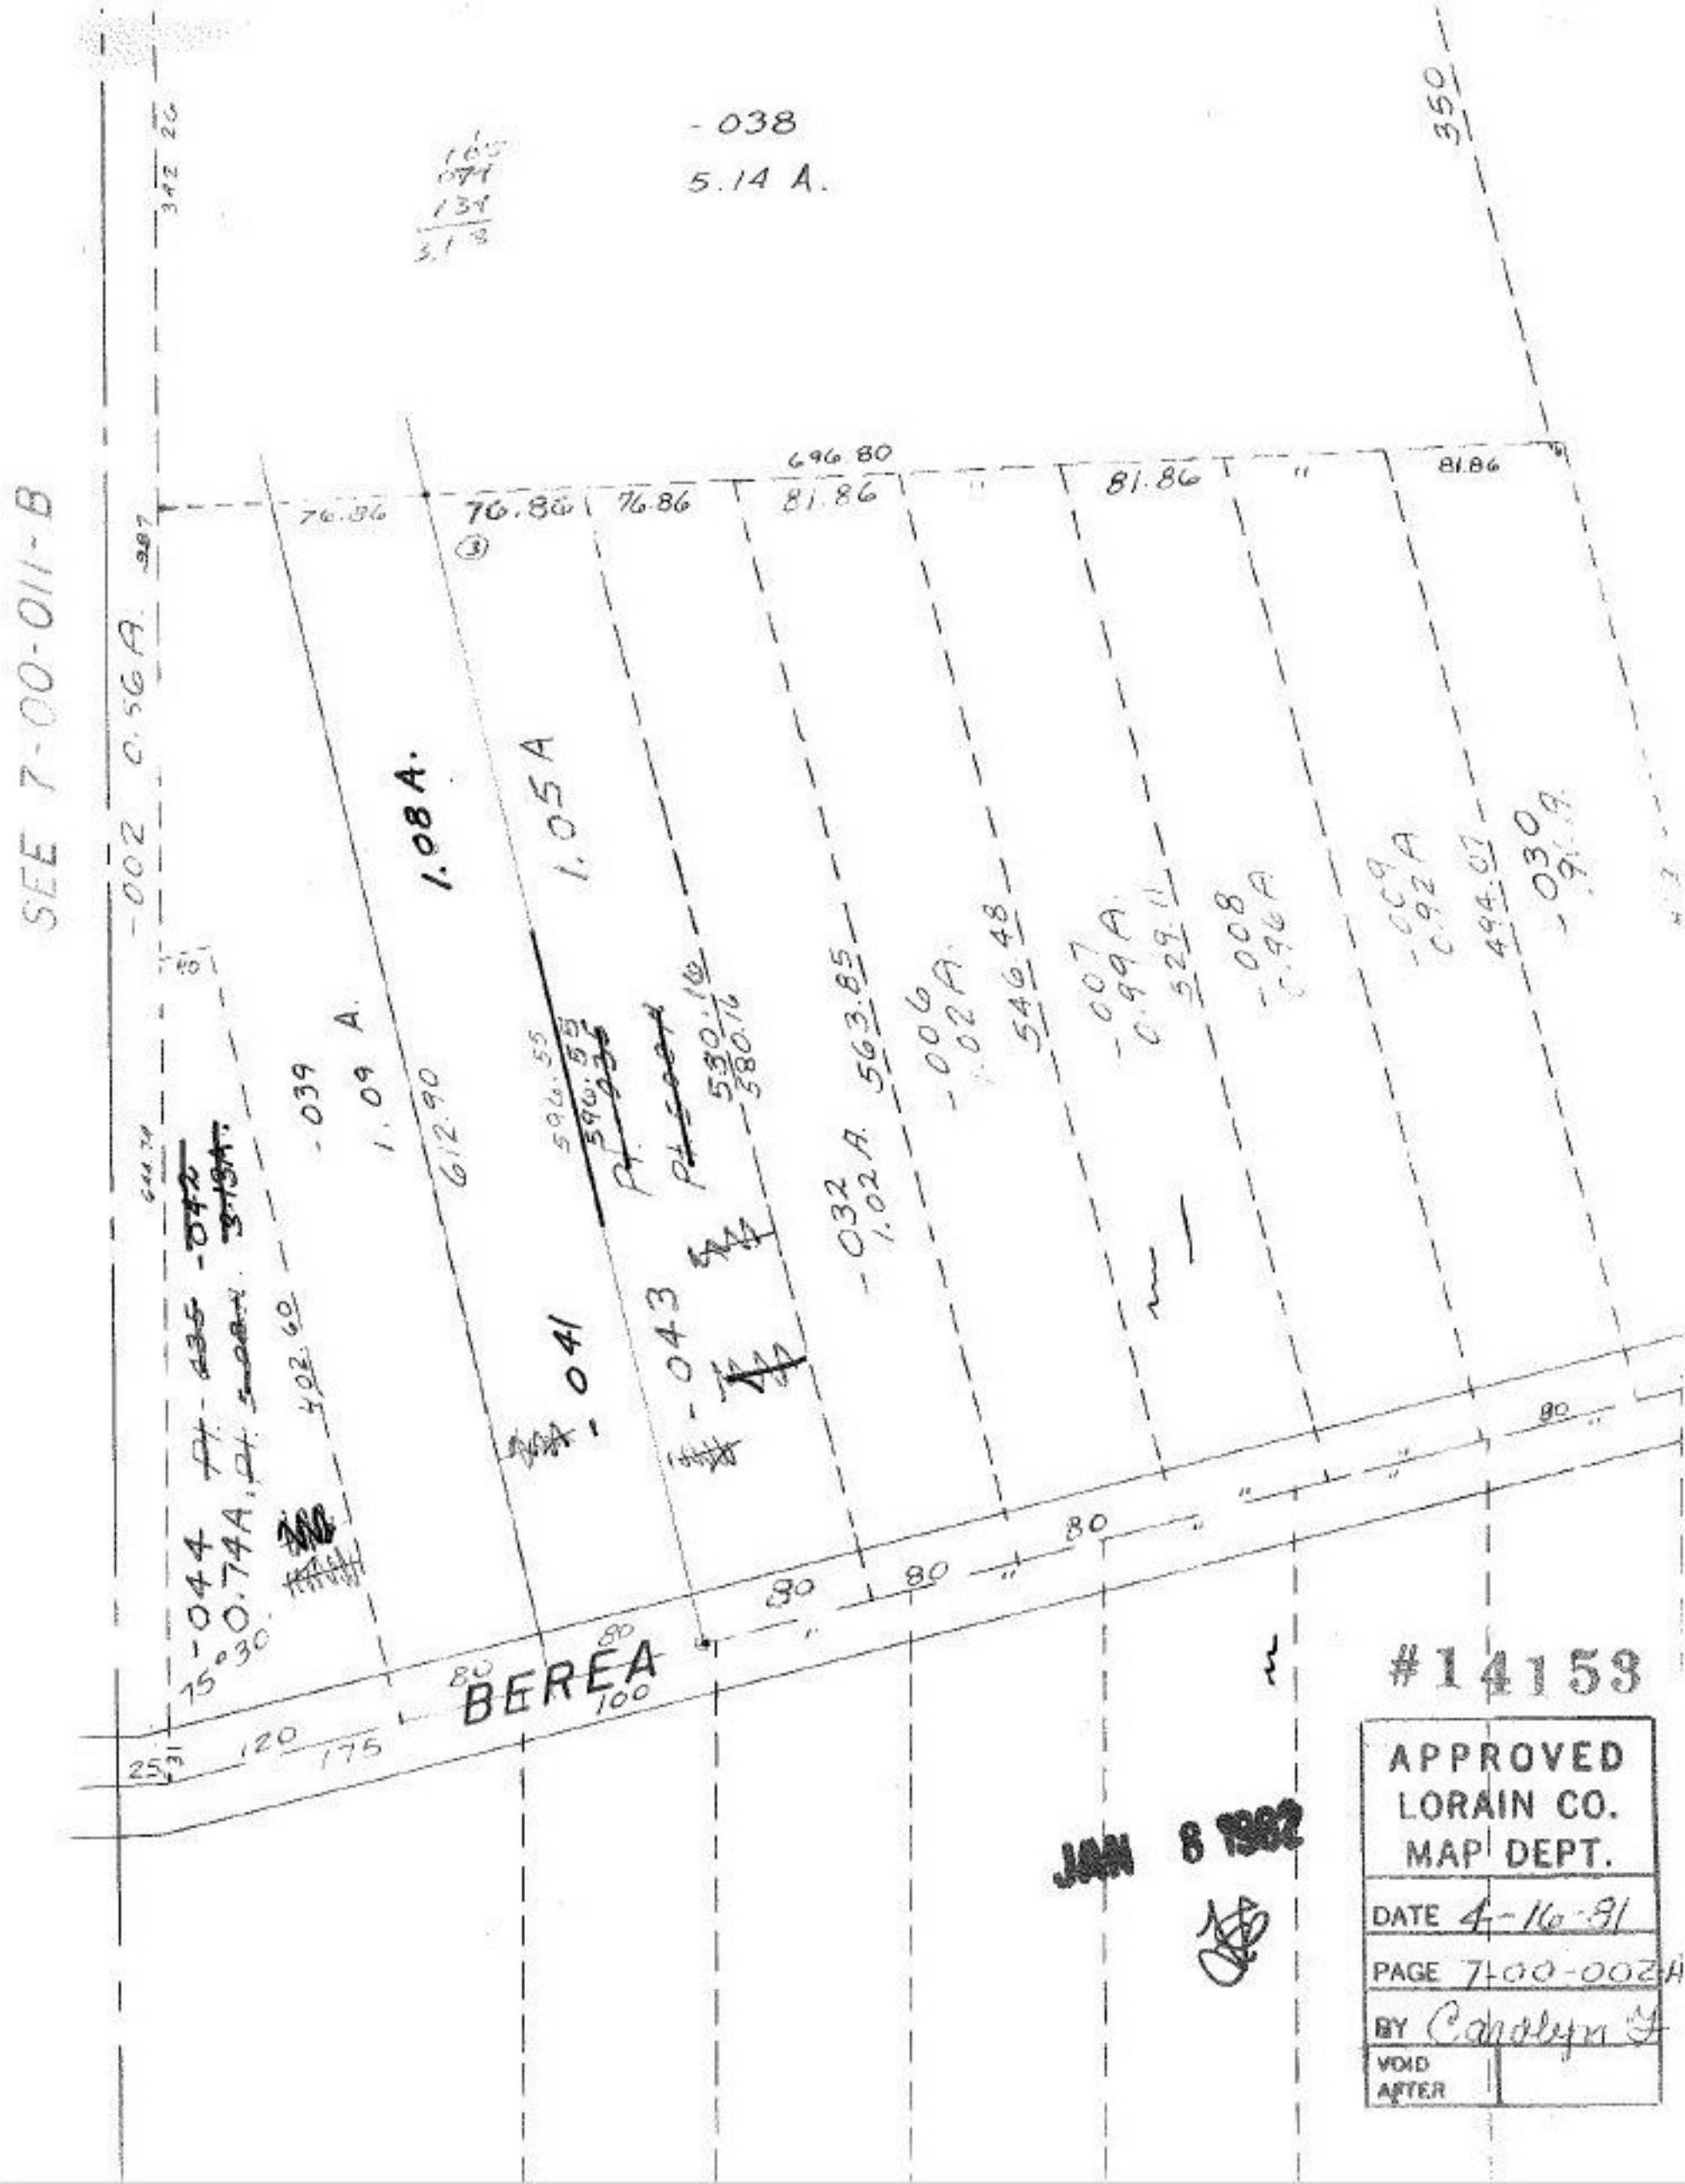

#14153

APPROVED
LORAIN CO.
MAP DEPT.

DATE 4-16-81

PAGE 7-00-002A

BY Carolyn F

VOID AFTER

JAN 8 1982