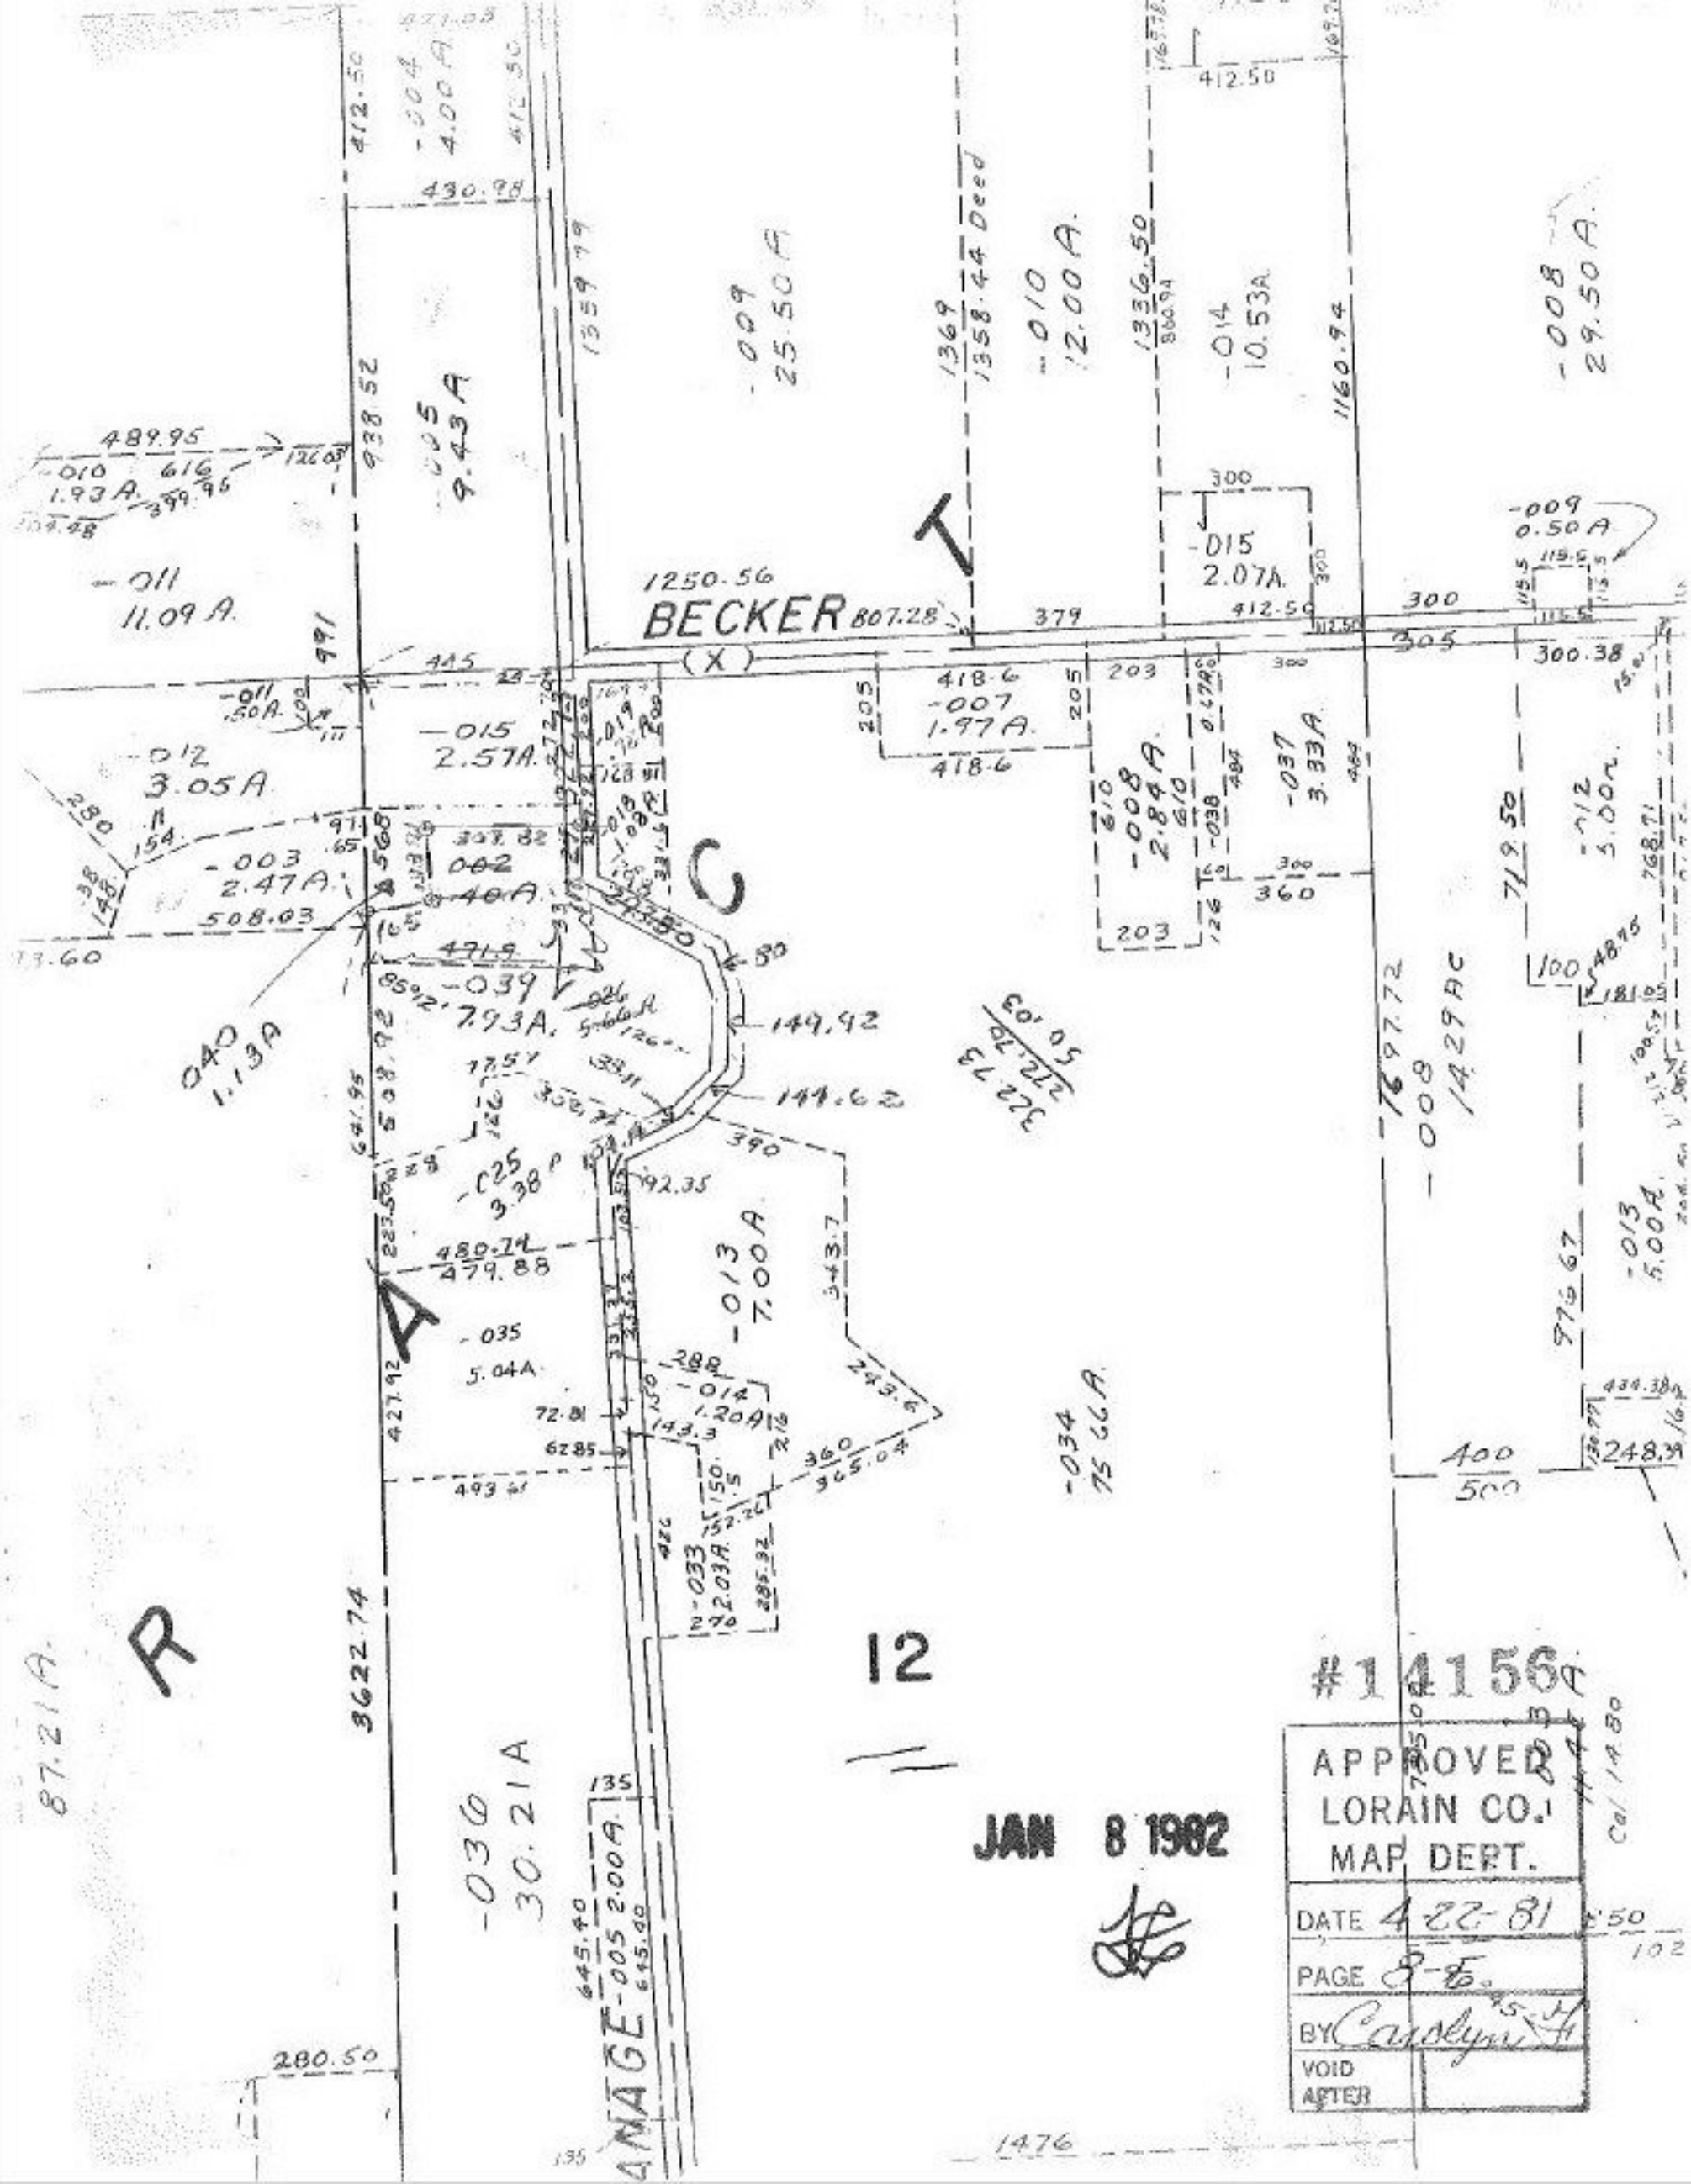
BECKER
12
#14156
APPROVED
LORAIN CO.
MAP DEPT.
DATE 4-22-81
PAGE 8-5
BY Carolyn
VOID
AFTER
JAN 8 1982