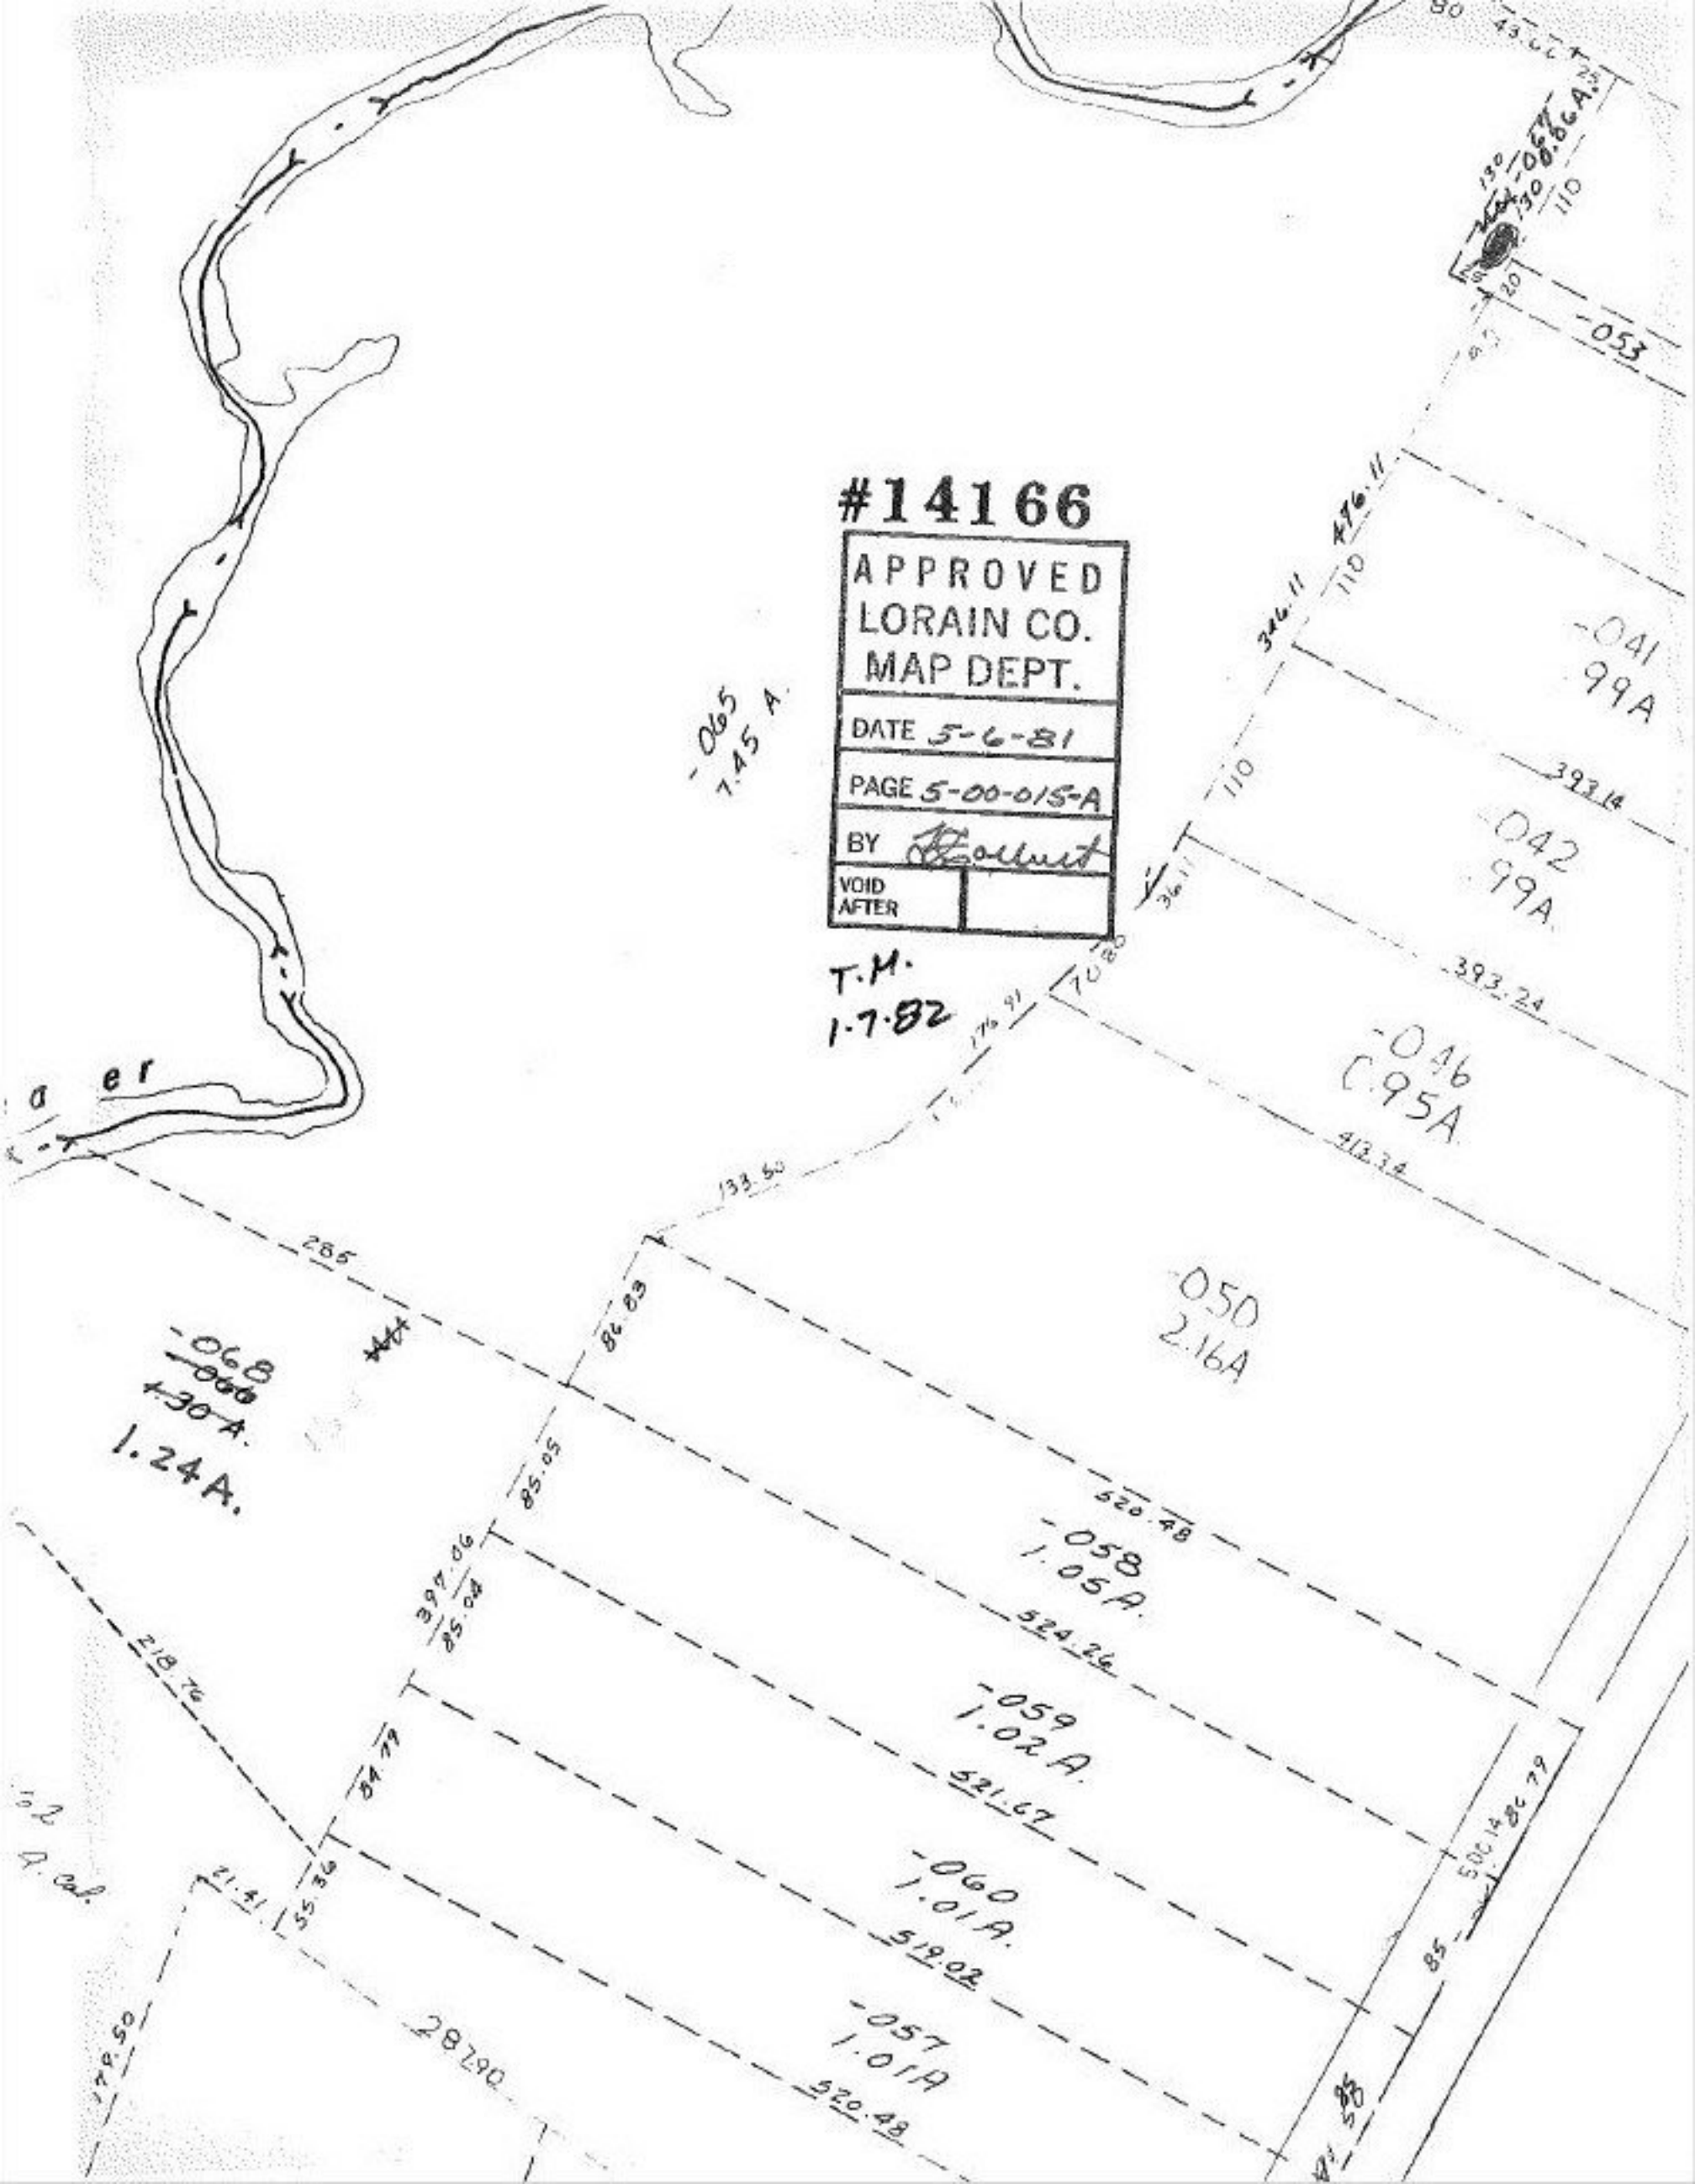
#14166
APPROVED
LORAIN CO.
MAP DEPT.
DATE 5-6-81
PAGE 5-00-015-A
BY
VOID AFTER
T.M.
1.7.82
-065
7.45 A.
-041
.99A
-042
.99A
-046
0.95A
-050
2.16A
-068
1.24A.
-058
1.05A.
-059
1.02A.
-060
1.01A.
-057
1.01A
-053
476.11
346.11
393.14
393.24
413.34
133.50
285
86.83
85.05
397.06
85.04
84.79
55.36
21.41
218.76
179.50
520.48
524.26
521.67
519.02
520.48
287.90
86.79
85