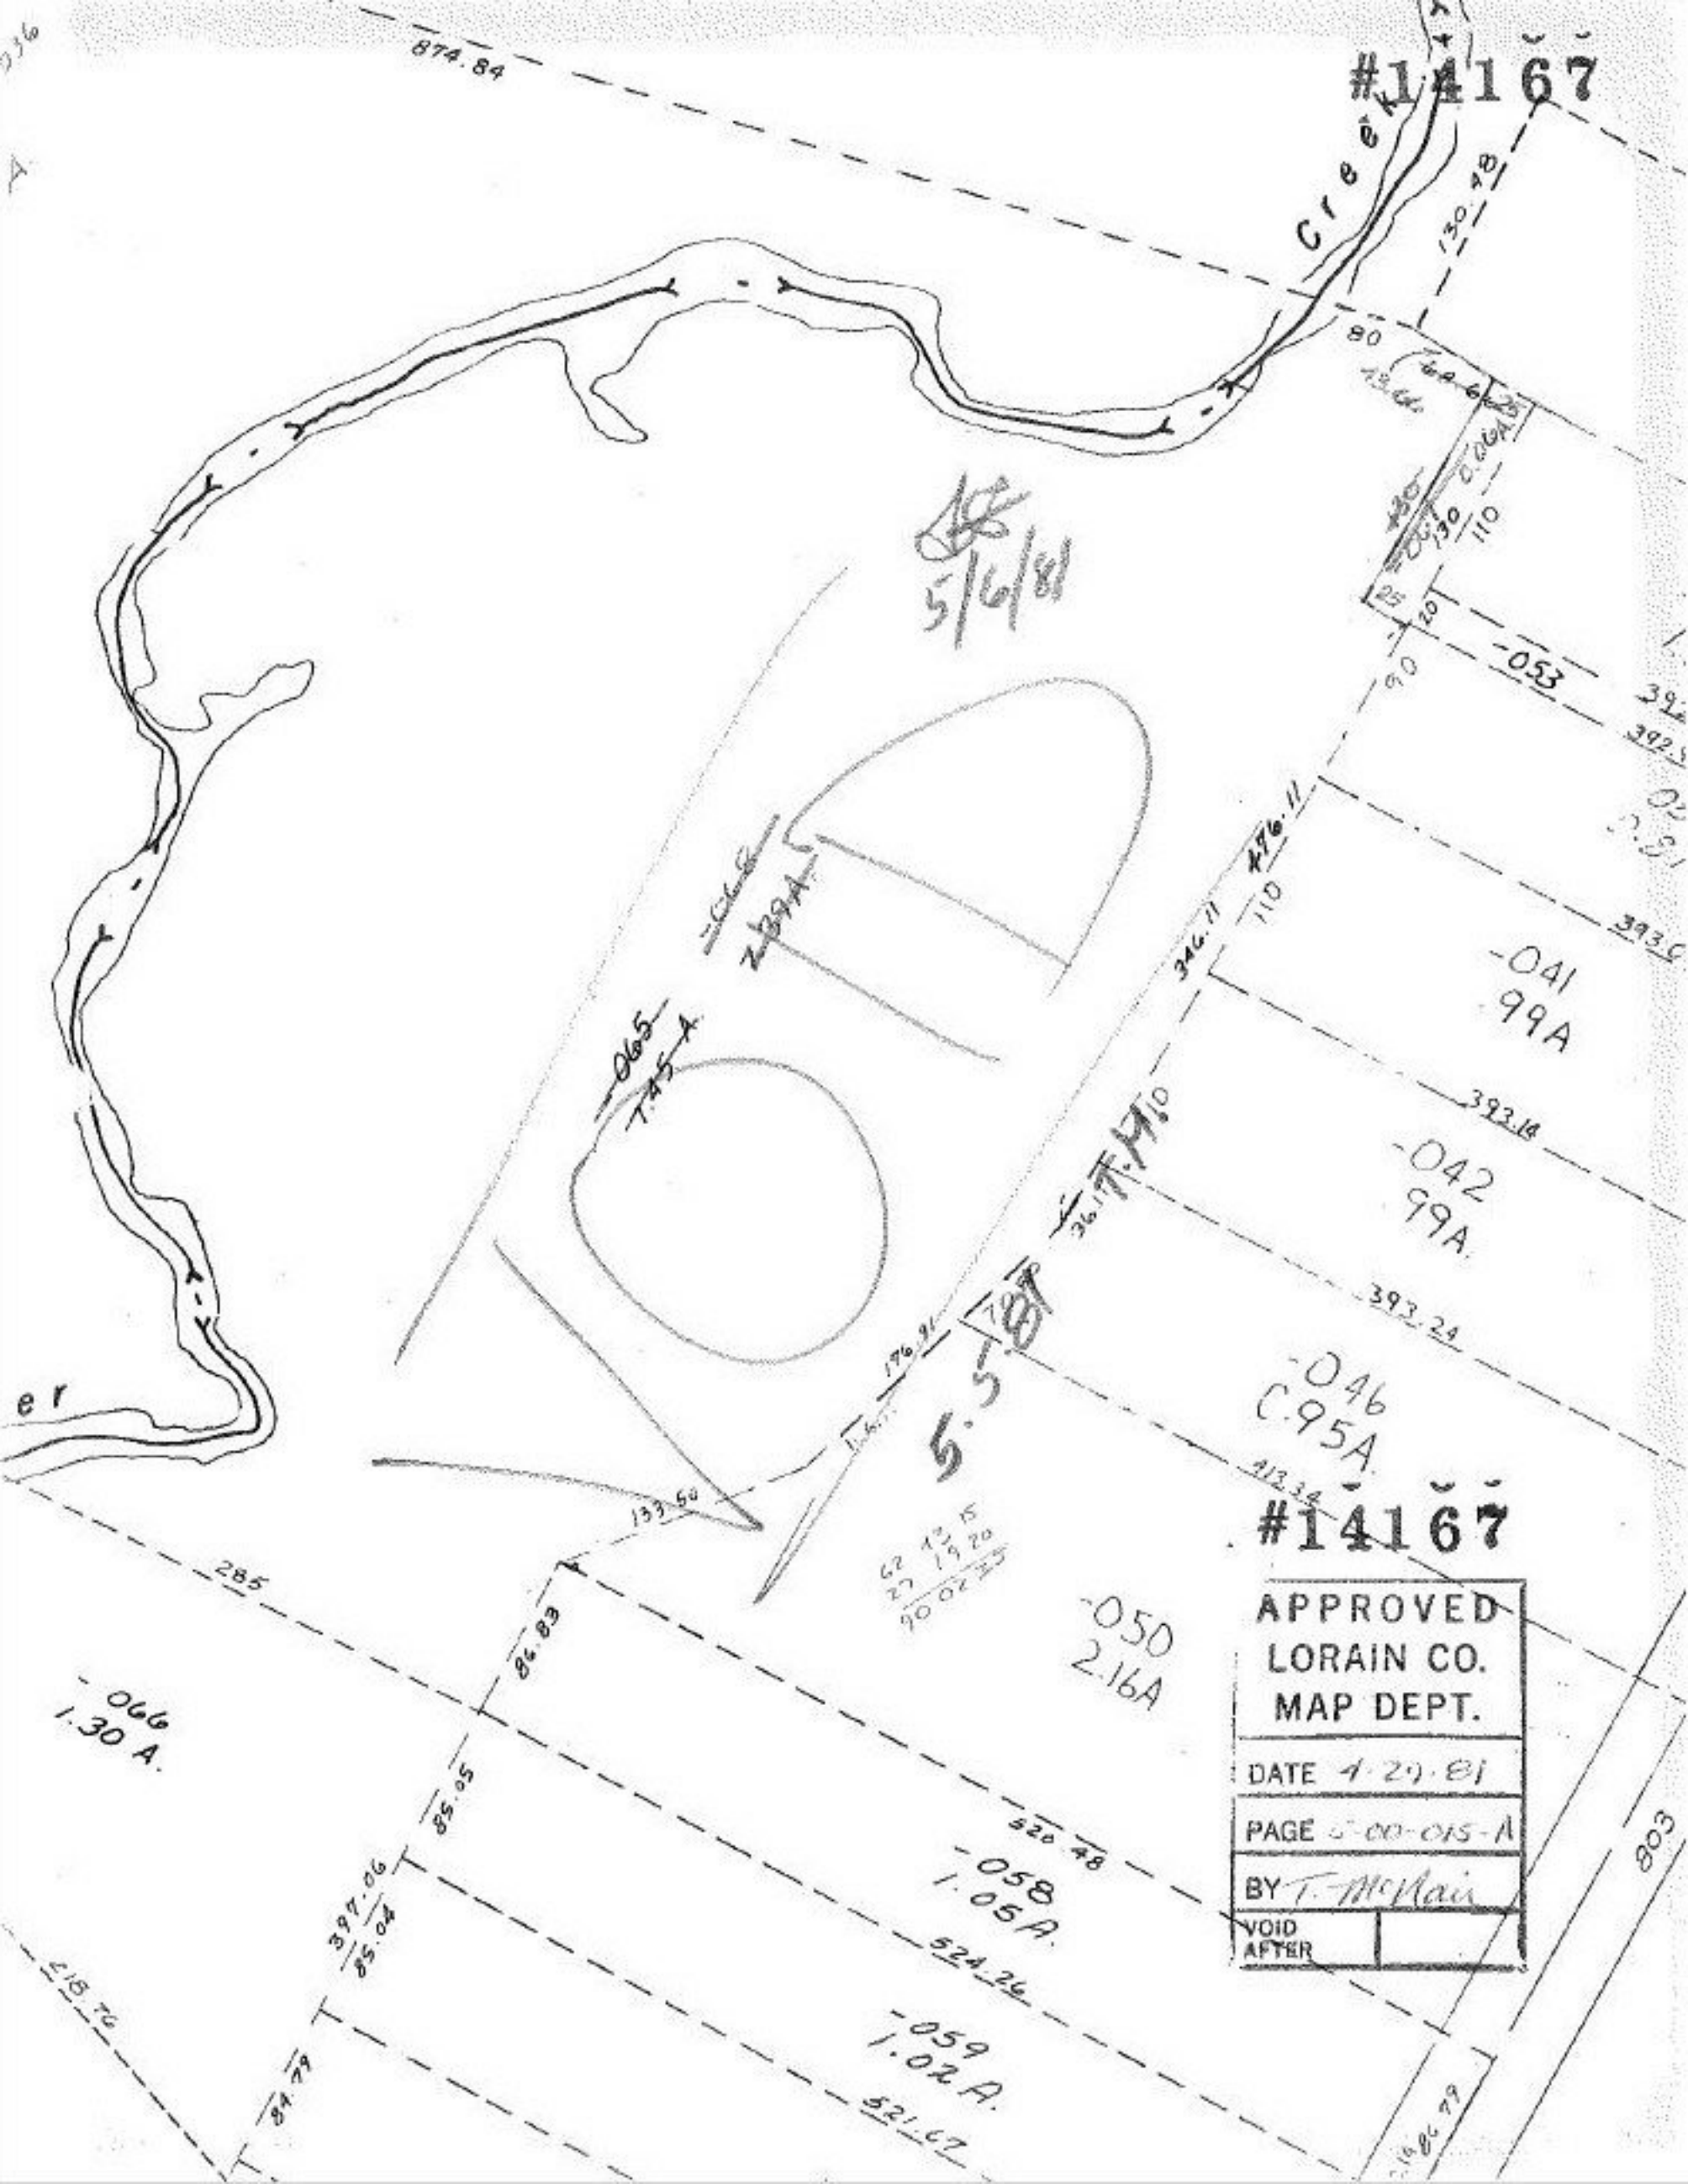
#14167
874.84
Creek
130.48
80
5/6/81
-053
-041
99A
-042
99A
-046
C.95A
-050
2.16A
-058
1.05A
-059
1.02A
-066
1.30 A.
-065
7.45 A
-068
2.39A
476.11
346.11
393.14
393.24
413.34
176.91
133.50
285
86.83
85.05
397.06
85.04
84.79
520.48
524.26
521.67
803
#14167
APPROVED
LORAIN CO.
MAP DEPT.
DATE 4-29-81
PAGE 5-00-015-A
BY T. McNair
VOID AFTER