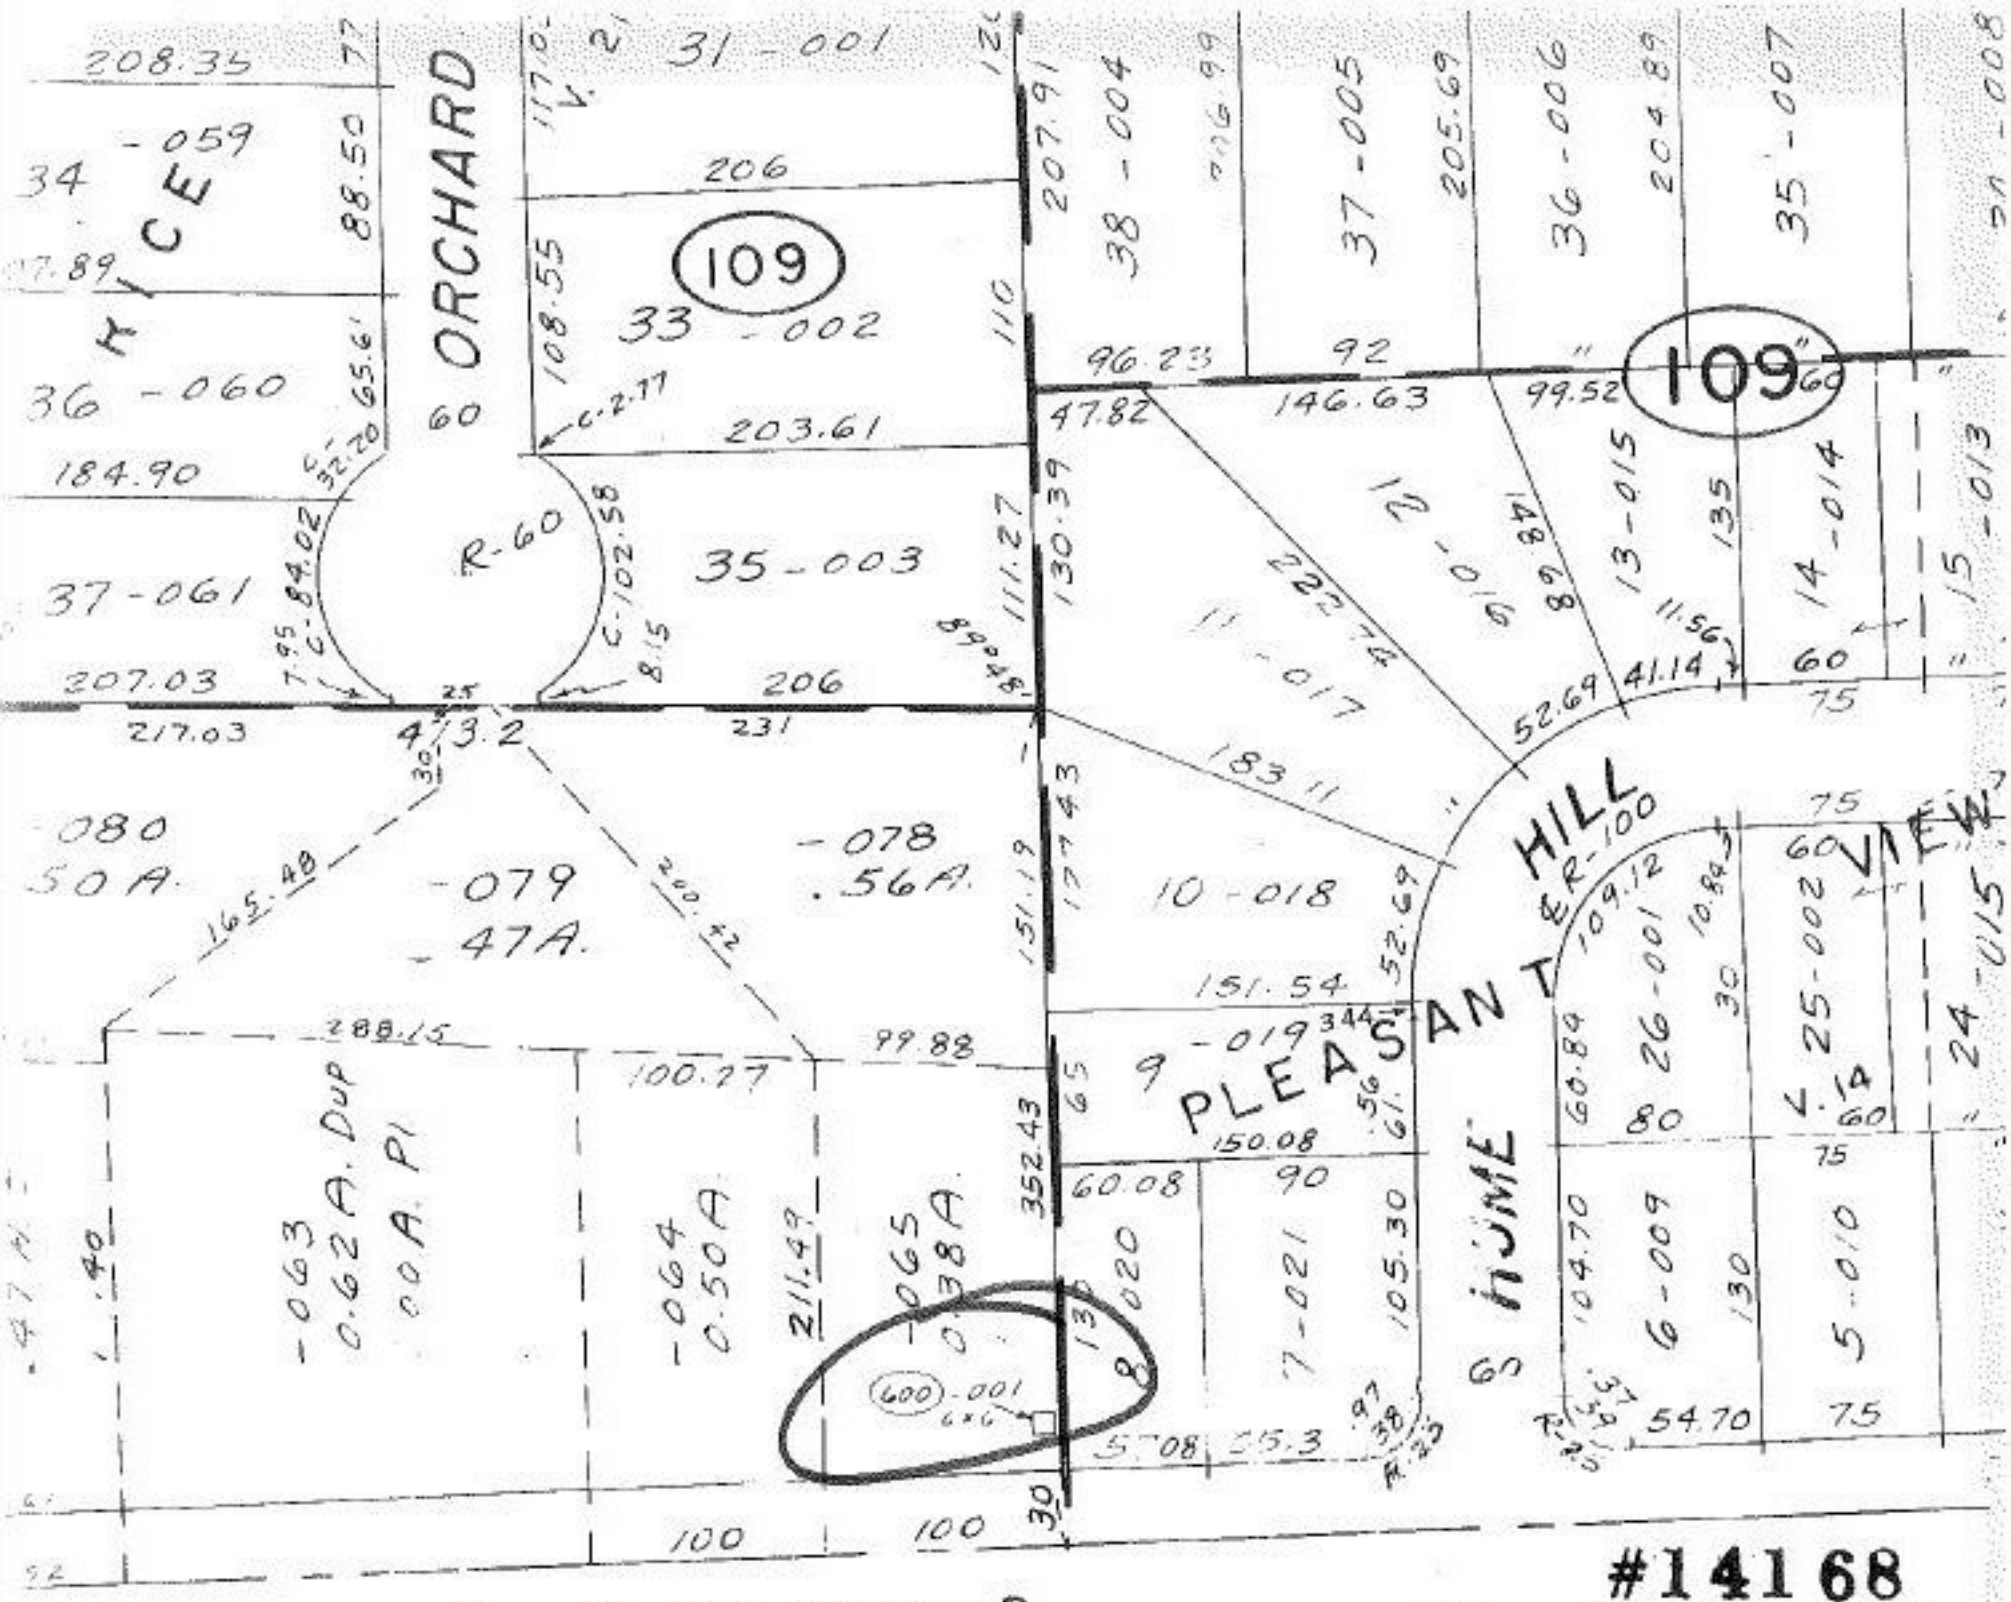
208.35
34 -059
36 -060
37 -061
207.03
217.03
184.90
88.50
65.6'
32.20
7.95
84.02
25
213.2
30
165.48
207.89
117.0
V. 21
206
108.55
203.61
207.91
38 -004
37 -005
36 -006
35 -007
205.69
204.89
96.23
92
99.52
146.63
47.82
109
33 -002
35 -003
R-60
ORCHARD
HYICE
C-2.77
C-102.58
8.15
206
231
111.27
130.39
89°48'
89.84'
13-015
14-014
15-013
135
60
75
11.56
41.14
52.69
183.11
11 -017
10 -018
9 -019
344
PLEASANT HILL
R-100
VIEW
109.12
60.84
80
26-001
25-002
30
10.89
60
75
151.54
151.19
127.43
52.69
288.15
99.88
100.27
352.43
65
61.56
150.08
60.08
90
105.30
104.70
54.70
6-009
5-010
130
-080
50 A.
-079
47A.
-078
.56A.
-063
0.62A. Dup
00A. Pl
-064
0.50A.
-065
38A.
211.49
600-001
020
17-021
S 70° 55.3
R.23
R.21
100
100
30
SEE 5-00-037-B
APR 27 1981
#14168
APPROVED
LORAIN CO.
MAP DEPT.
DATE 4-27-81
PAGE 5-00-038-B
BY
VOID AFTER
E ly PT. LOT 38