#14168

APPROVED
LORAIN CO.
MAP DEPT.

DATE 4-27-81

PAGE 5-00-061-A

BY

VOID AFTER
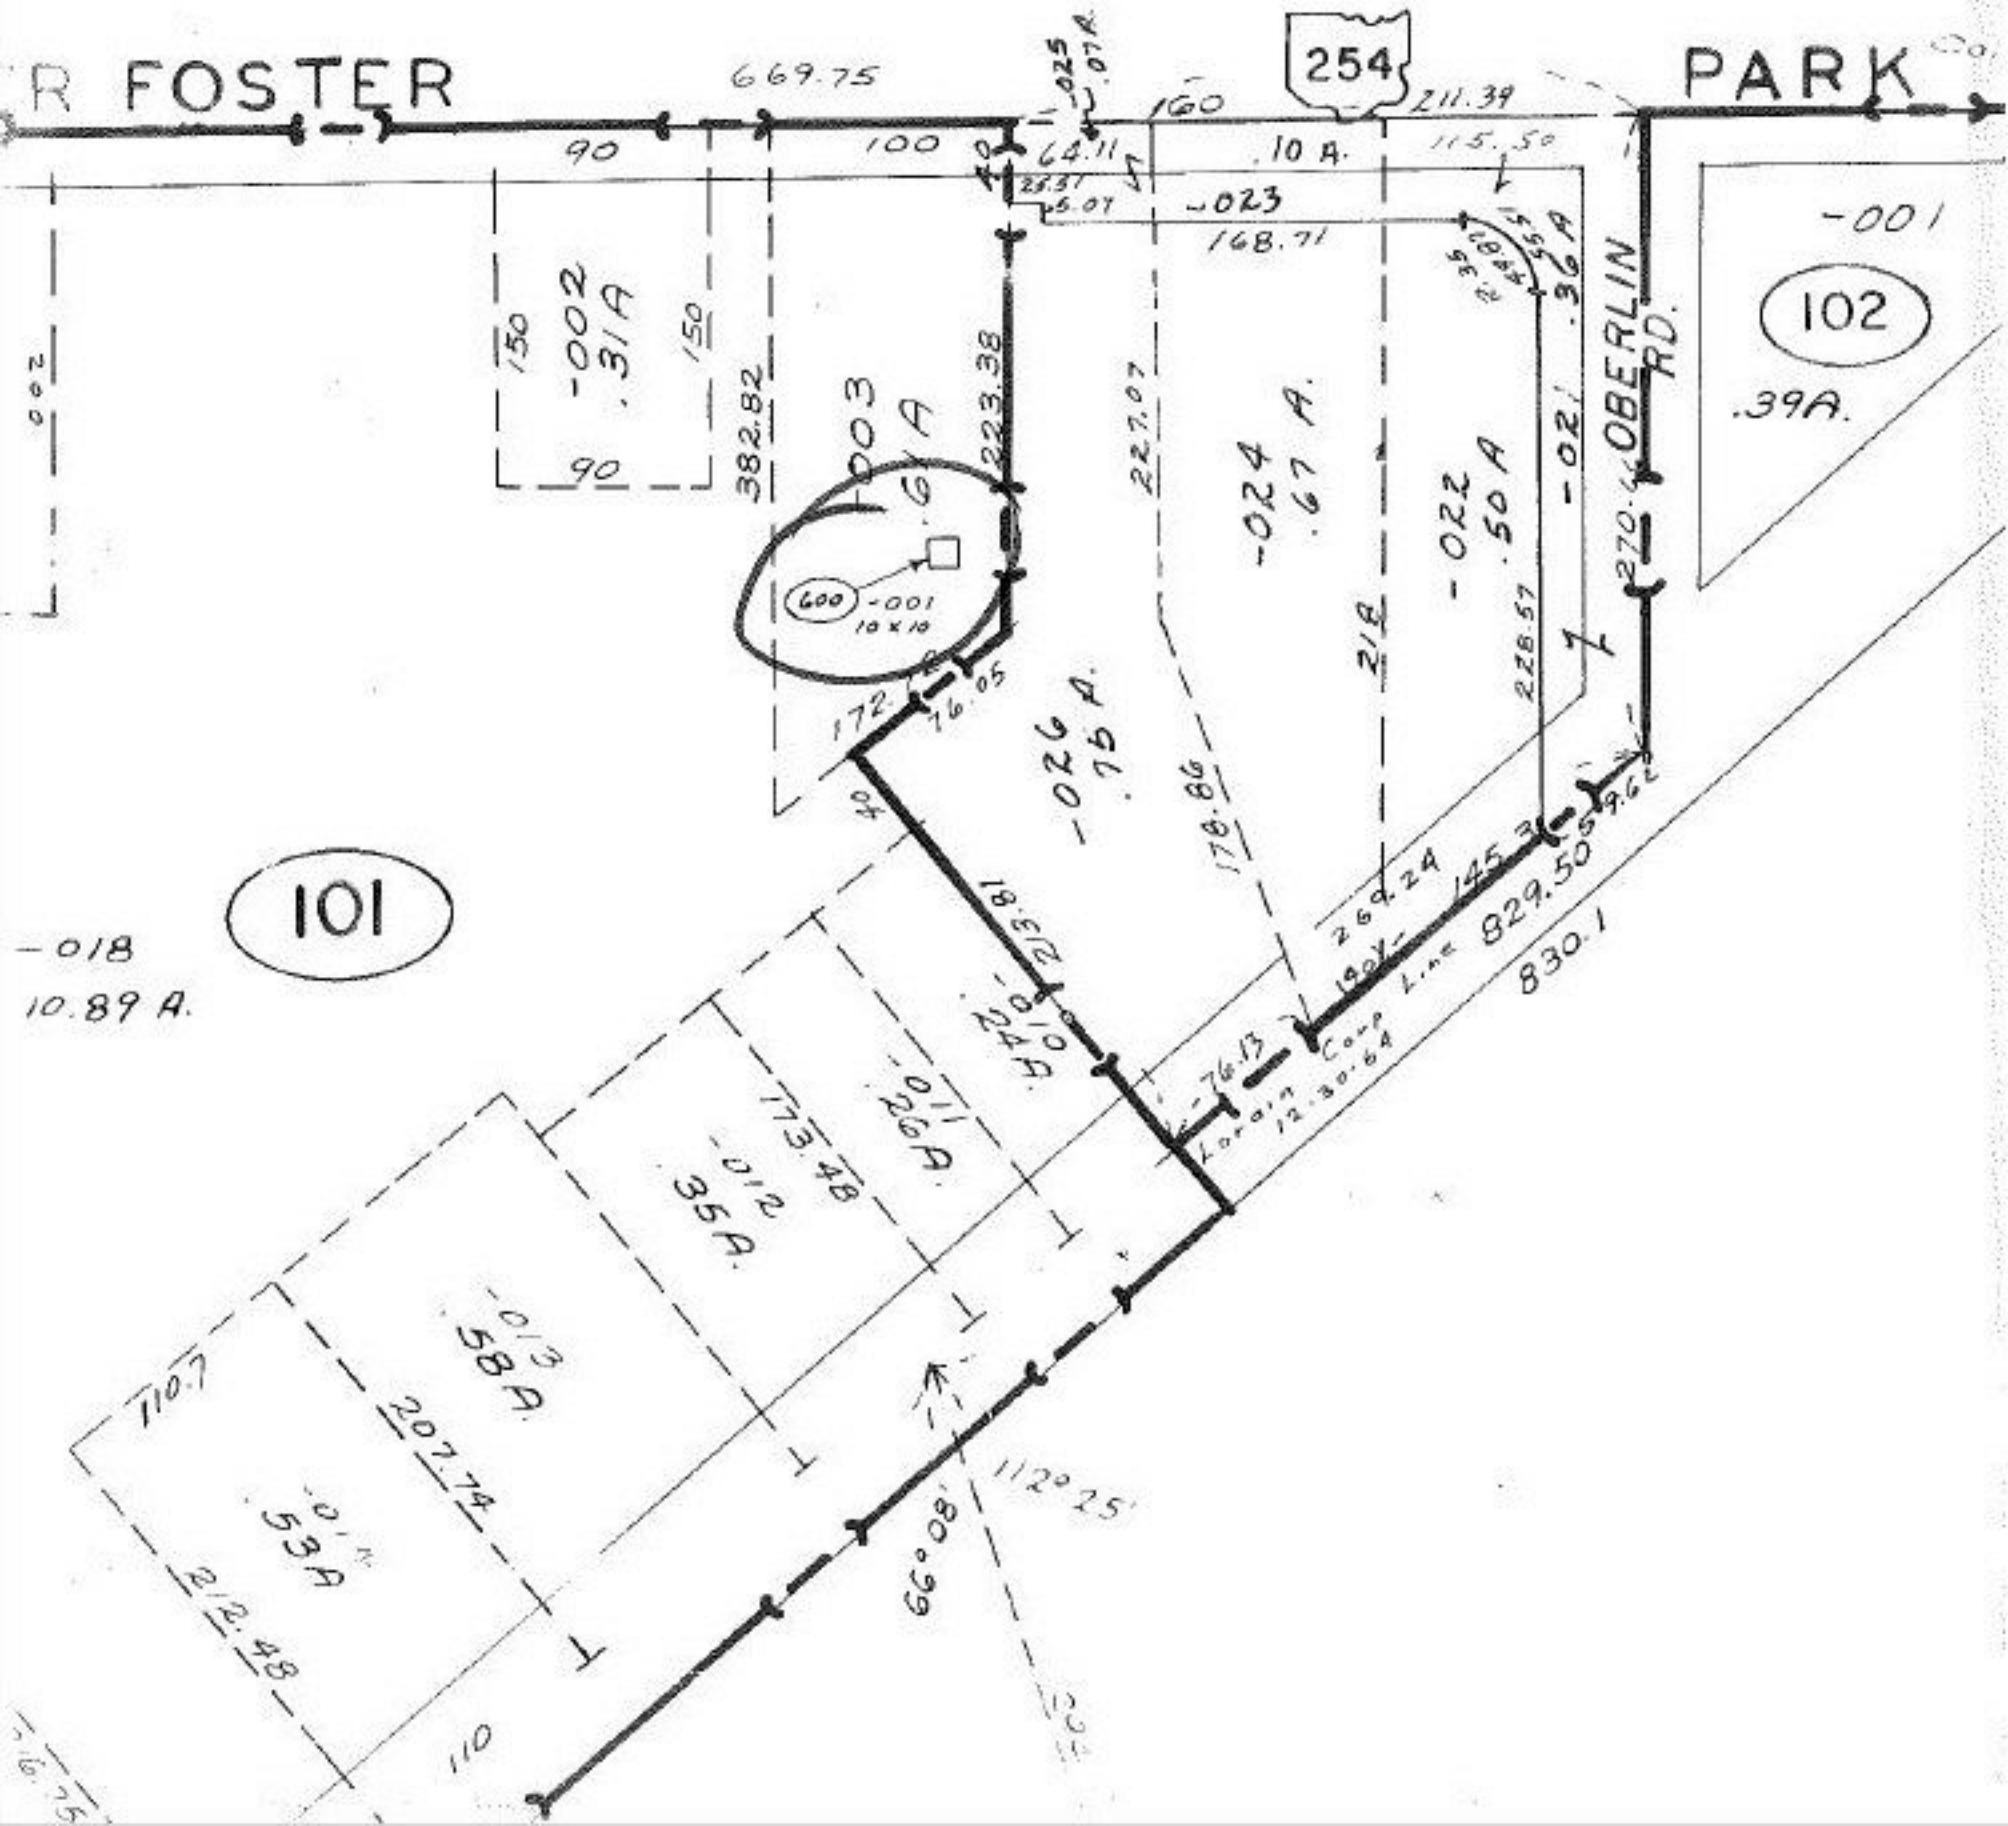
APR 27 1981