#14168

APR 27 1981
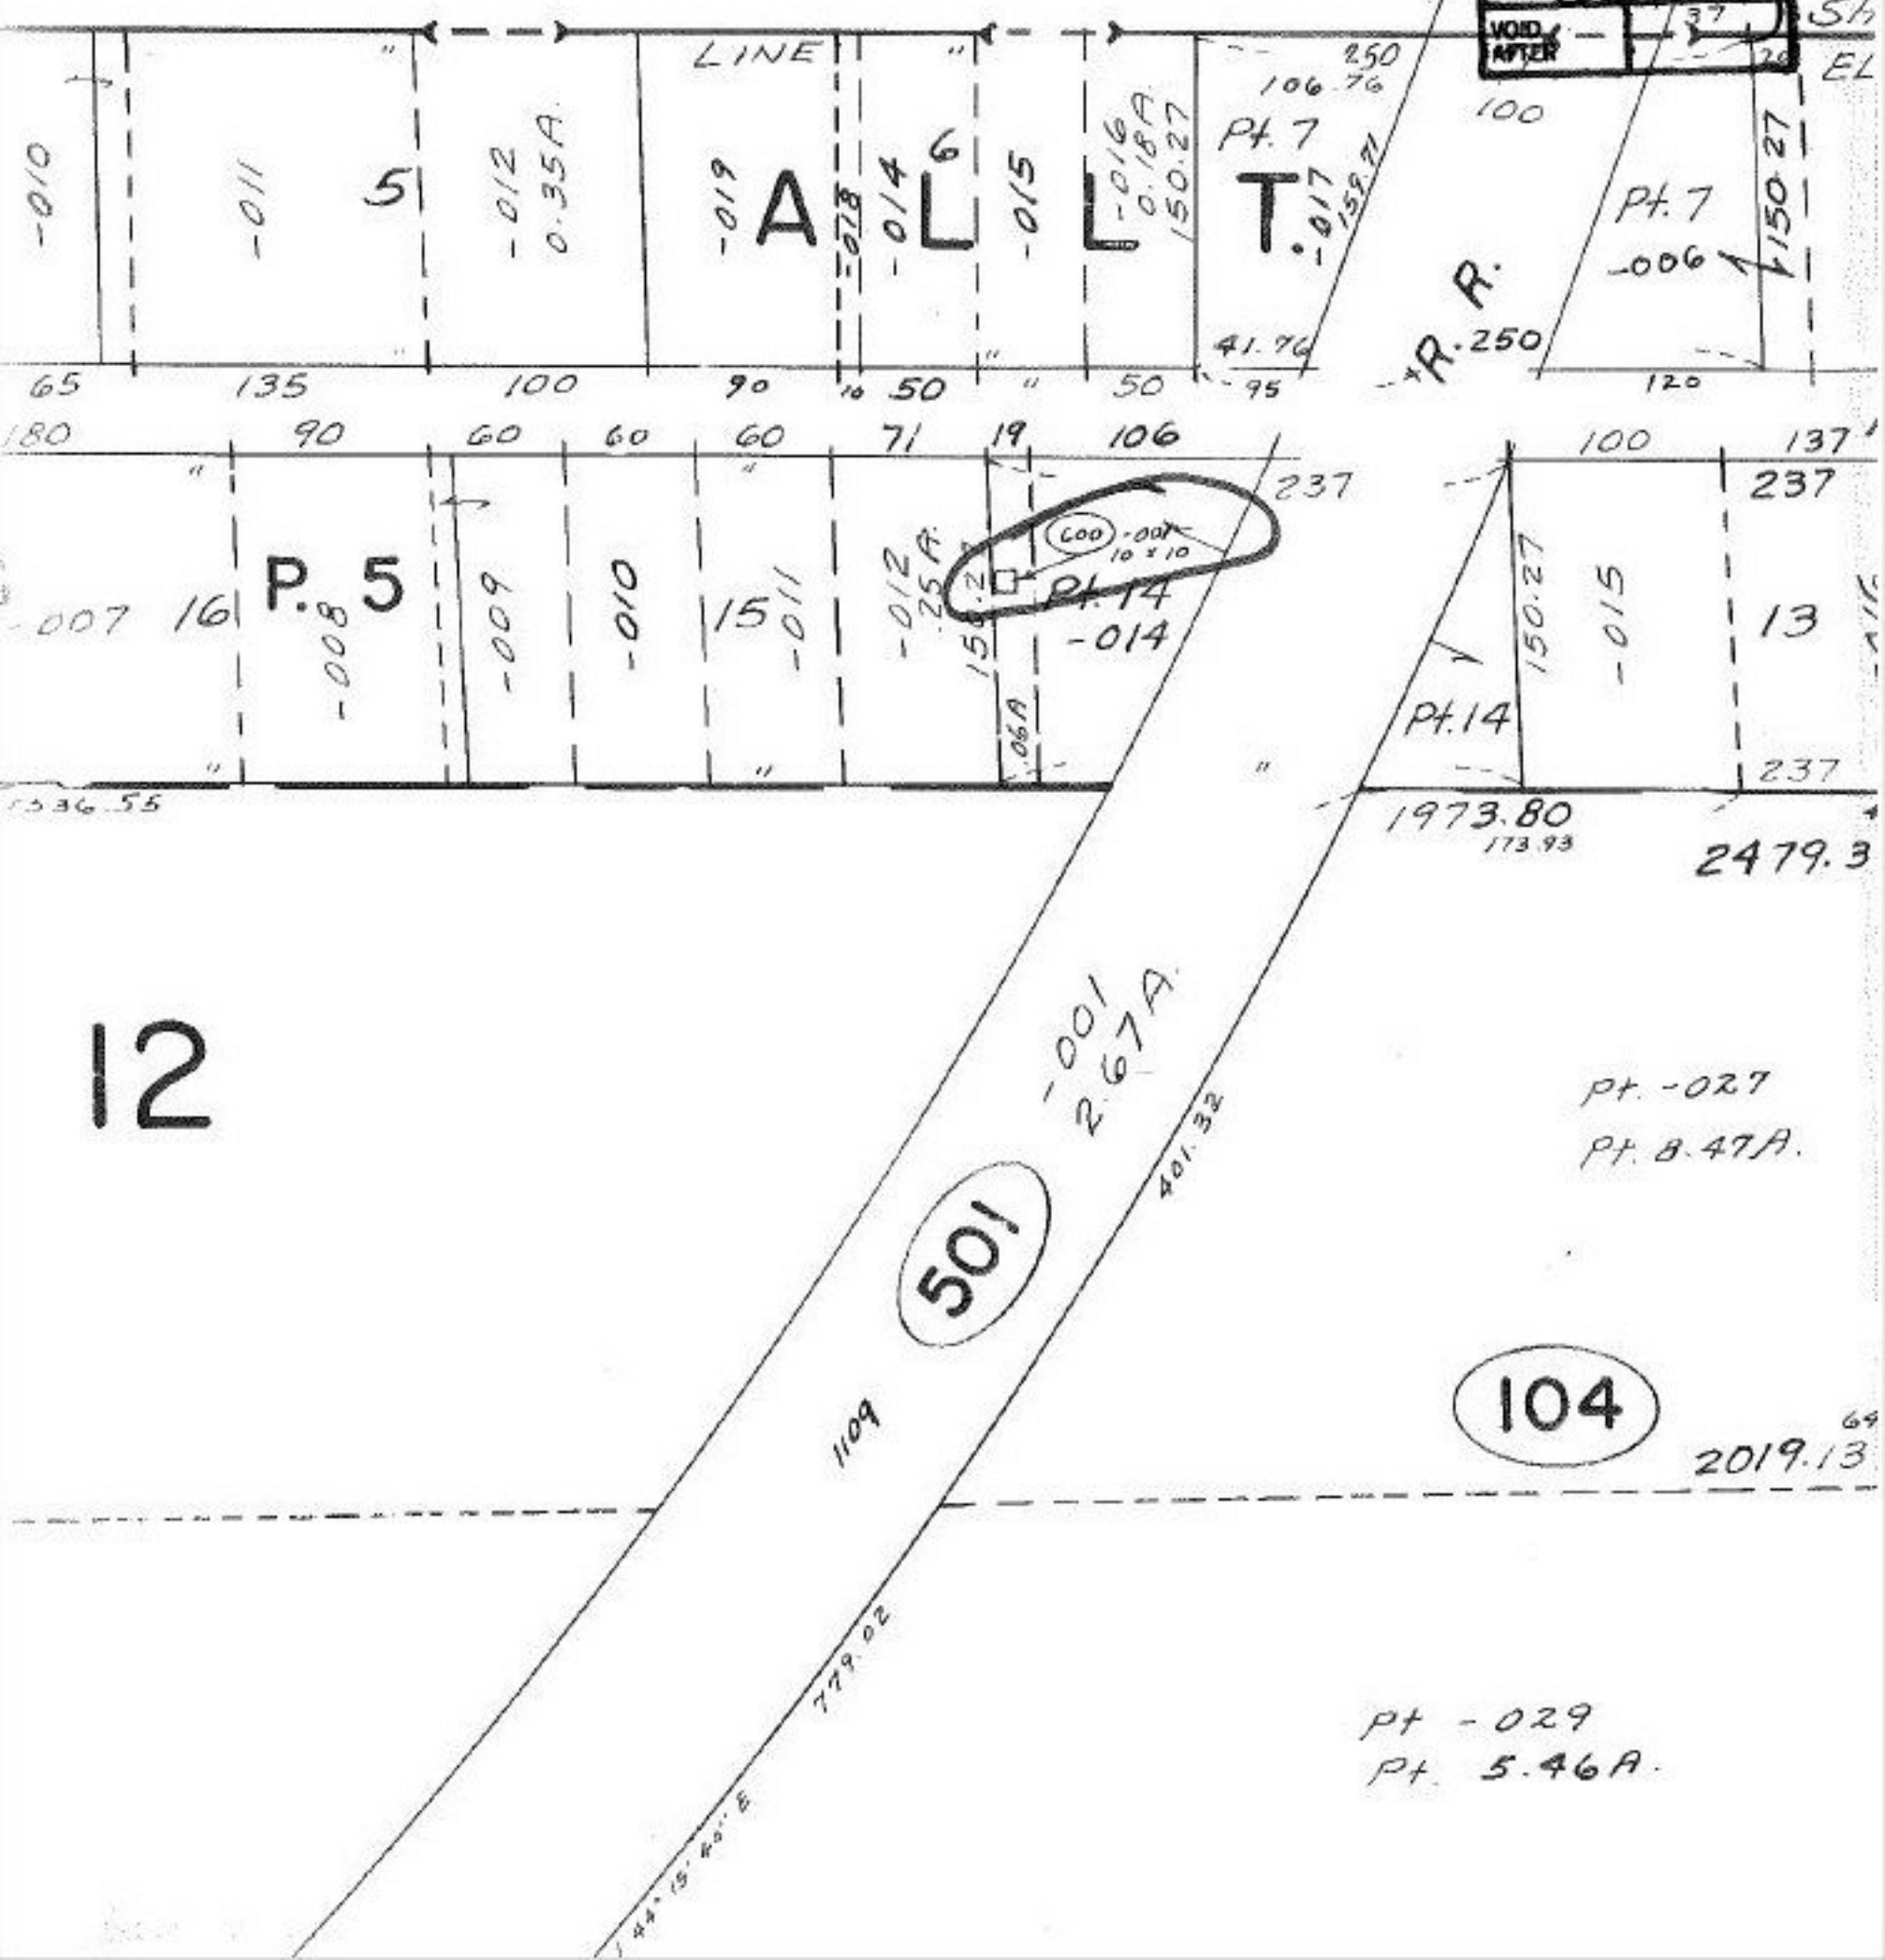
APPROVED
LORAIN CO.
MAP DEPT.
DATE 4-27-81
PAGE 6-11
BY
VOID AFTER