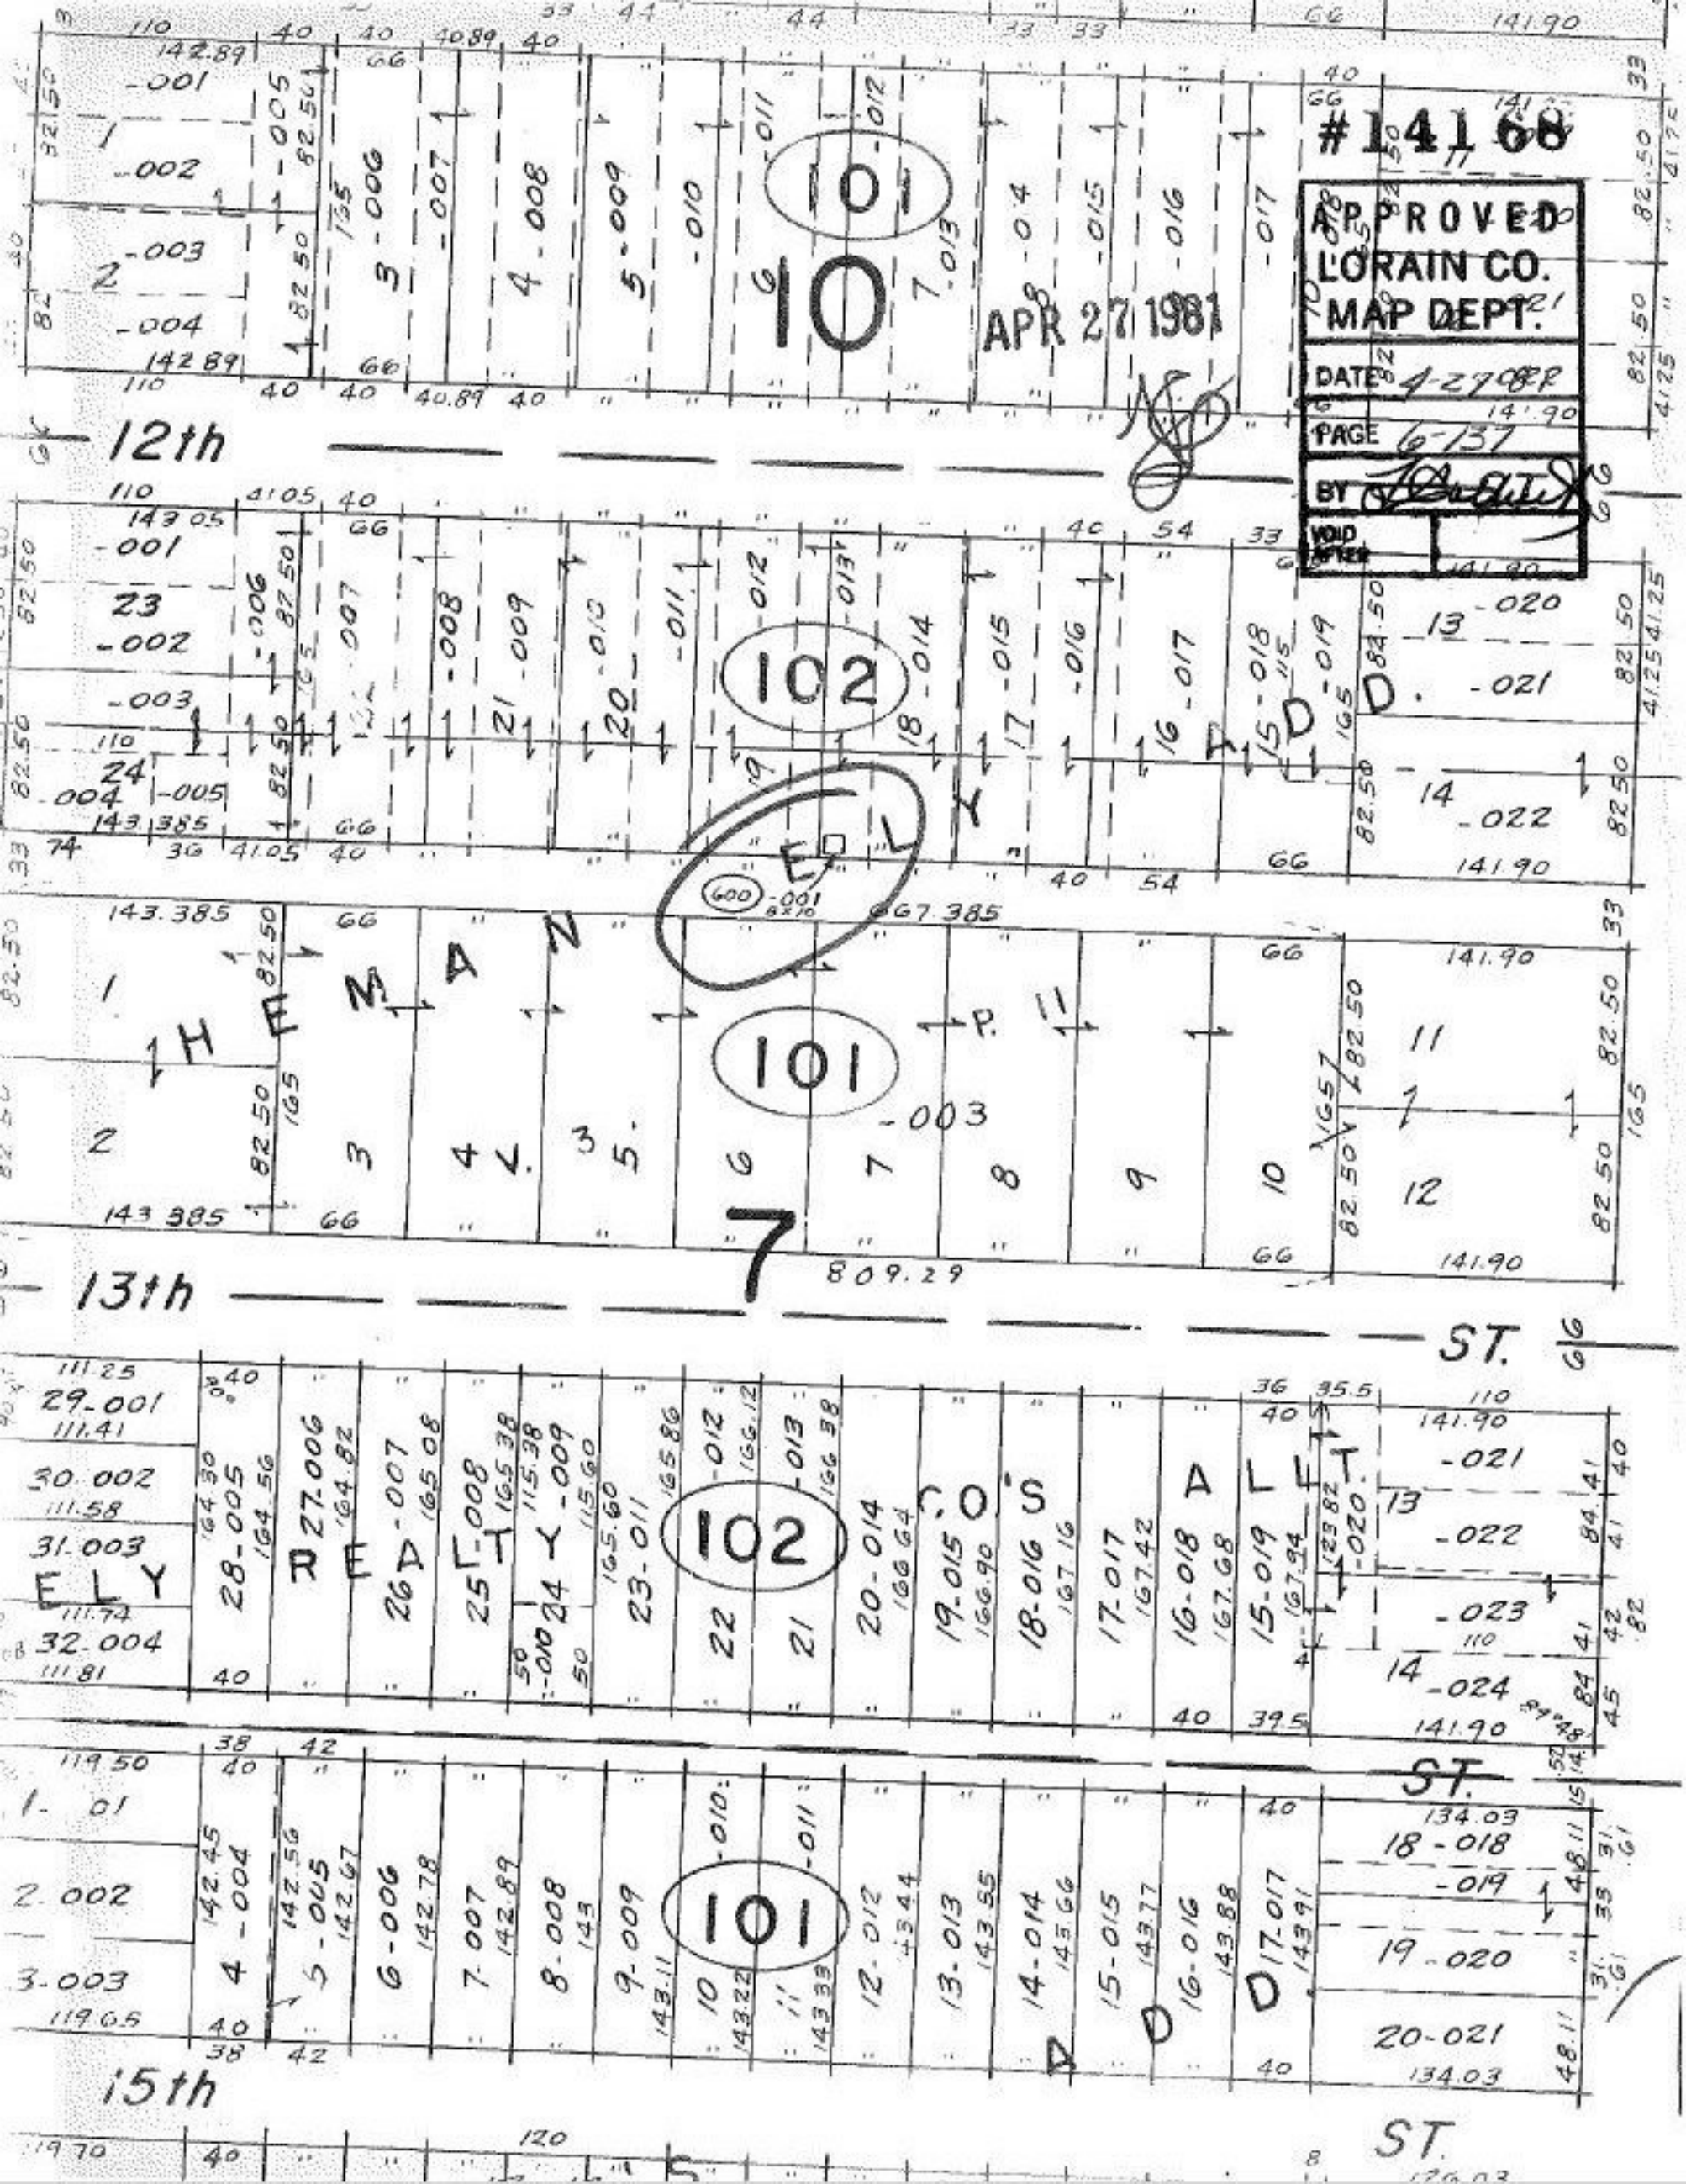

#14168
APPROVED
LORAIN CO.
MAP DEPT.
DATE 4-27-82
PAGE 6-137
BY
VOID AFTER
APR 27 1981
12th
13th
15th
ST.
101
102
7
HEMAN ELY ADD.
CO'S ALLT.
REALTY
ELY
ADD