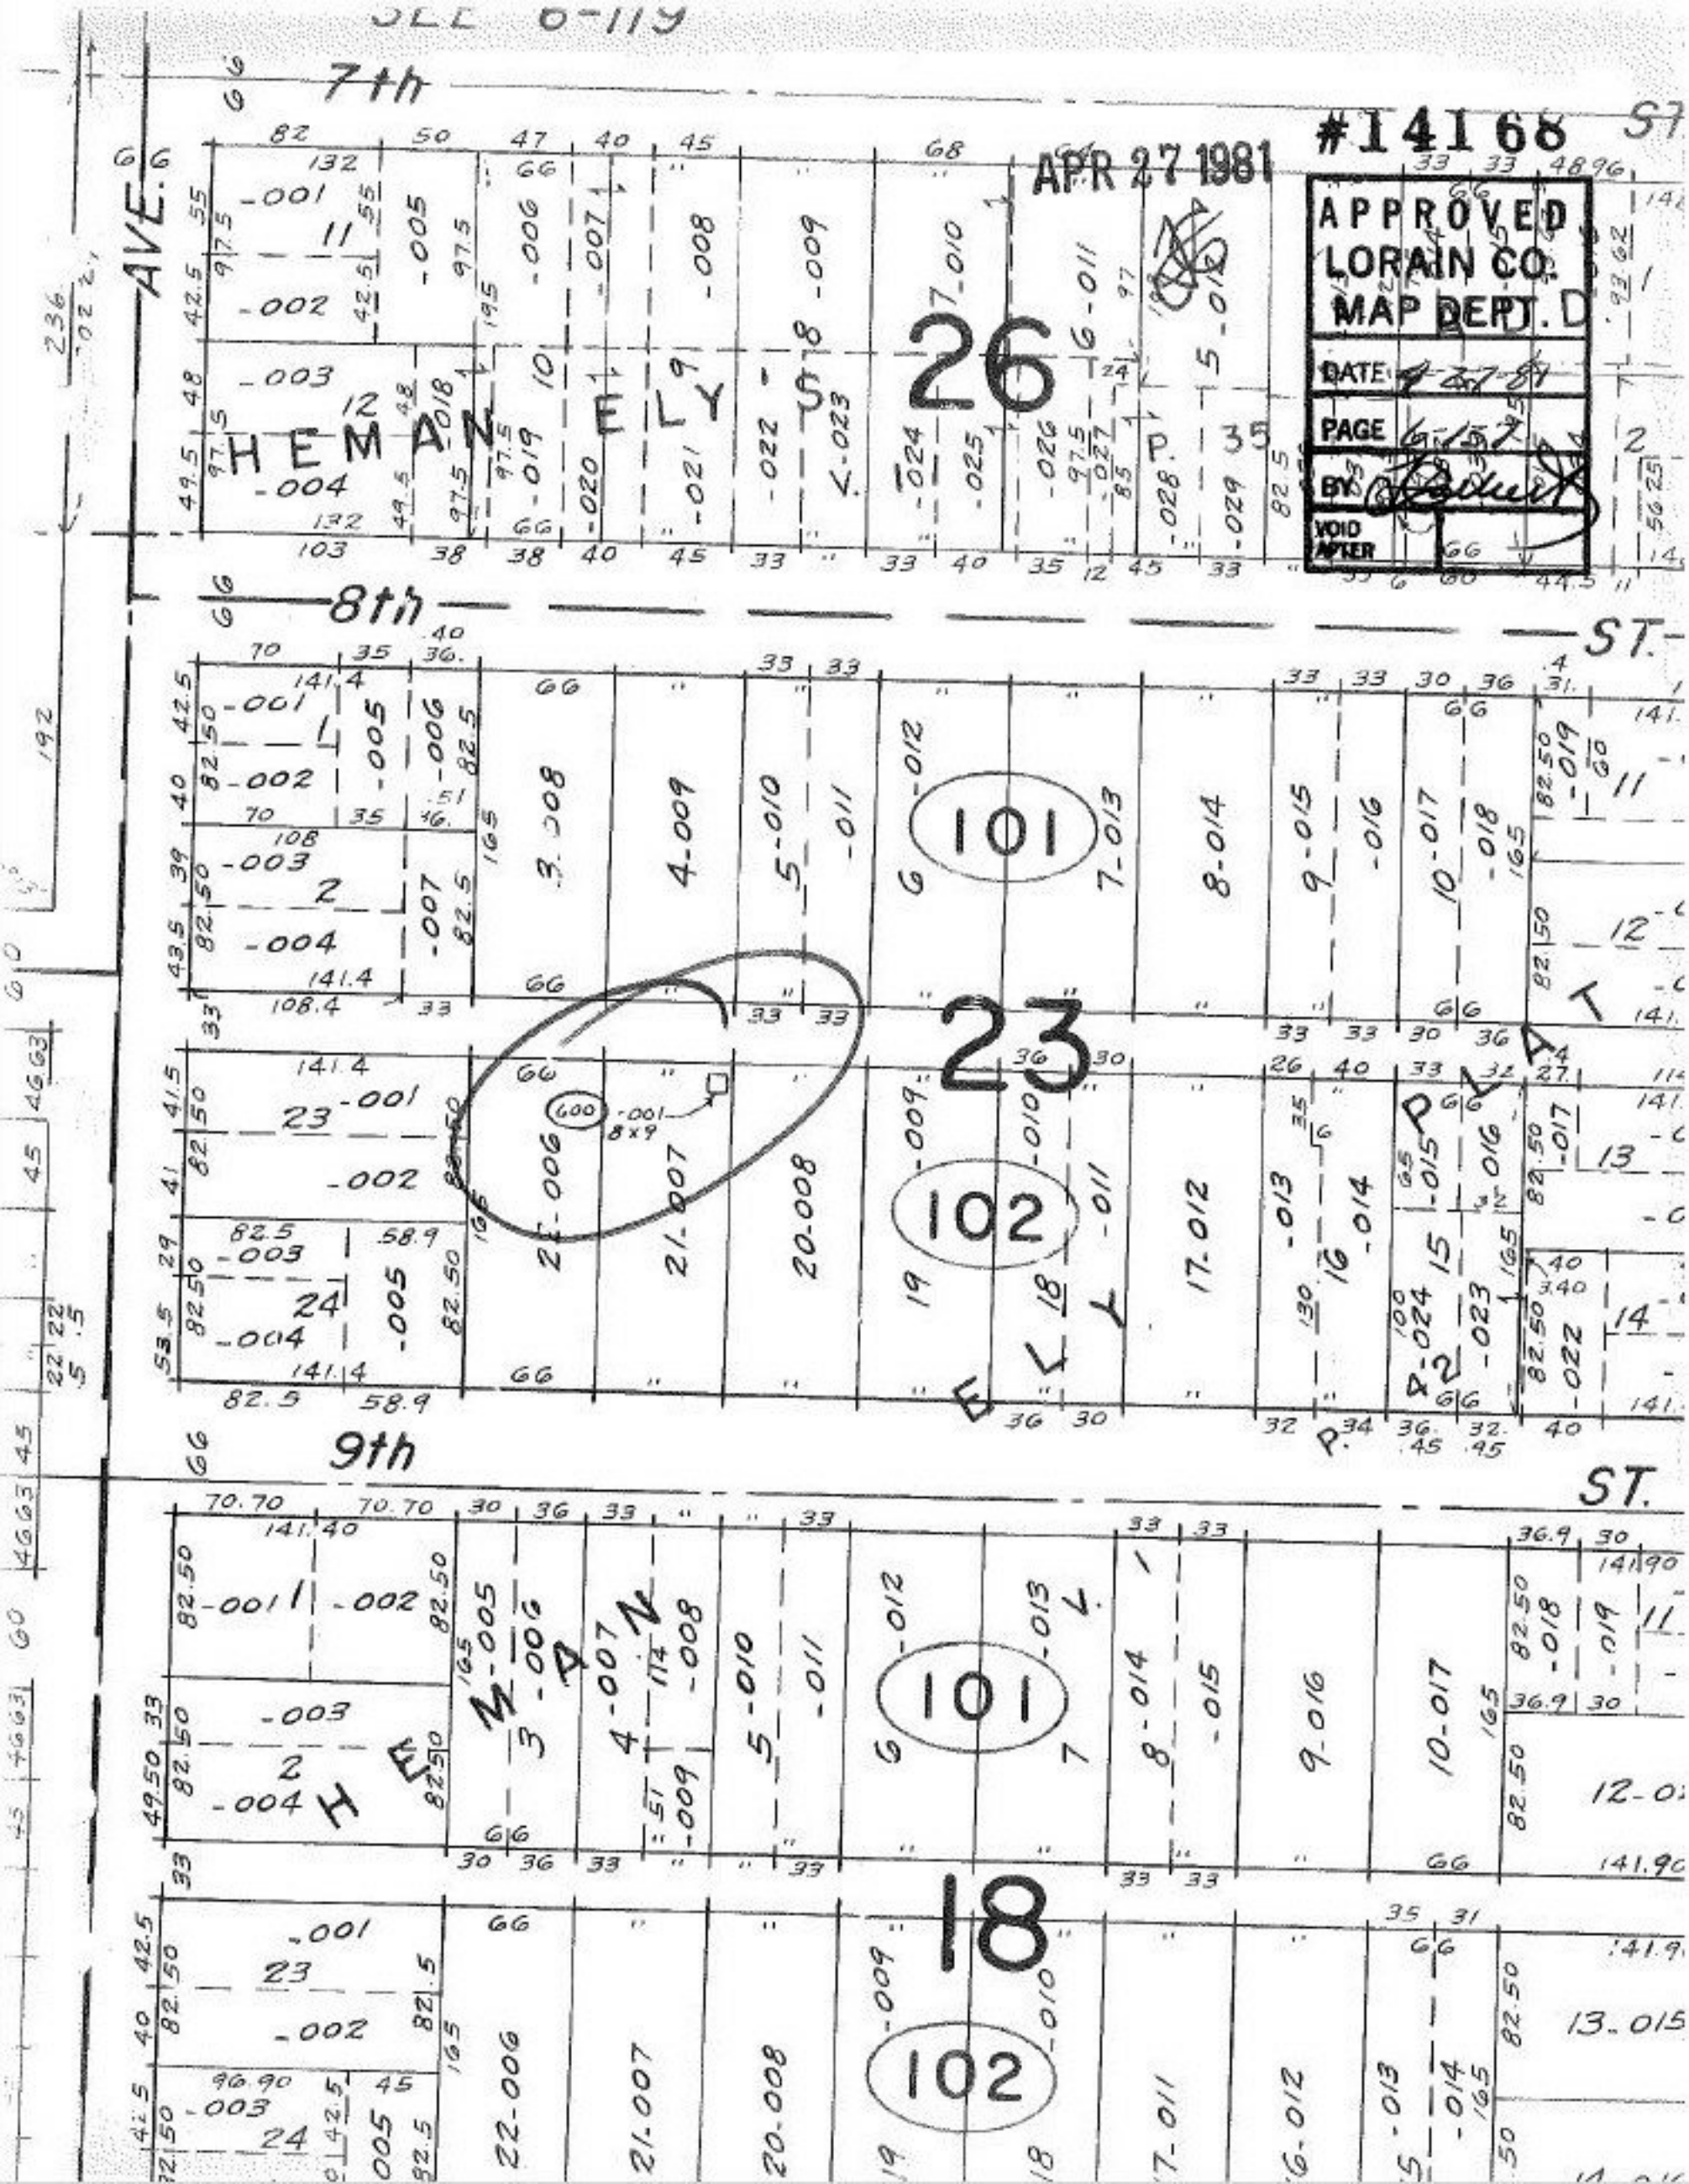
7th
8th
9th
ST.
AVE.
HEMAN
26
101
23
102
18
APR 27 1981
#14168
APPROVED
LORAIN CO.
MAP DEPT.
DATE
PAGE
BY
VOID AFTER