#14168

APPROVED
LORAIN CO.
MAP DEPT.
DATE 4-27-81
PAGE 2-01-006 B
BY
VOID AFTER
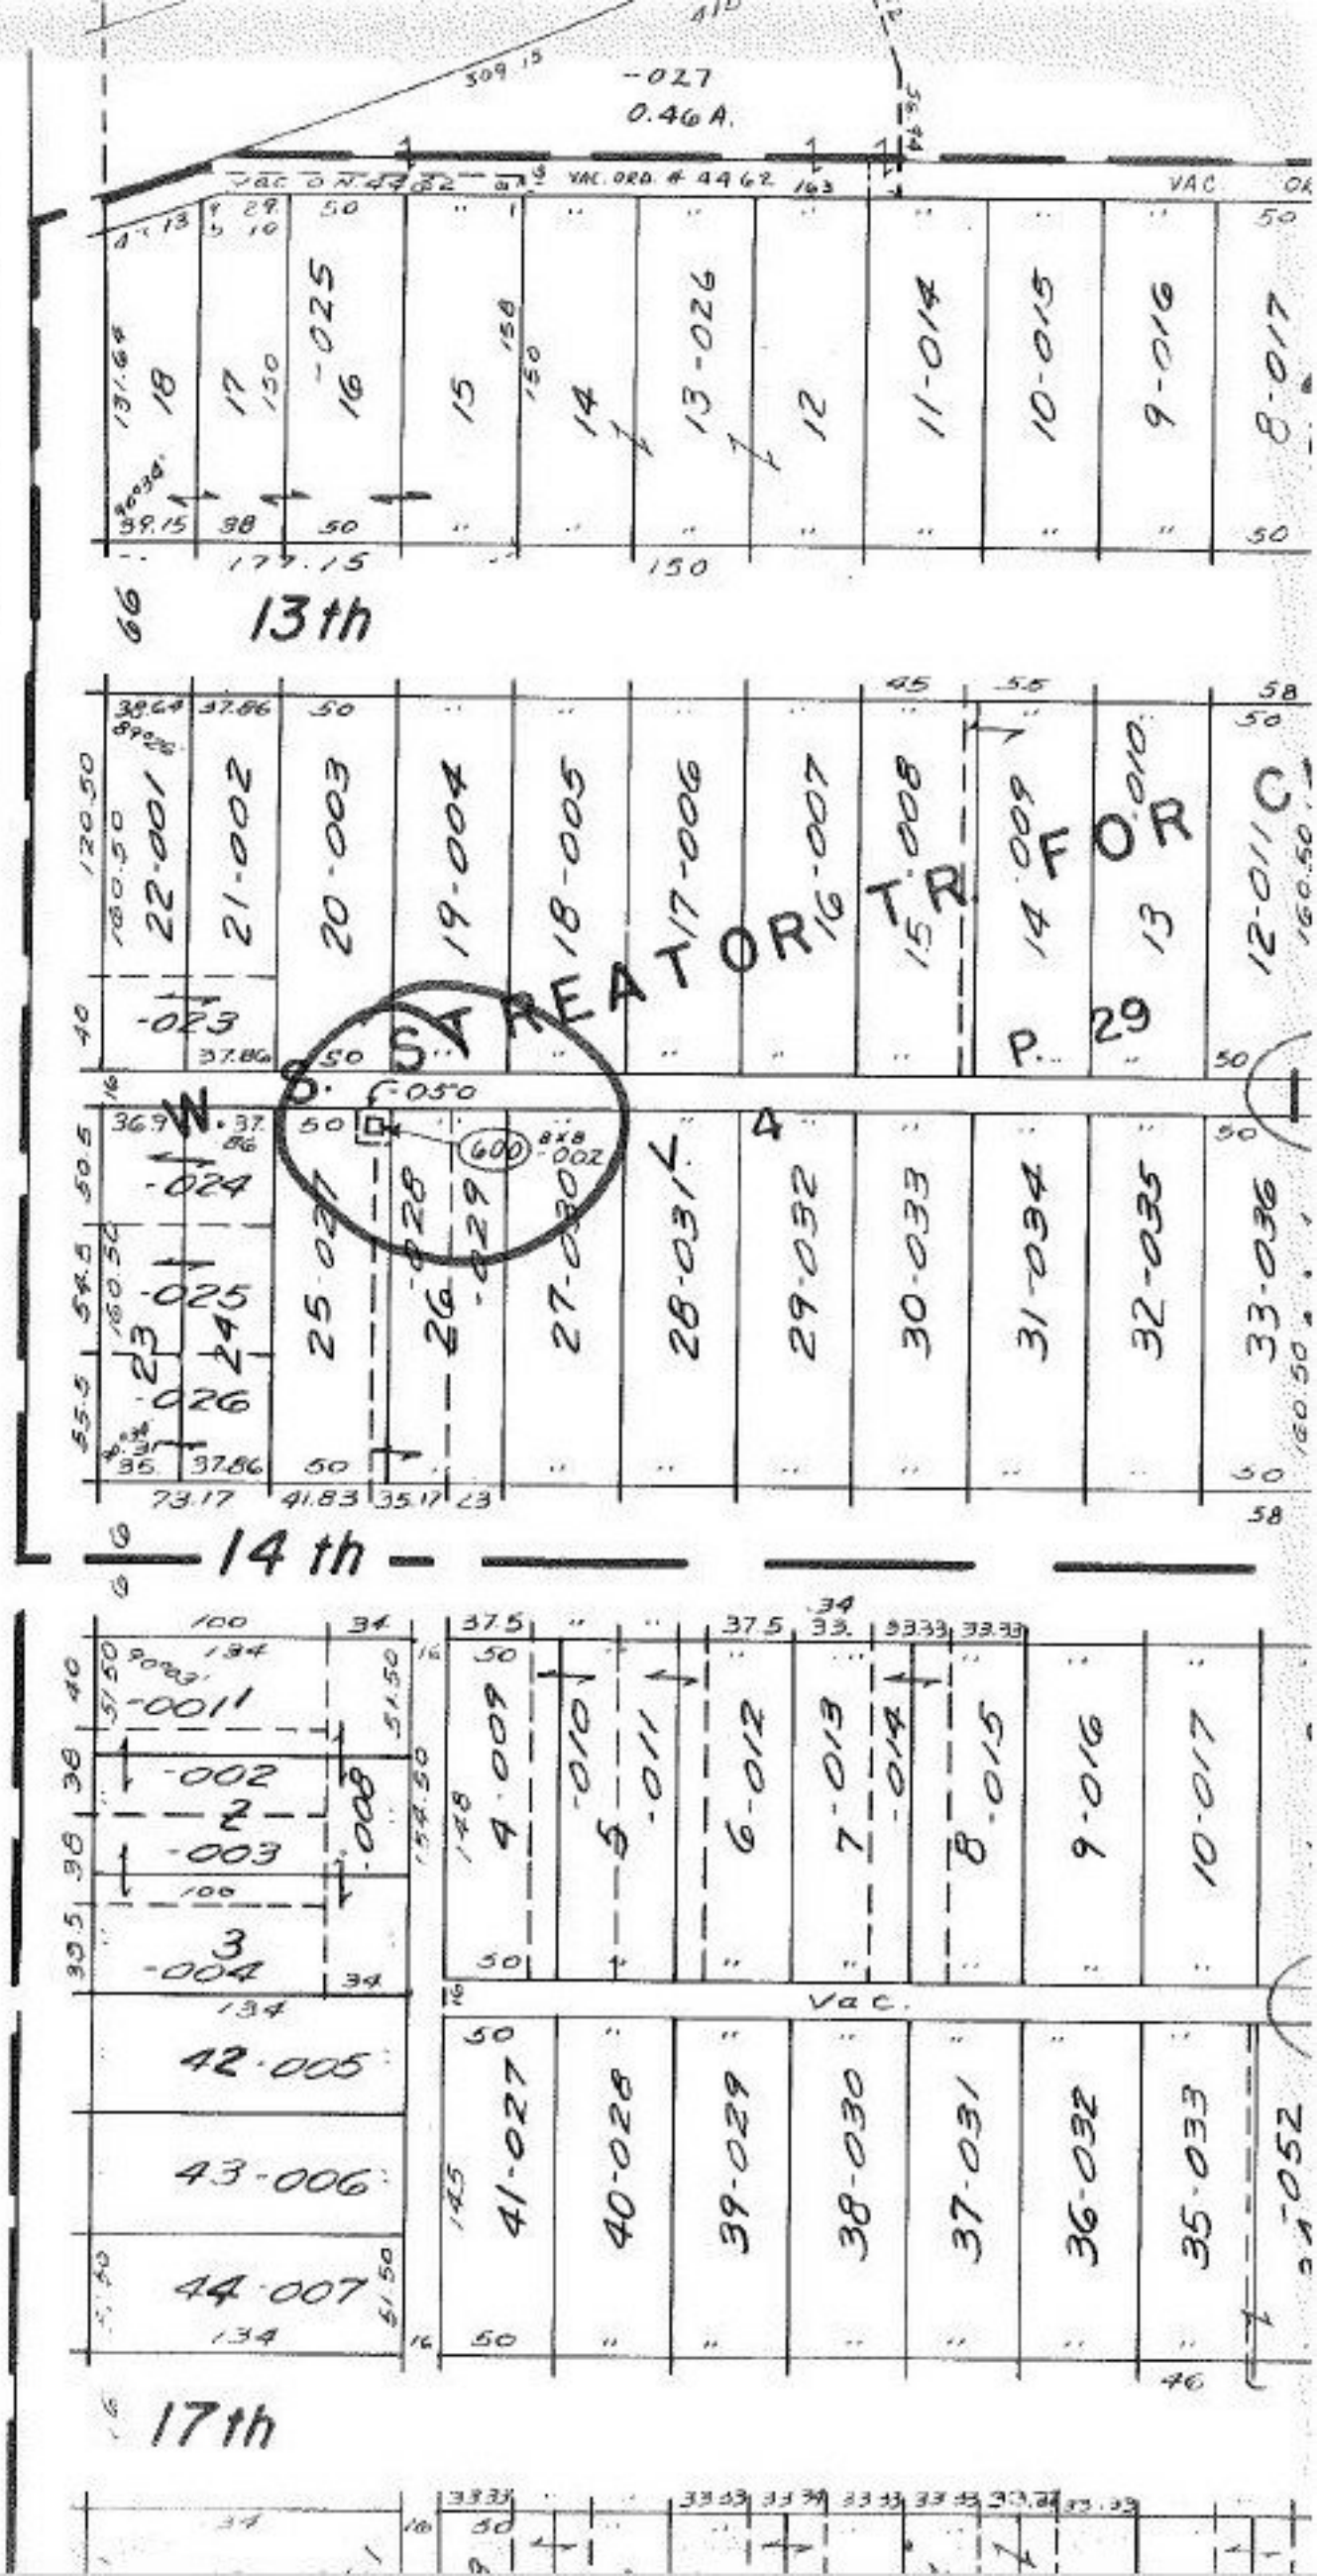
APR 27 1981