#14168

APR 27 1981

APPROVED
LORAIN CO.
MAP DEPT.
DATE 4-27-81
PAGE 9-00-087-A
BY
VOID AFTER

SEE 9-00-077-A
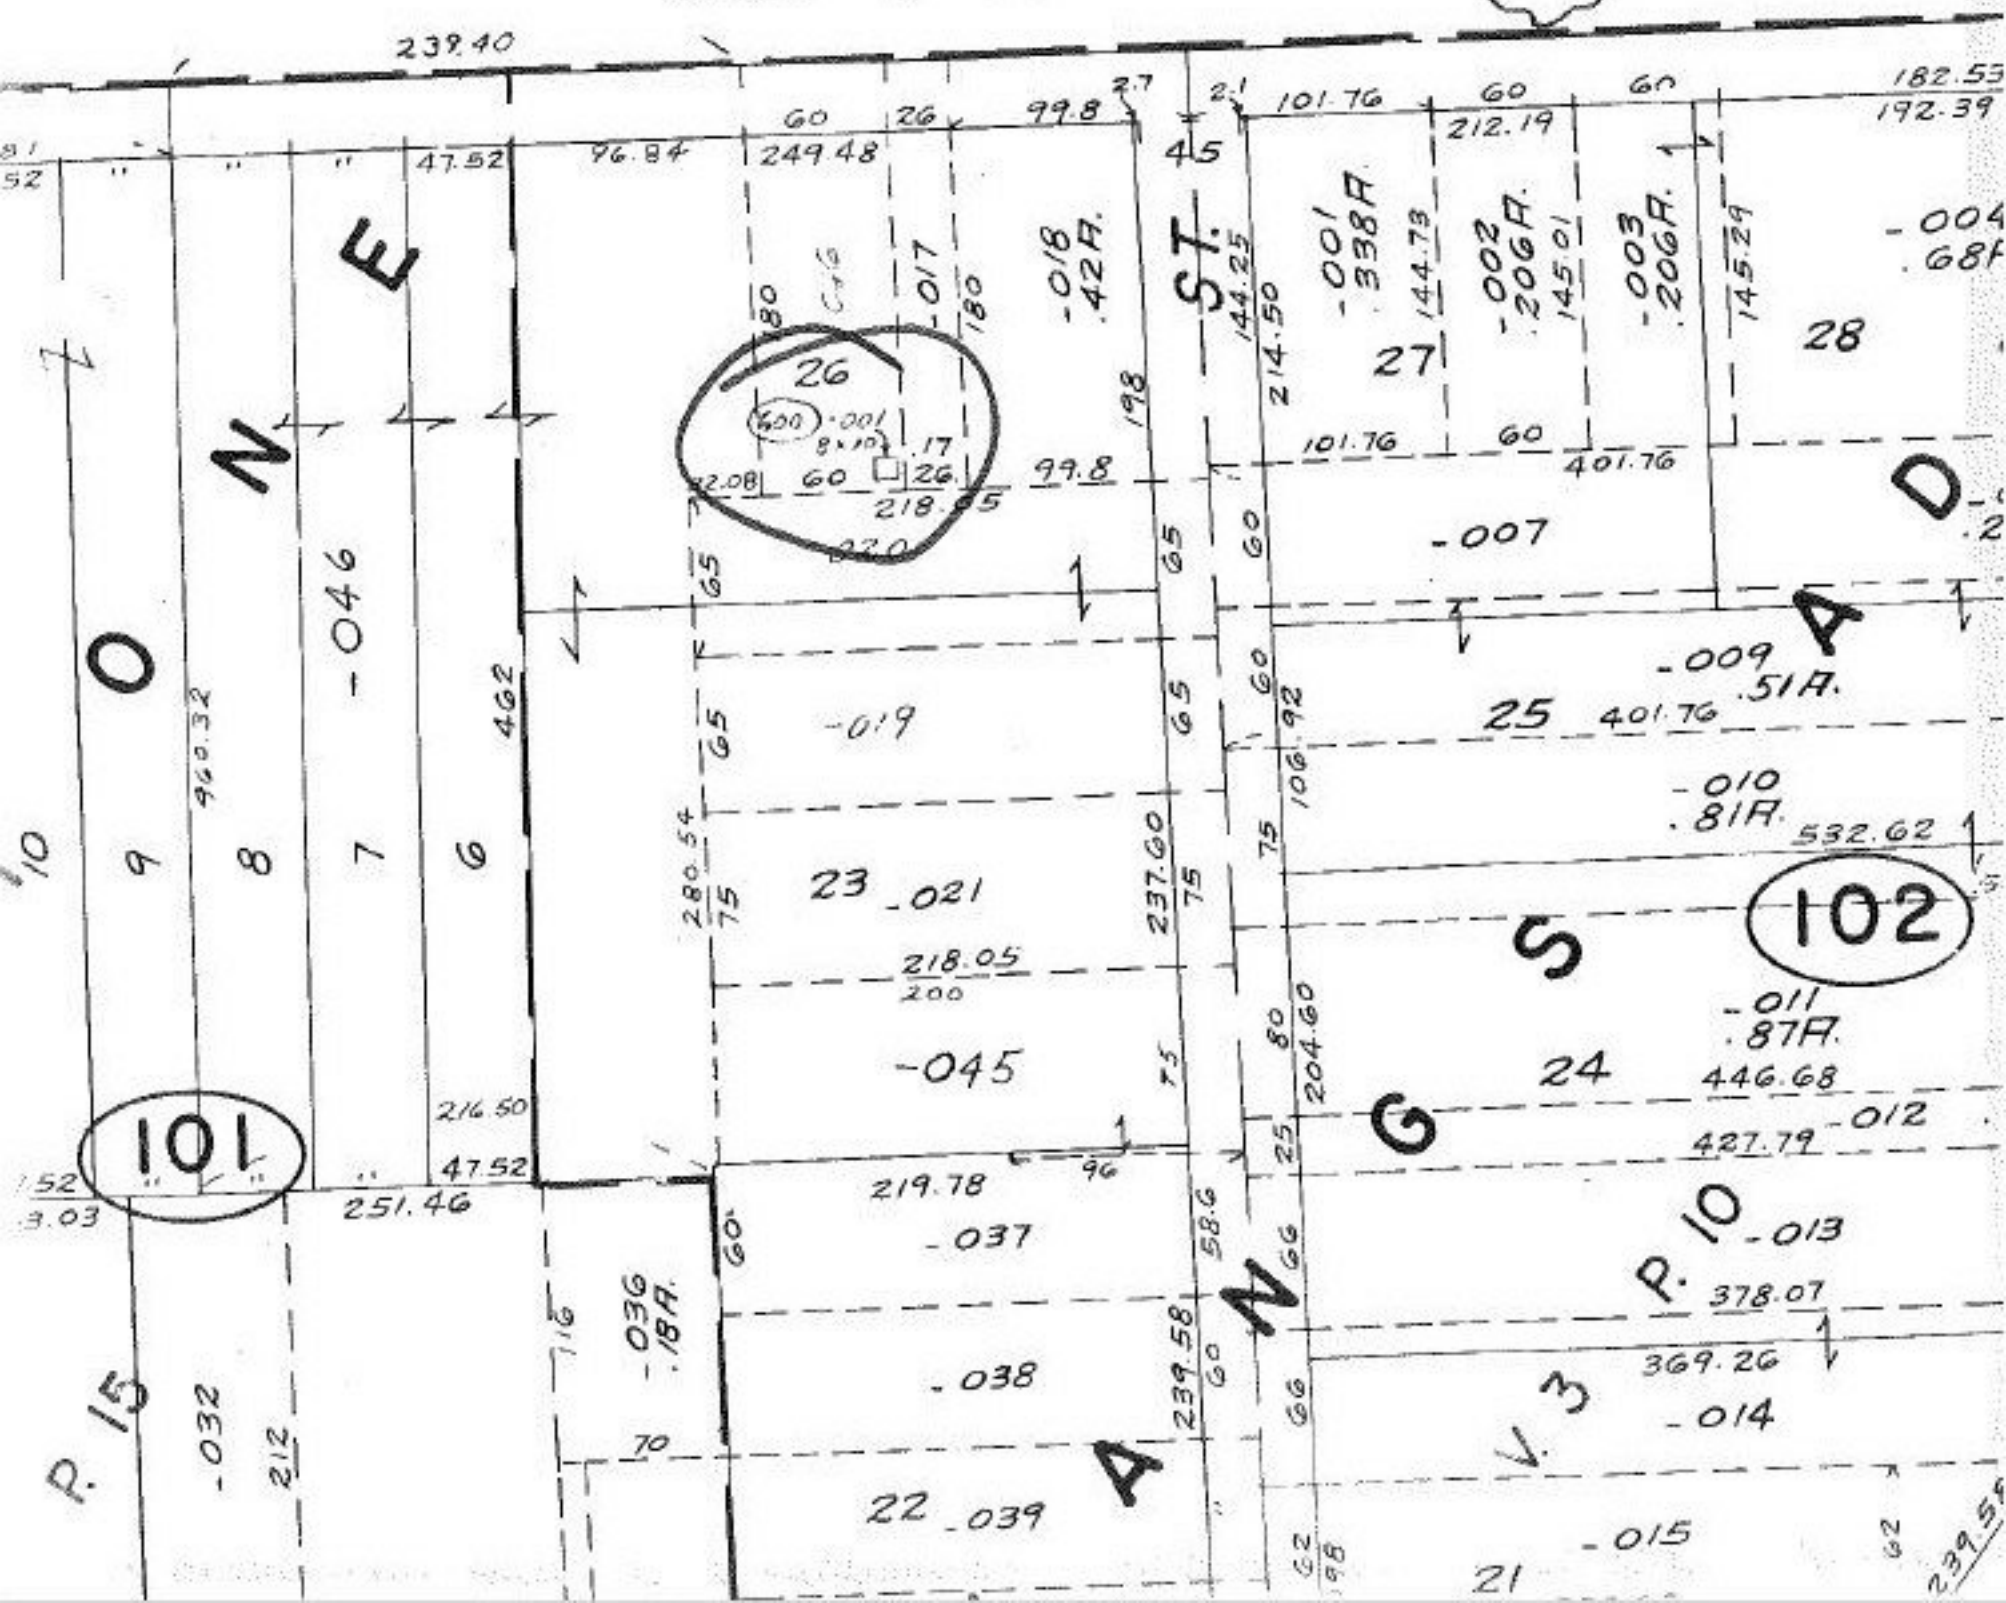
10