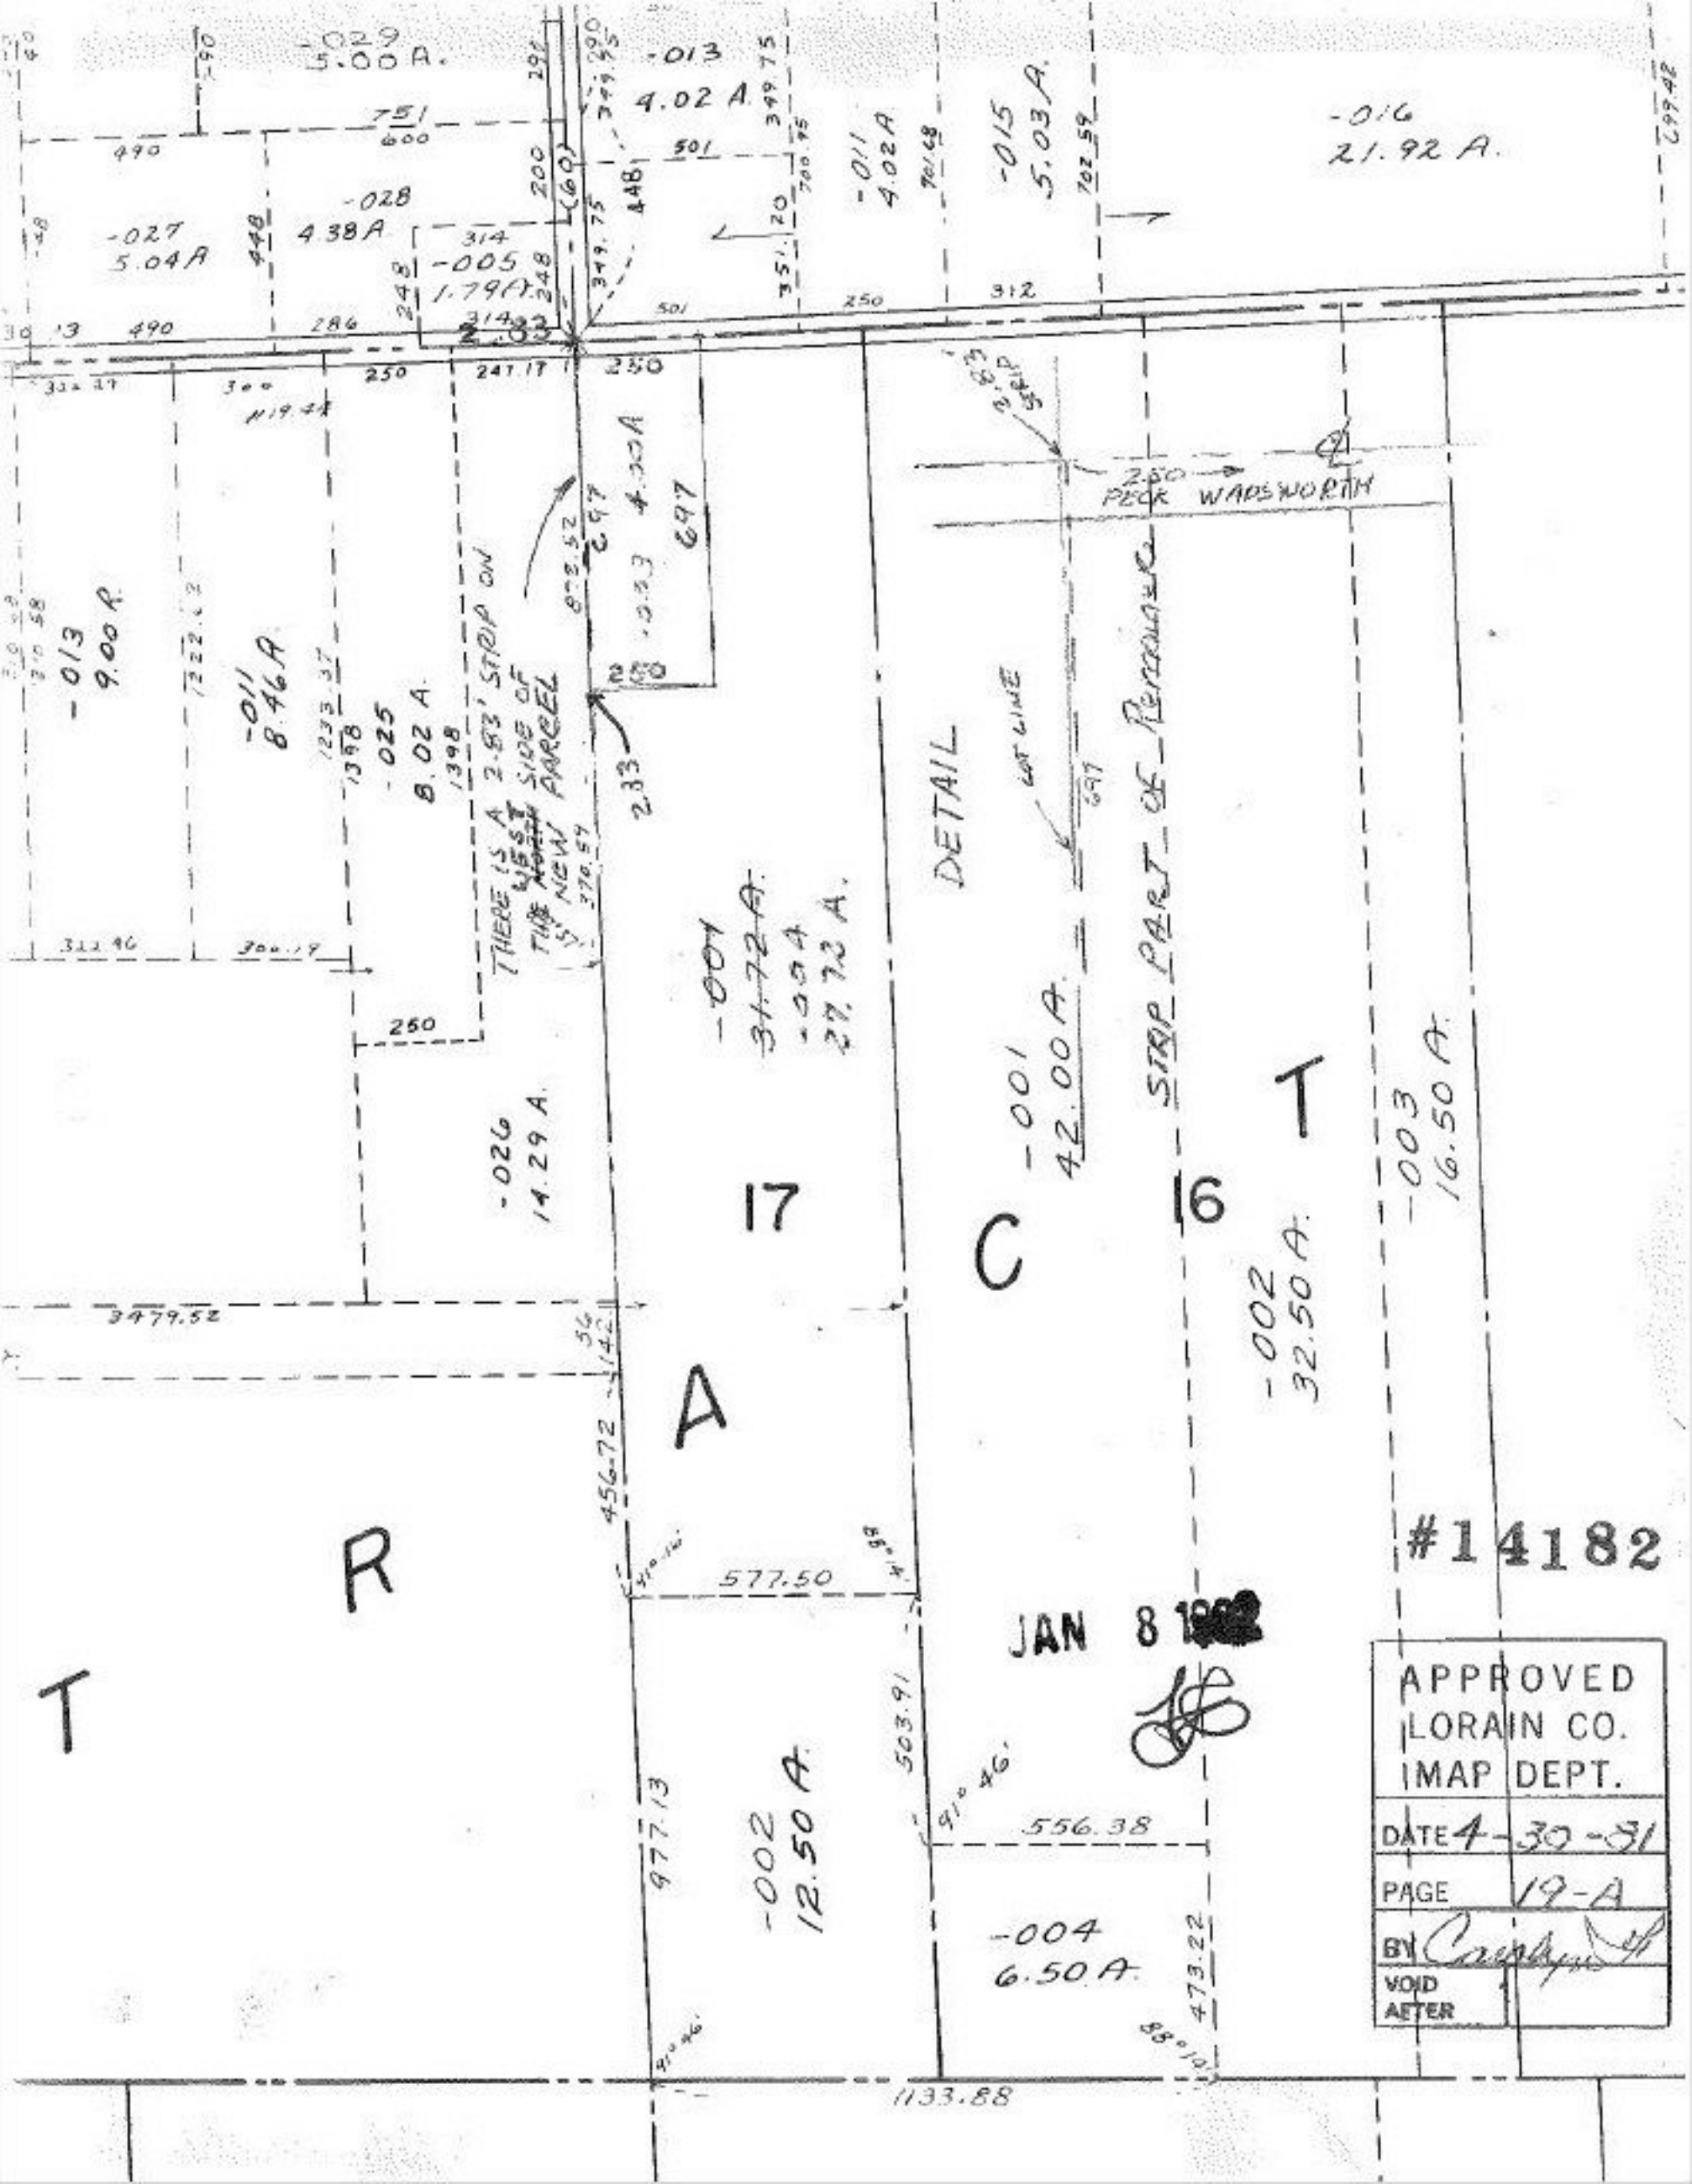

-029
5.00 A.
-013
4.02 A.
-016
21.92 A.
-011
4.02 A
-015
5.03 A.
-028
4.38 A
-027
5.04 A
-005
1.79 A.
-013
9.00 R.
-011
8.46 A
-025
8.02 A.
THERE IS A 2.83' STRIP ON THE WEST SIDE OF NEW PARCEL
-001
31.72 A.
-004
27.72 A.
-026
14.29 A.
DETAIL
LOT LINE
STRIP PART OF Remainder
PECK WADSWORTH
-001
42.00 A.
-002
32.50 A.
-003
16.50 A.
17
16
C
A
T
R
T
-002
12.50 A.
-004
6.50 A.
577.50
556.38
1133.88
3479.52
456.72
503.91
977.13
473.22
#14182
JAN 8 1982
APPROVED
LORAIN CO.
MAP DEPT.
DATE 4-30-81
PAGE 19-A
BY
VOID AFTER