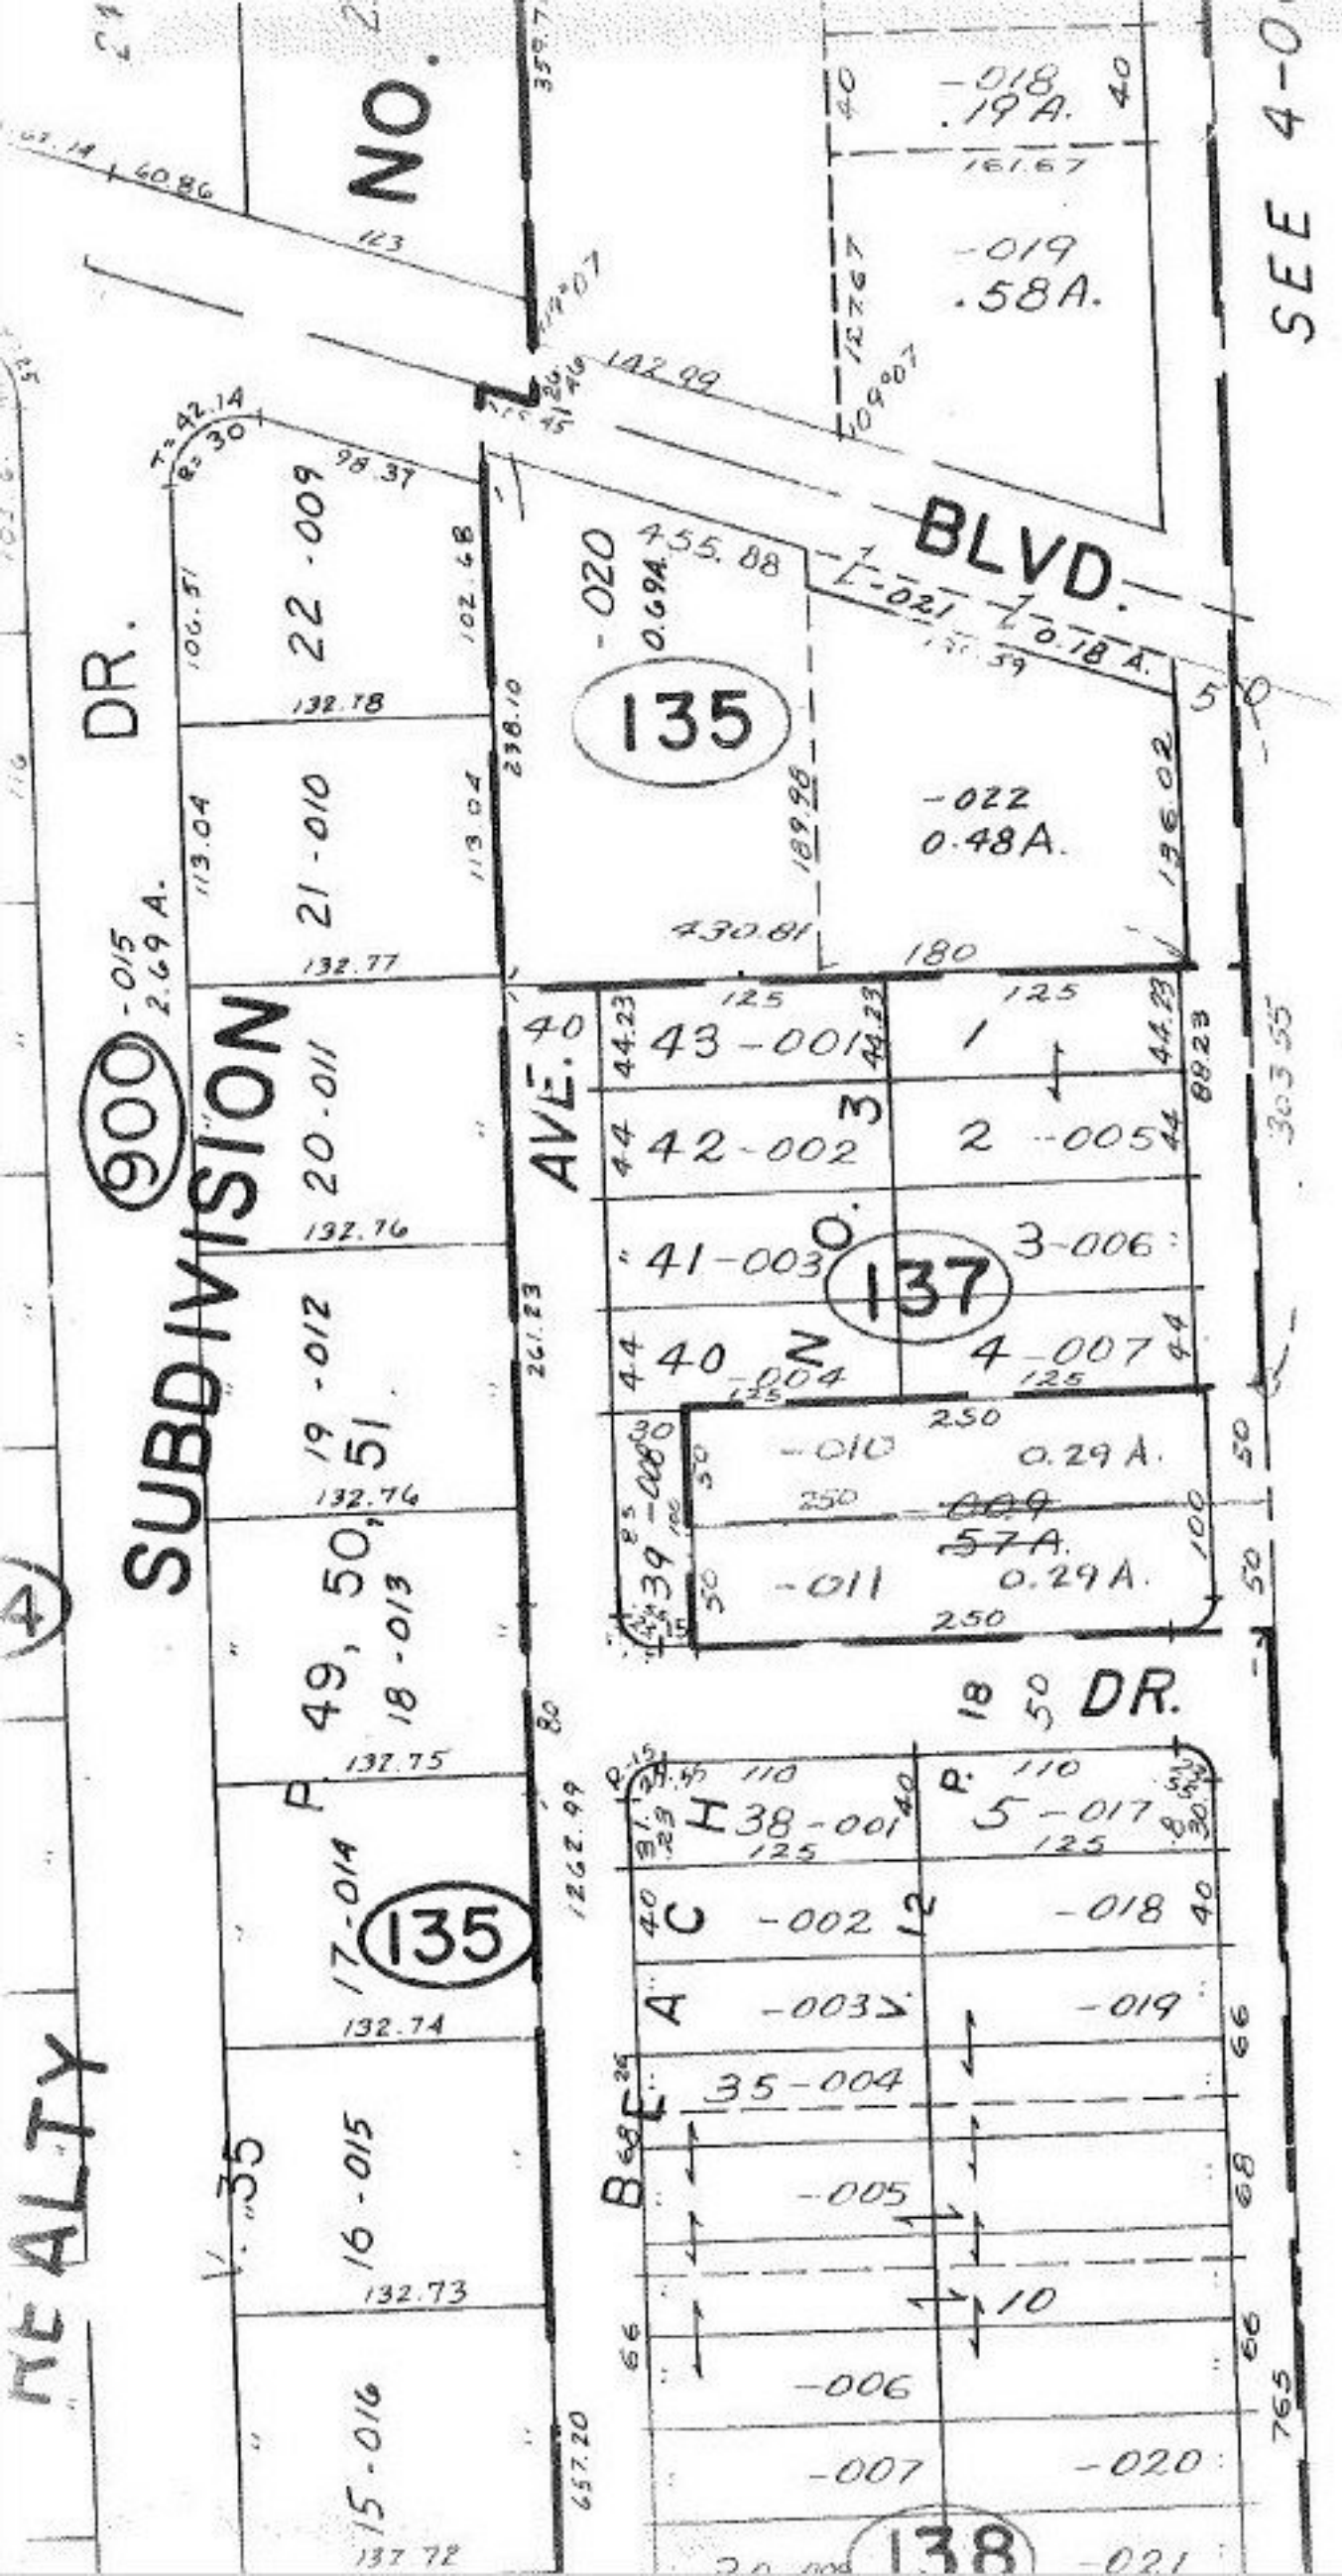

#14202

APPROVED
LORAIN CO.
MAP DEPT.

DATE 5-14-81

PAGE 4-00-019-D

BY T. McNair

VOID AFTER

JAN 8 1982