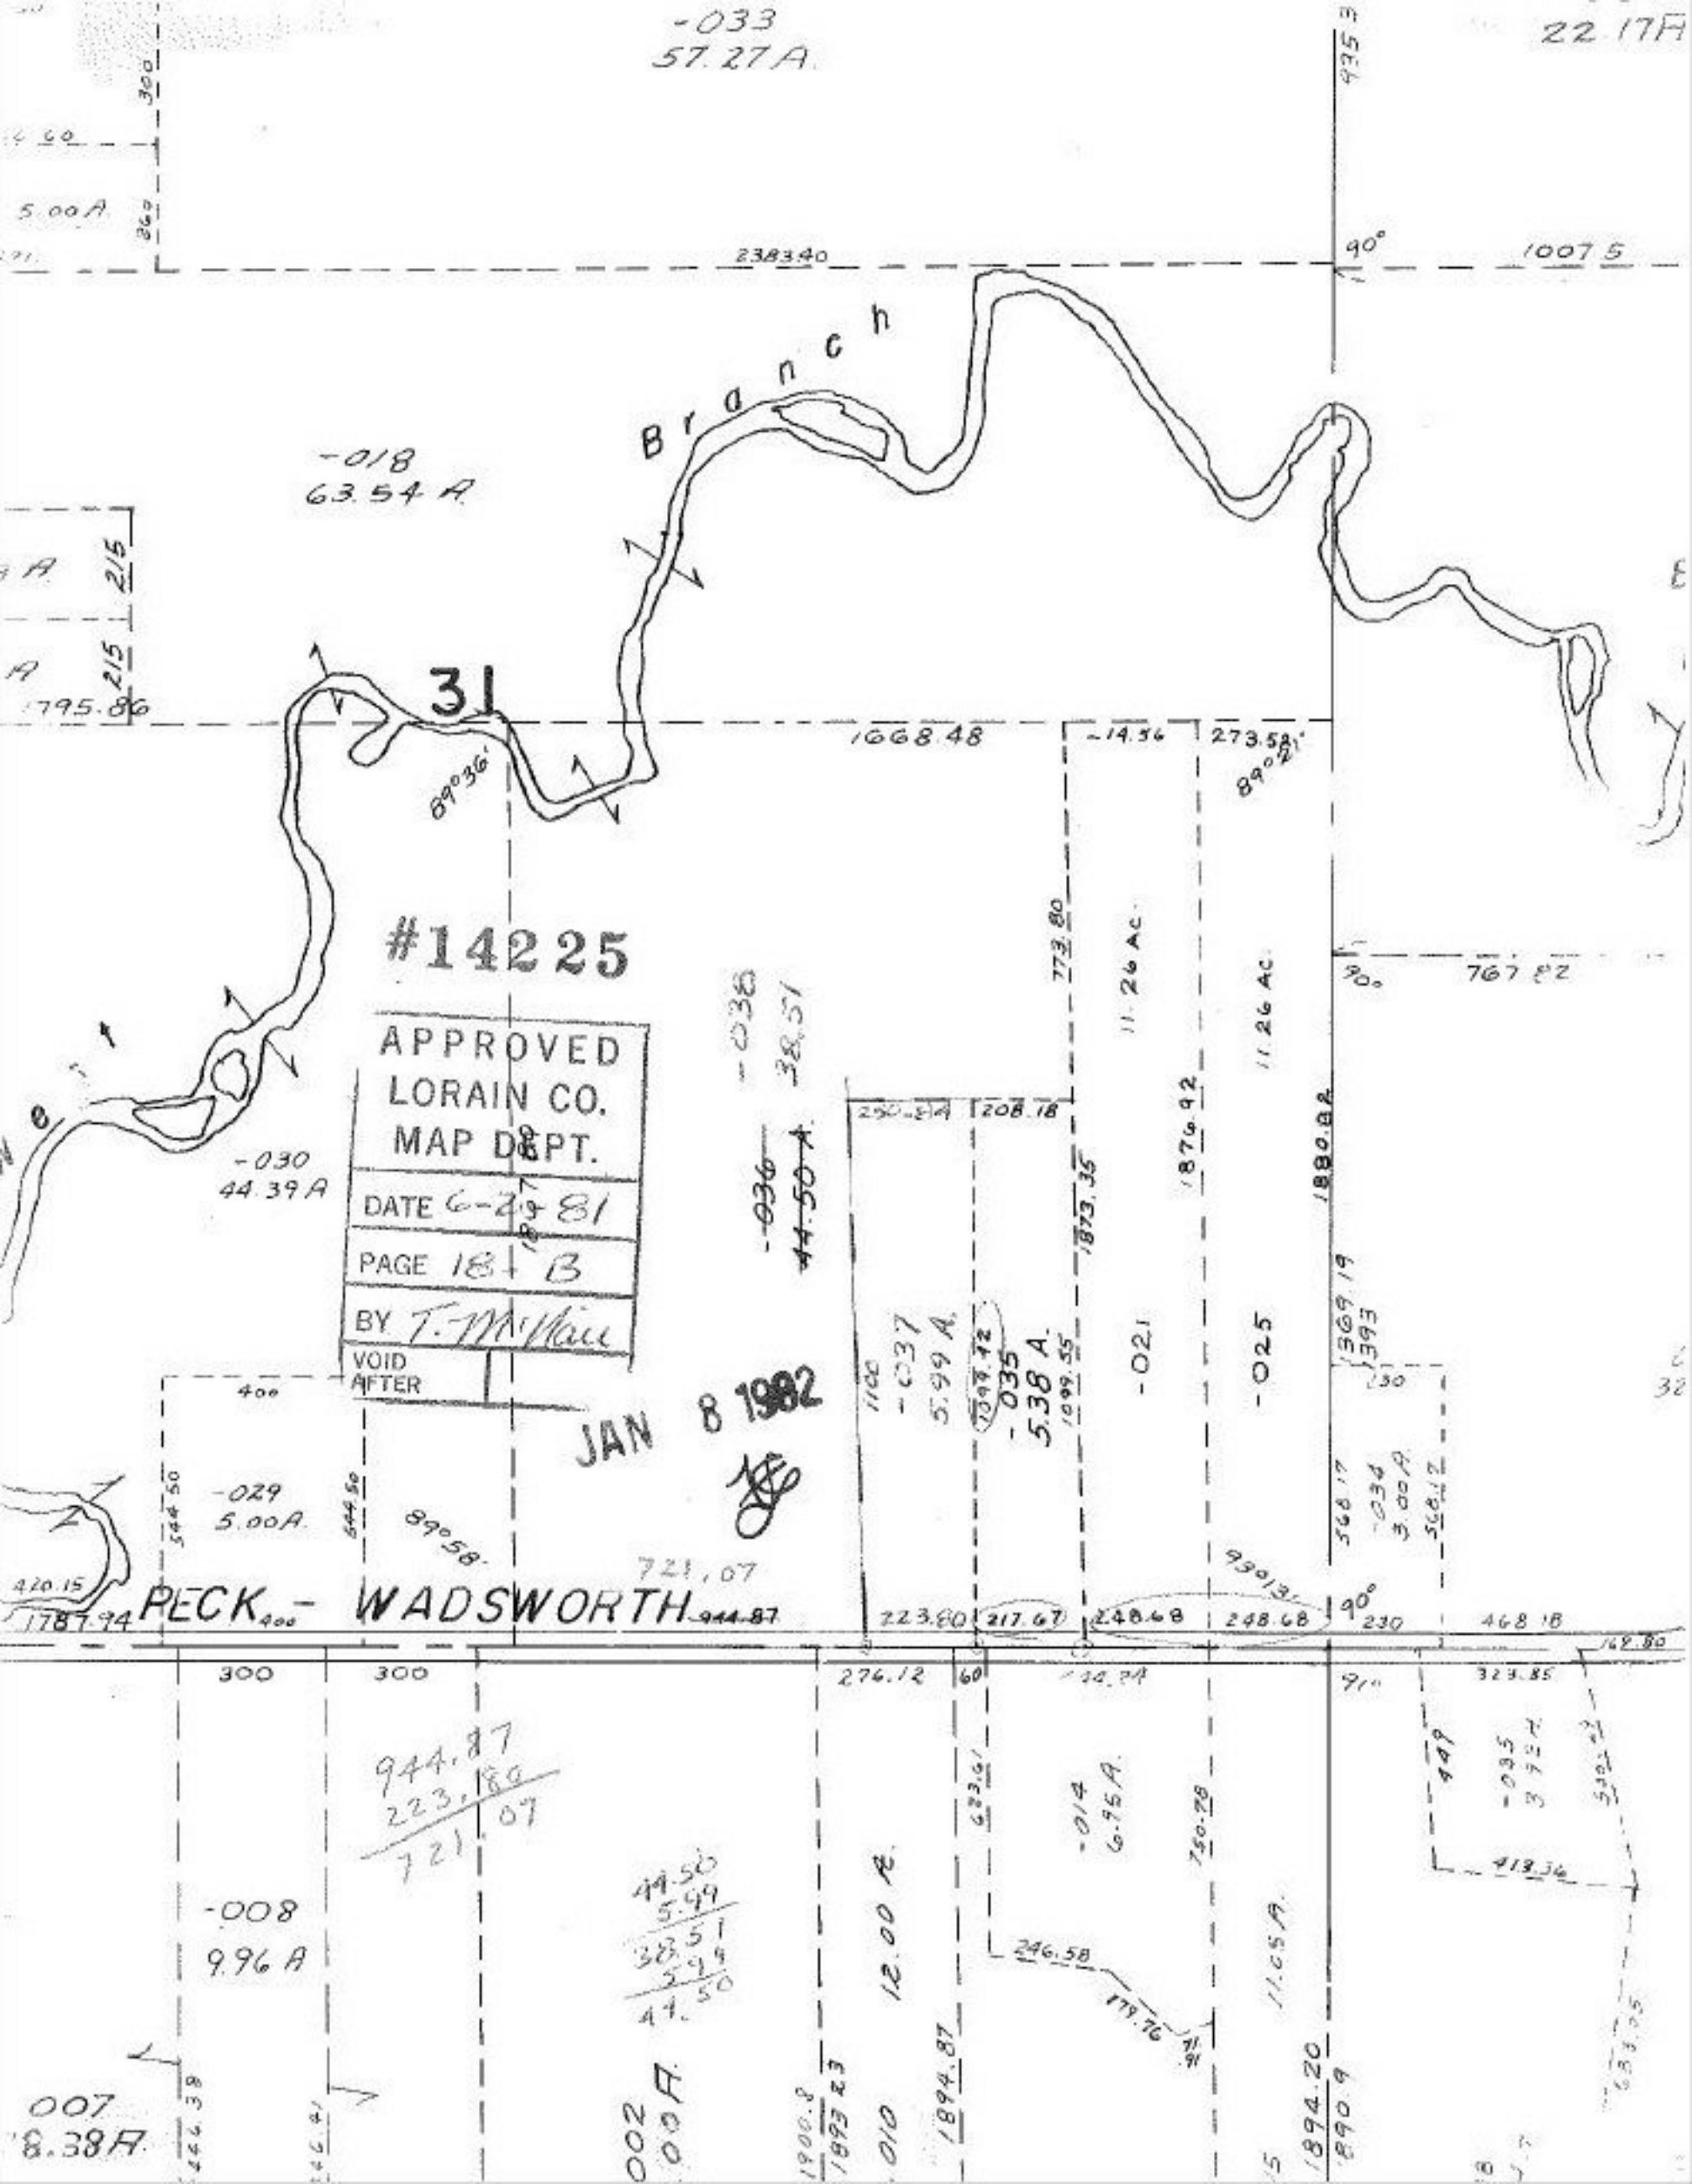

-033
57.27 A.
22.17 A
5.00 A.
2383.40
90°
1007.5
Branch
-018
63.54 A.
215
215
1795.86
31
1668.48
-14.56
273.58
89°36'
89°21'
#14225
APPROVED
LORAIN CO.
MAP DEPT.
DATE 6-2-81
PAGE 18-B
BY T. McNair
VOID
AFTER
-030
44.39 A
-036
44.50 A.
-038
38.51
773.80
11.26 AC.
11.26 AC.
767.82
90°
250.84
208.18
1876.92
1880.82
1873.35
-037
5.99 A.
-035
5.38 A.
-021
-025
1369.19
1393
JAN 8 1982
400
-029
5.00 A.
544.50
544.50
89°58'
721.07
420.15
1787.94
PECK - WADSWORTH
944.87
223.80
217.67
248.68
248.68
90°
230
468.18
300
300
276.12
60
323.85
944.87
223.80
721.07
-008
9.96 A
44.50
5.99
38.51
5.99
44.50
12.00 A.
-014
6.95 A.
750.78
11.05 A.
246.58
179.76
-035
3.93 A.
413.36
007
8.38 A.
1894.87
1894.20
1890.9