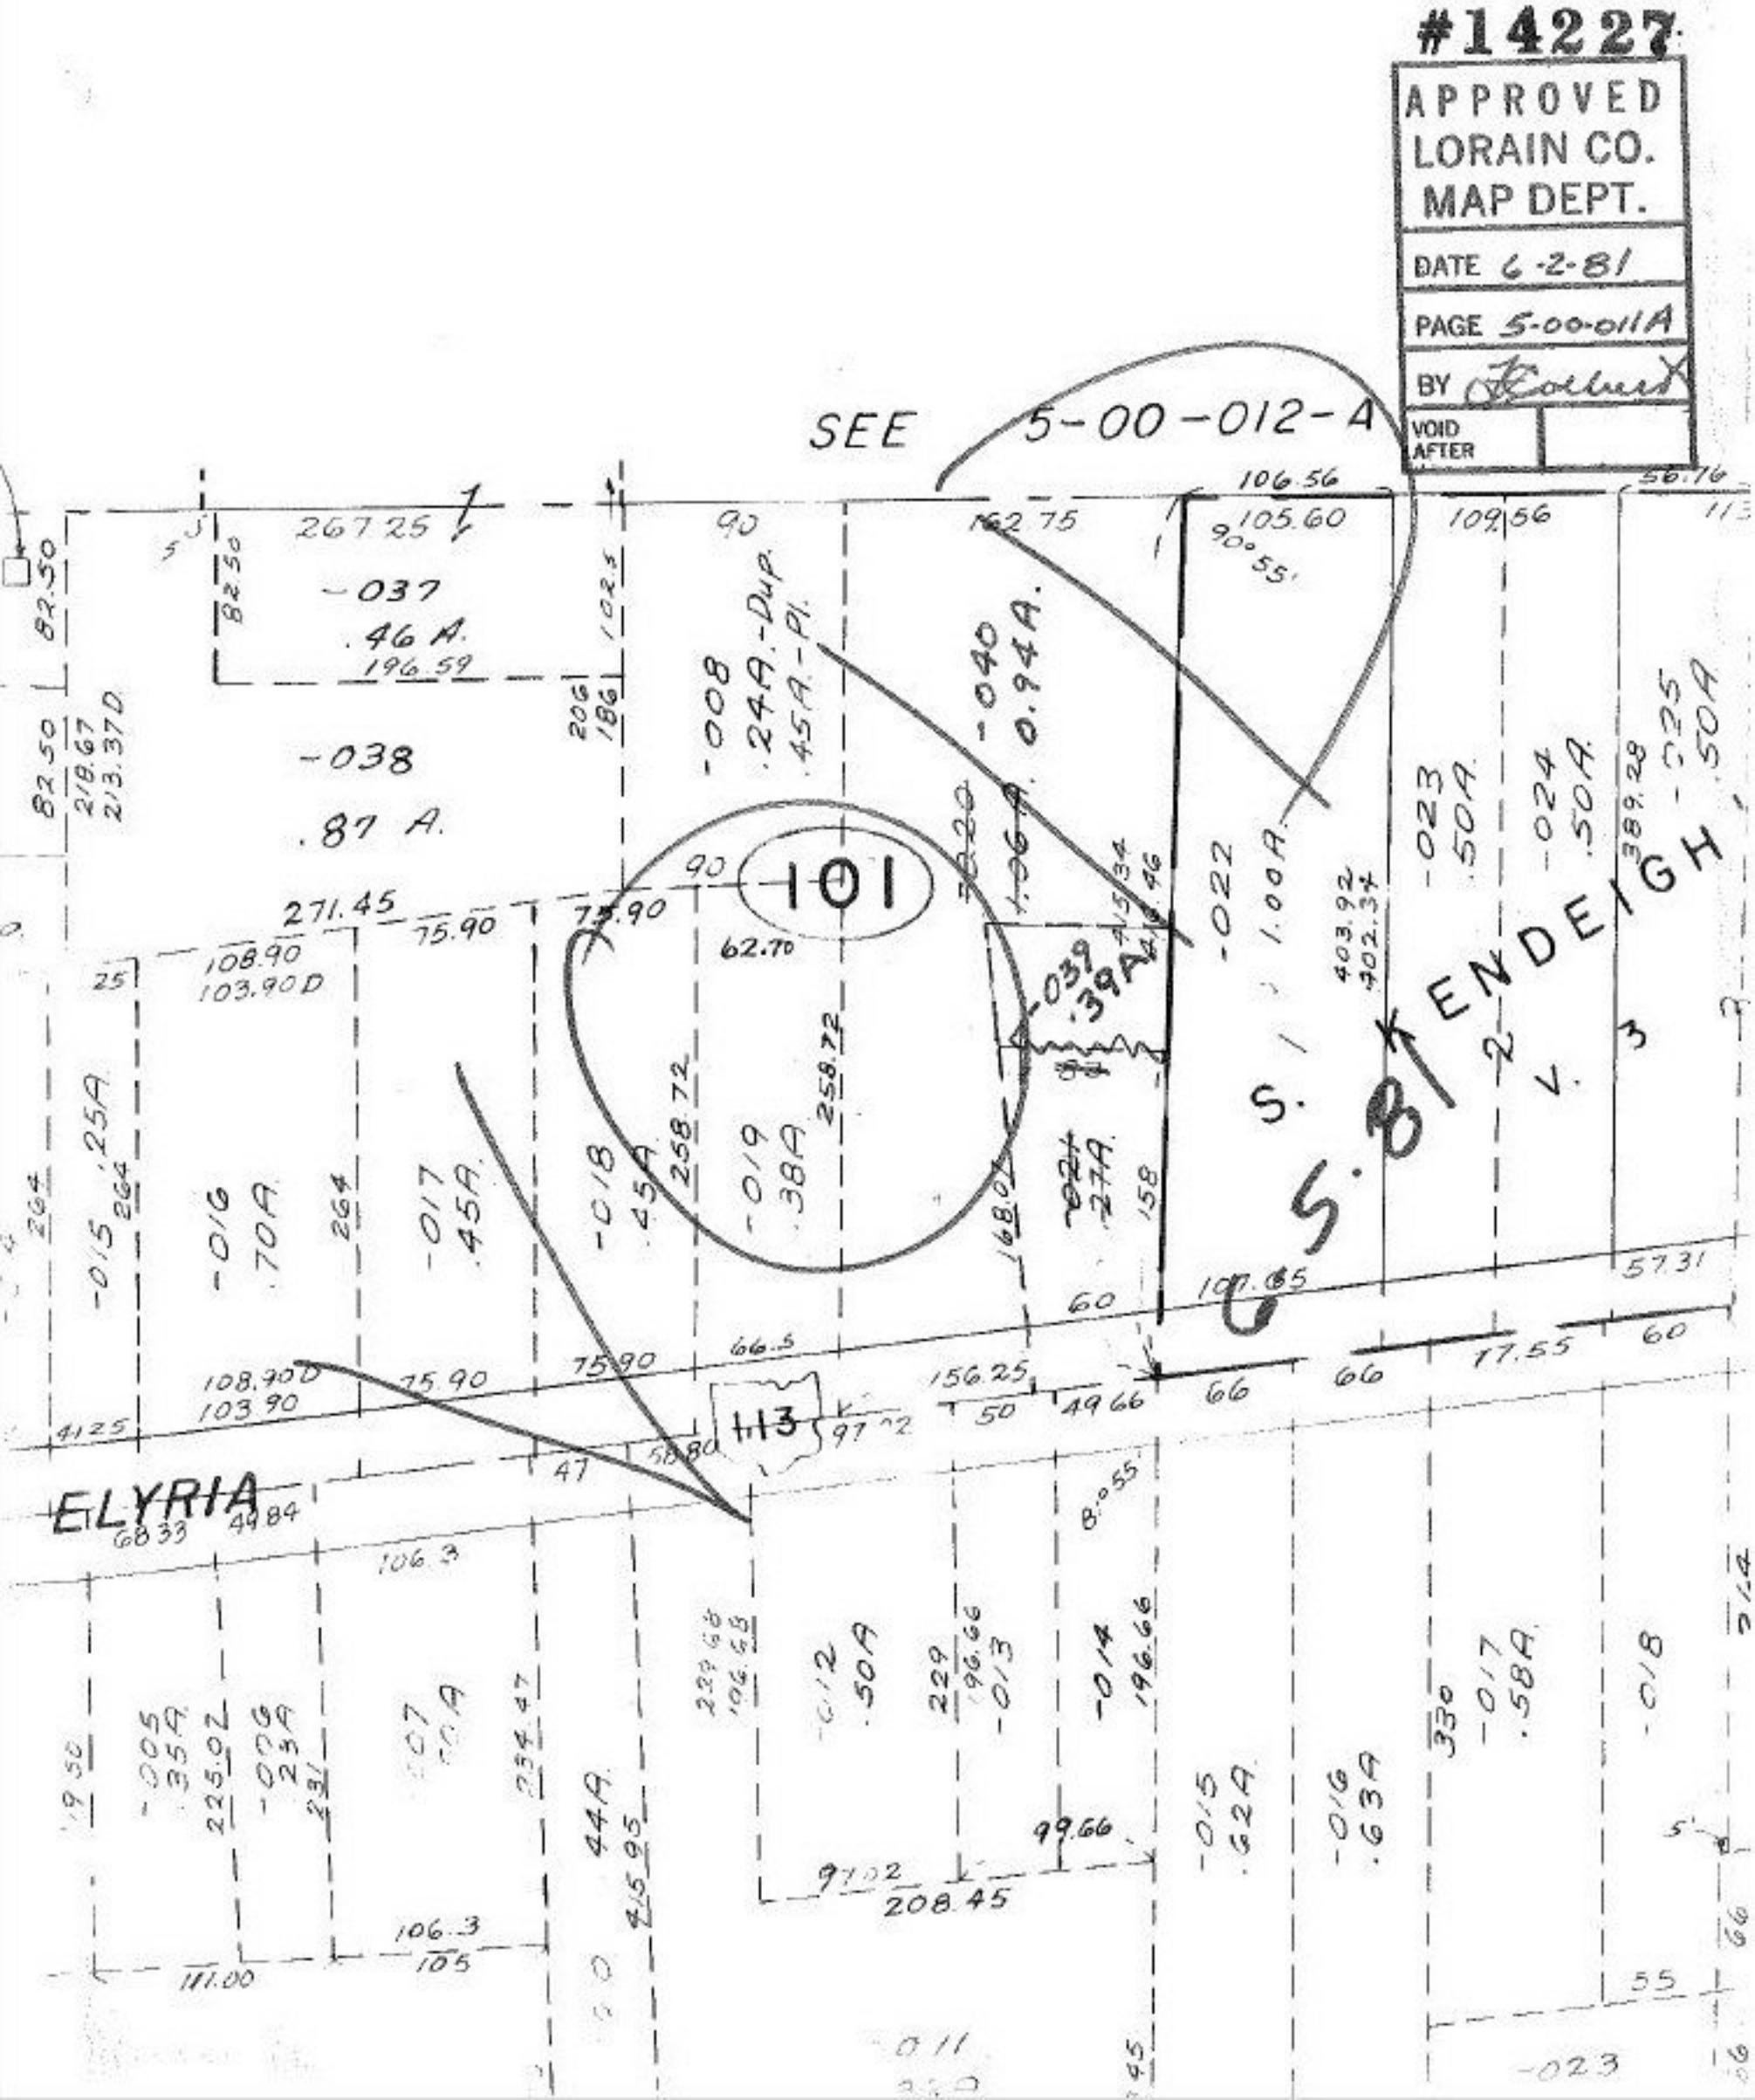
#14227
APPROVED
LORAIN CO.
MAP DEPT.
DATE 6-2-81
PAGE 5-00-011A
BY
VOID AFTER
SEE 5-00-012-A
101
113
ELYRIA
S. KENDEIGH
V.
5.81
-037
.46 A.
-038
.87 A.
-040
0.94A.
-039
.39A
-022
1.00A.
-023
.50A.
-024
.50A.
-025
.50A
-015
.25A
-016
.70A
-017
.45A.
-018
.45A
-019
.38A
-012
.50A
-013
-014
196.66
-015
.62A
-016
.63A
-017
.58A
-018
-011
-023