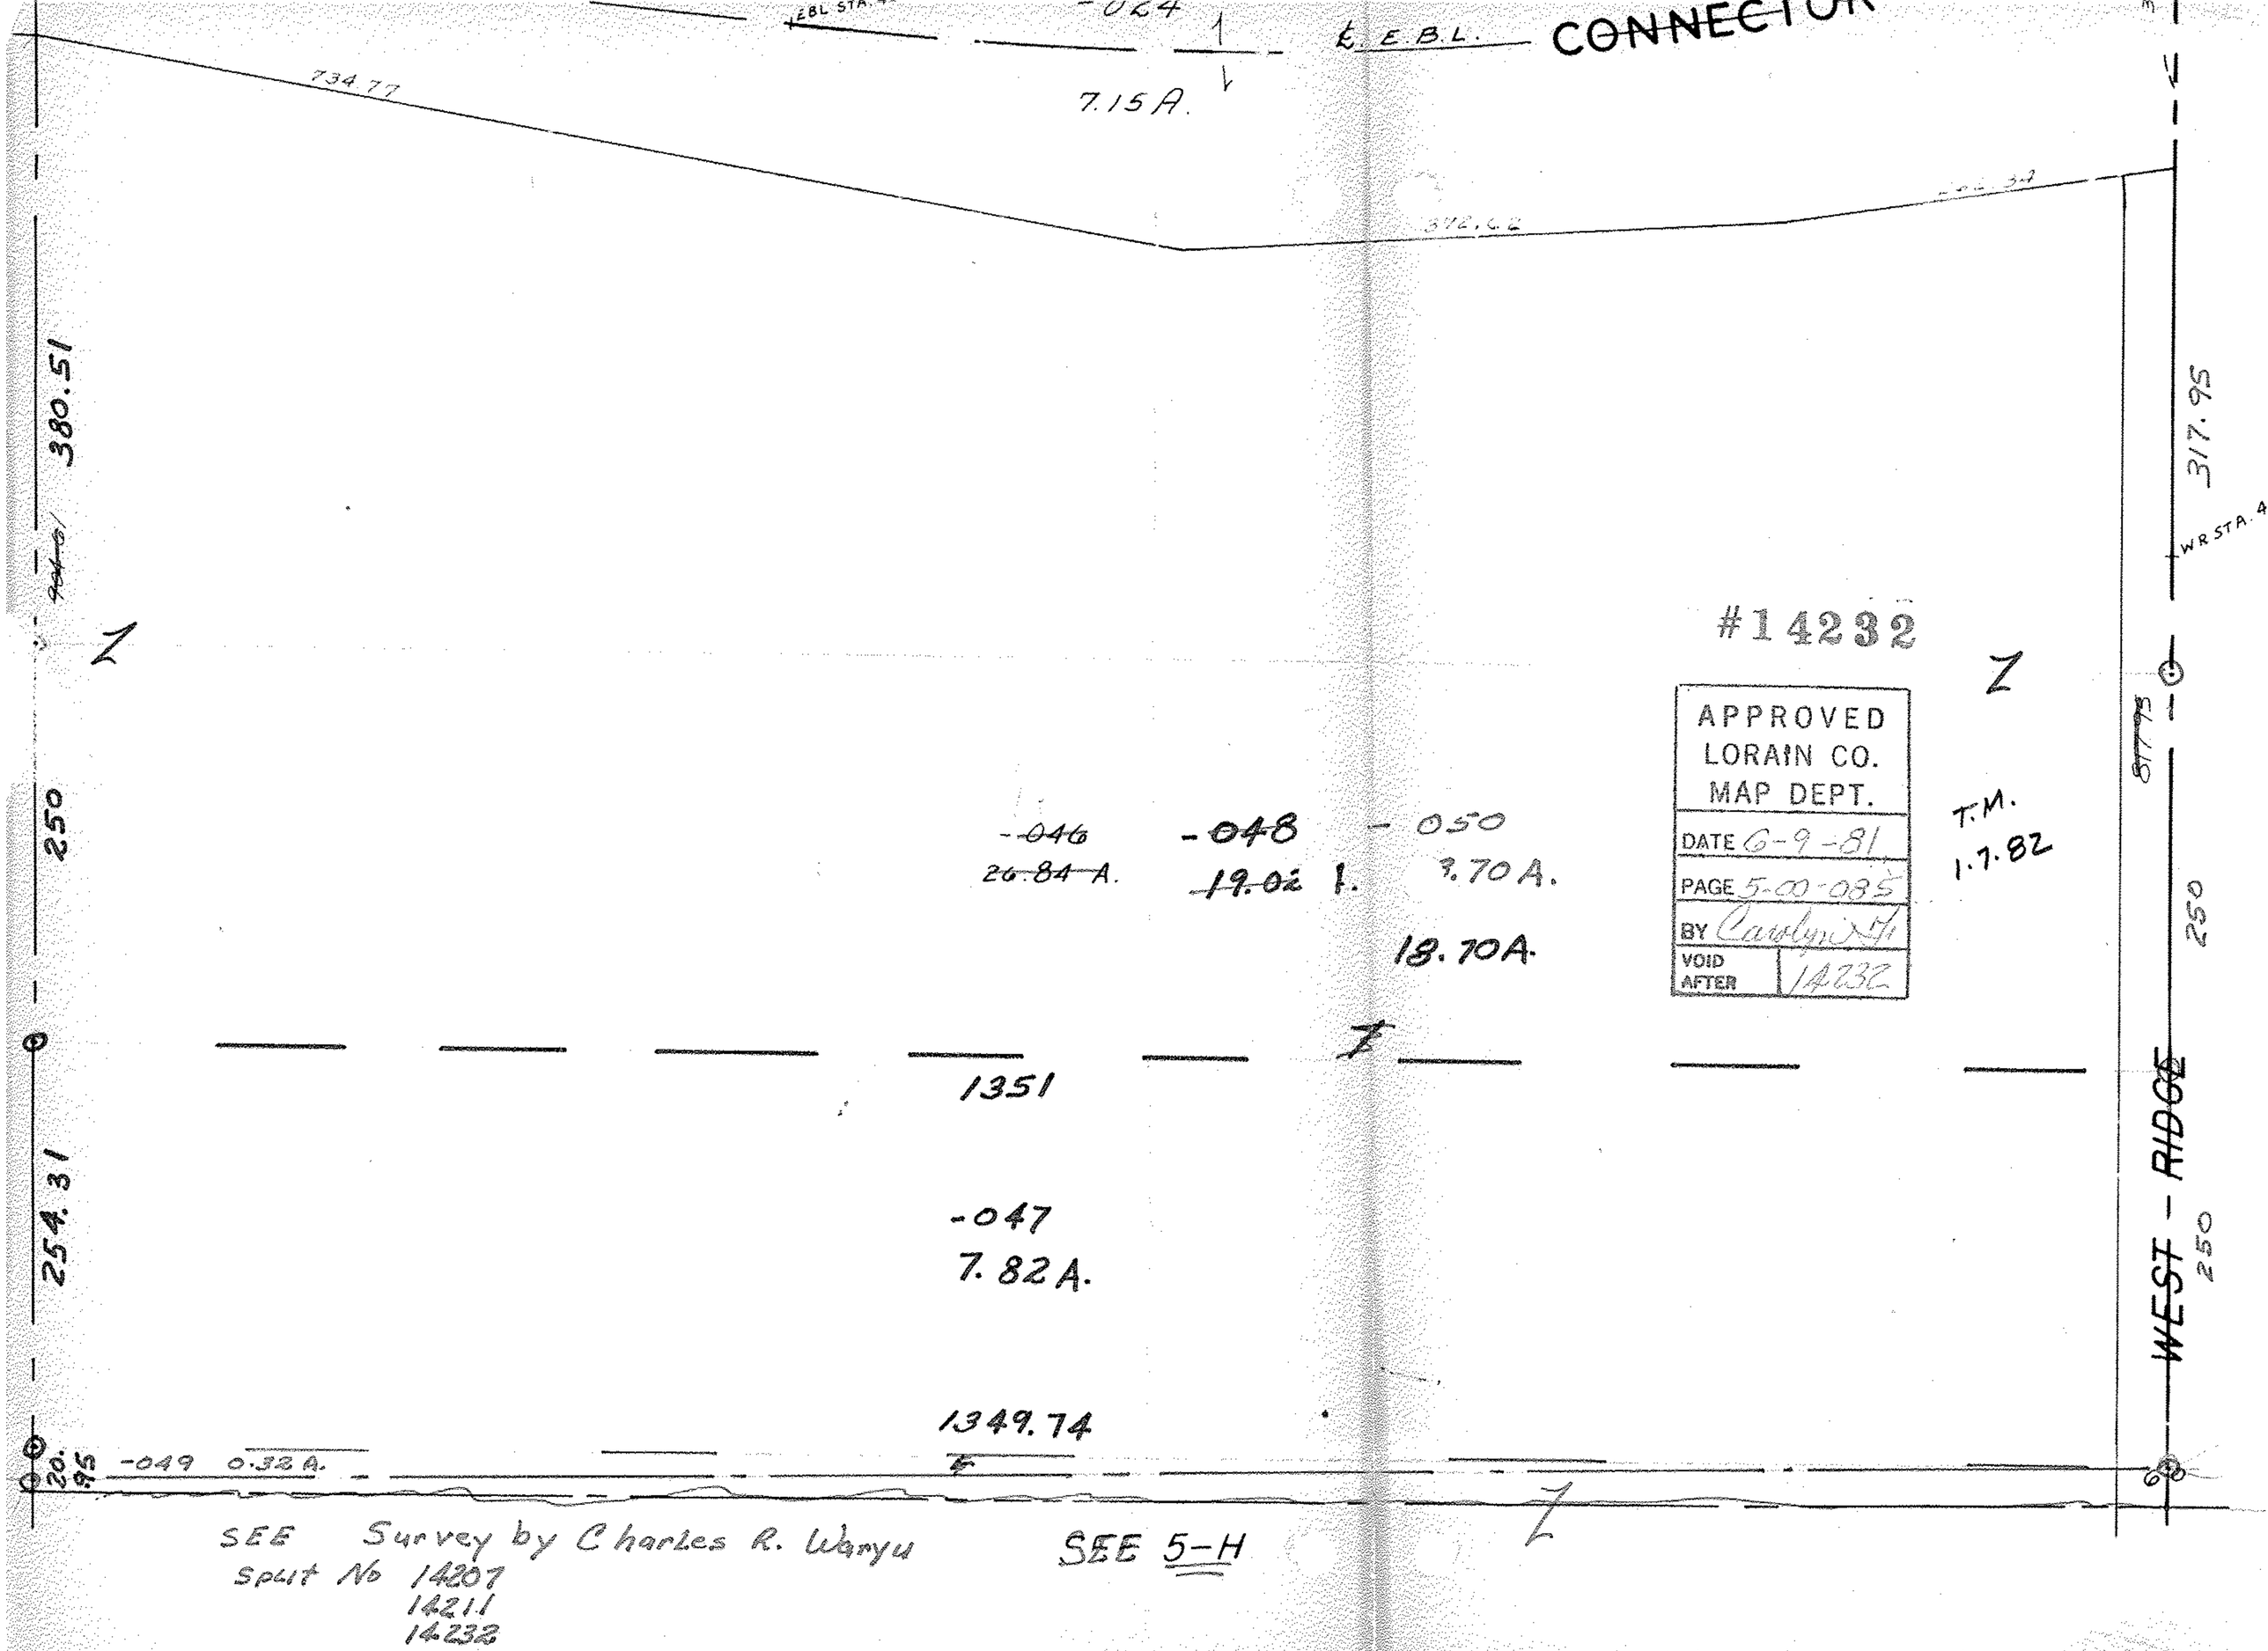

CONNECTOR
℄ E.B.L.
EBL STA.
-024
7.15 A.
734.77
372.62
380.51
317.95
WR STA. 4
#14232
APPROVED
LORAIN CO.
MAP DEPT.
DATE 6-9-81
PAGE 5-00-085
BY Carolyn
VOID AFTER 14232
T.M.
1.7.82
-046
26.84 A.
-048
19.02 A.
-050
3.70 A.
18.70 A.
1351
-047
7.82 A.
1349.74
-049 0.32 A.
254.31
20.95
250
WEST - RIDGE
SEE Survey by Charles R. Waryu
Split No 14207
14211
14232
SEE 5-H