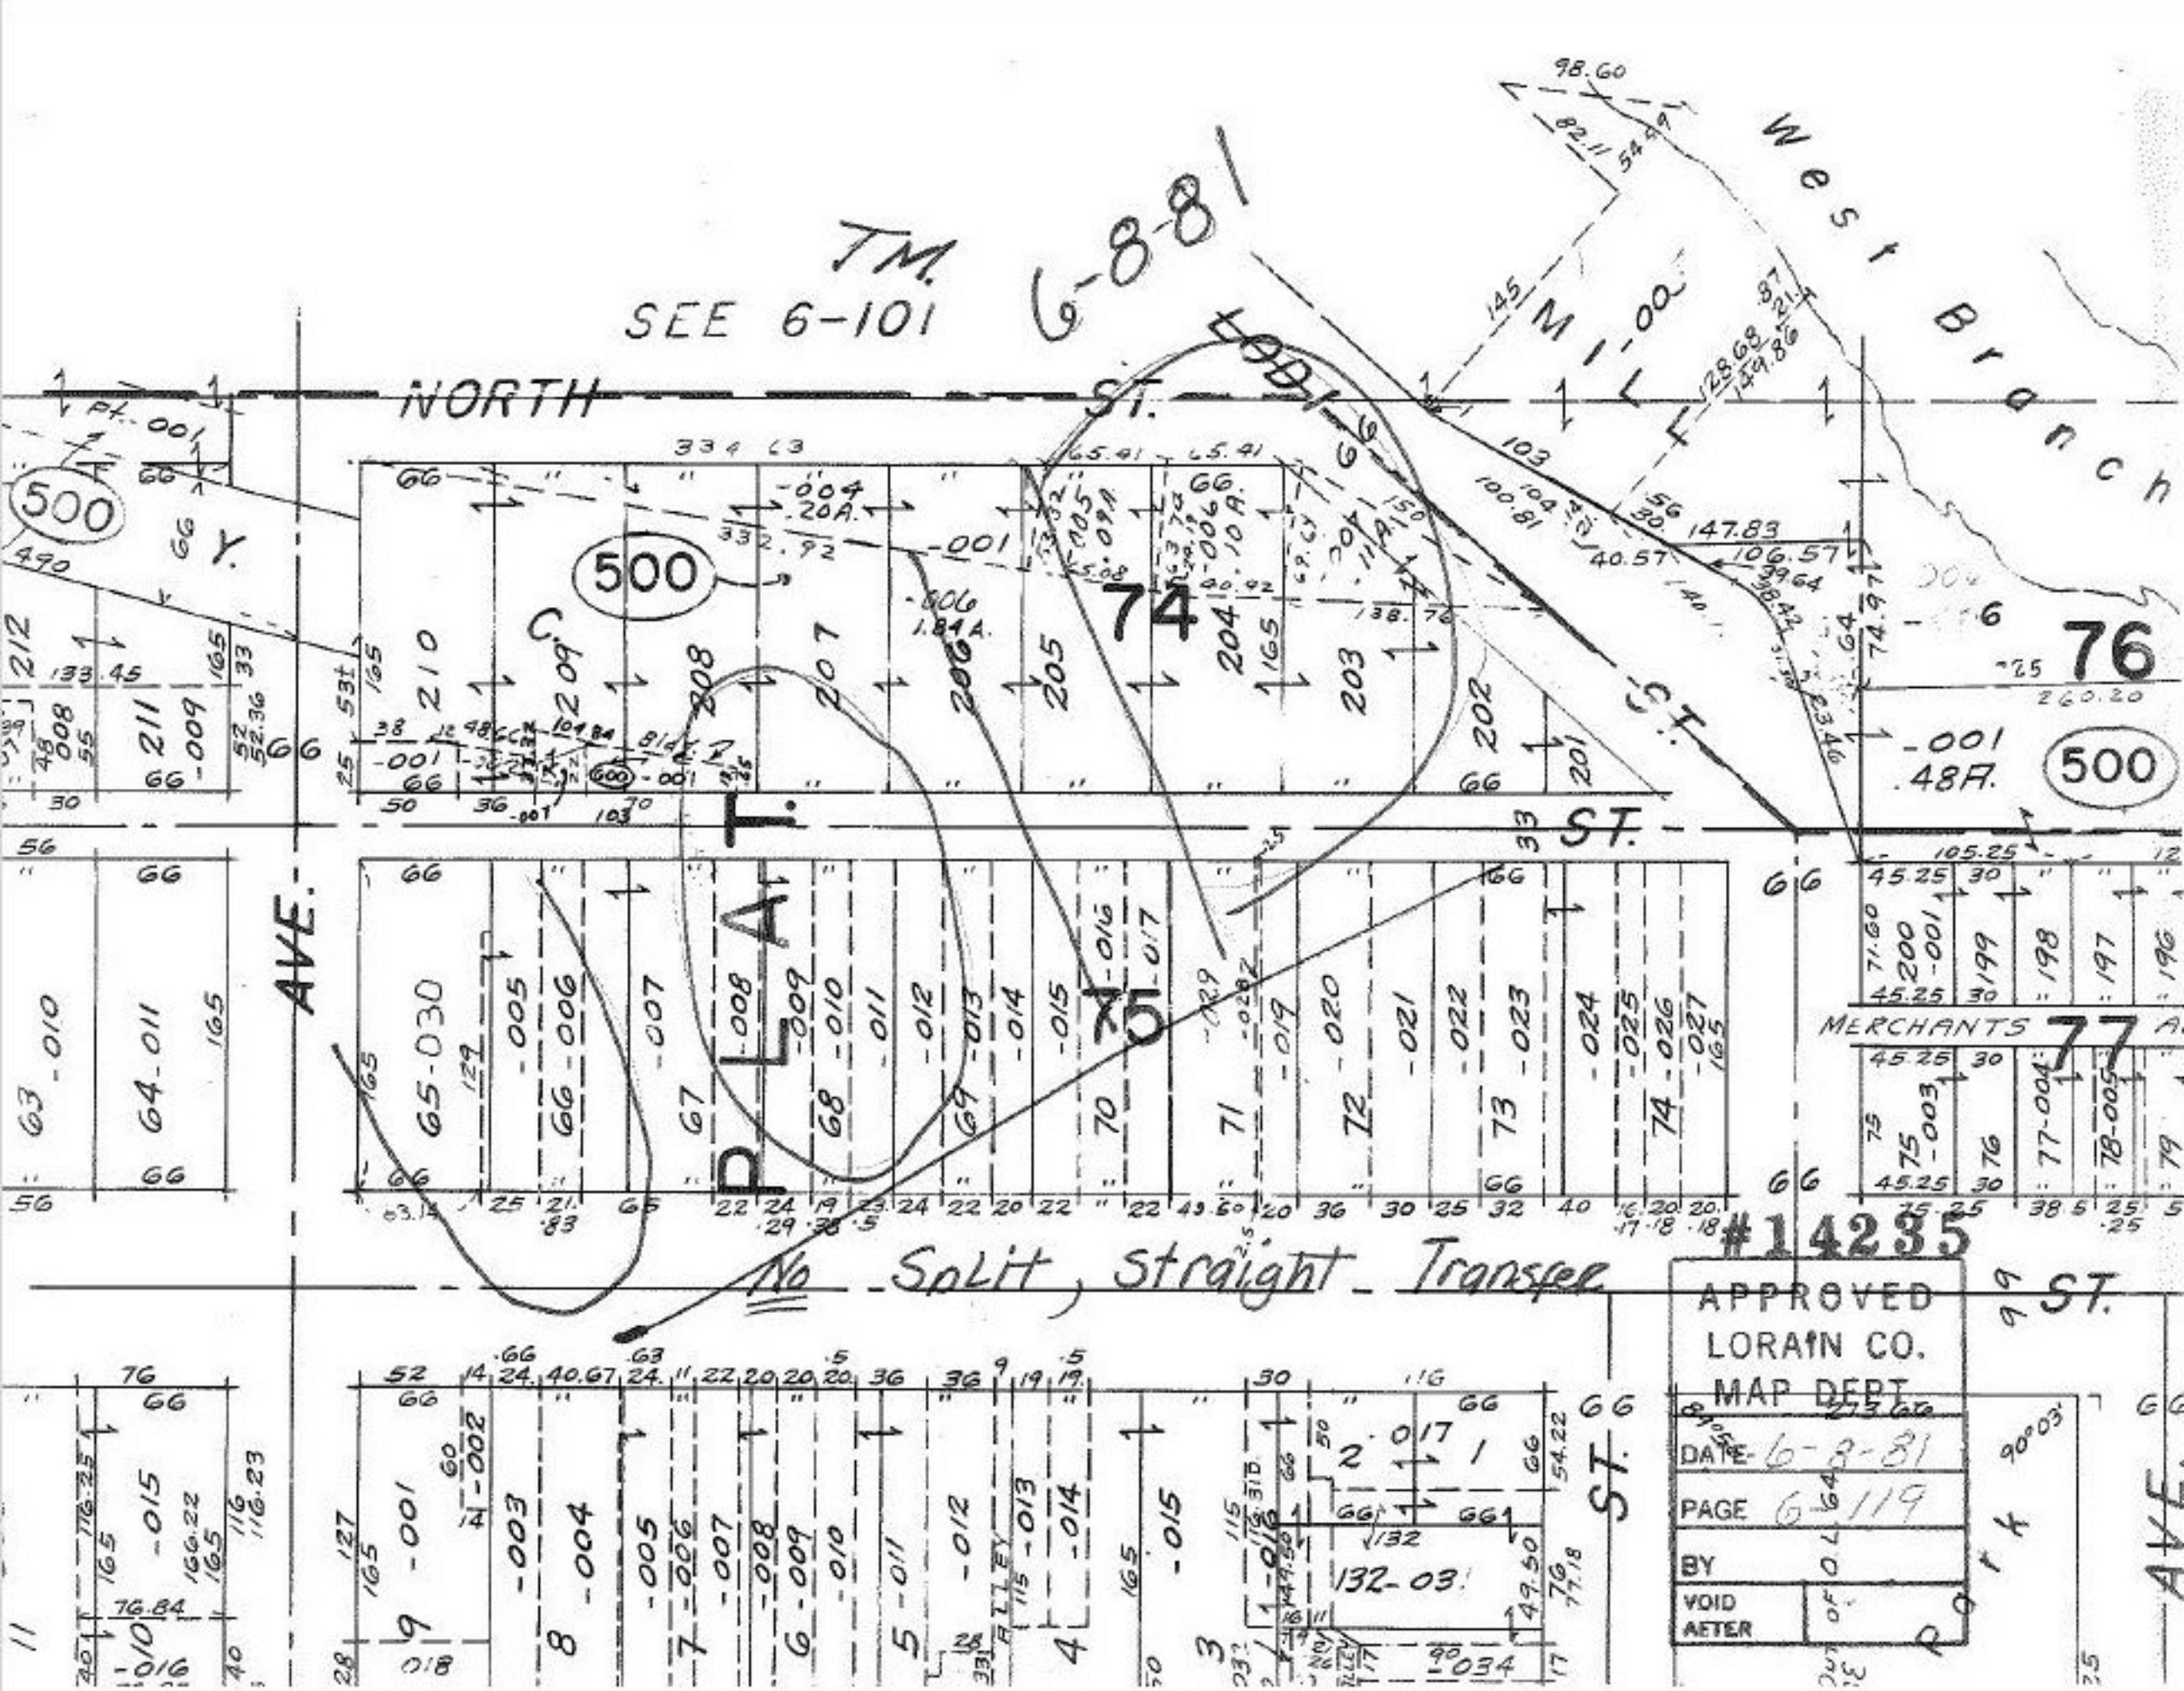

TM.
SEE 6-101
6-8-81
NORTH ST.
West Branch
MILL
LODI
ST.
AVE.
PLATT
ST.
MERCHANTS
No Split, Straight Transfer
#14235
APPROVED
LORAIN CO.
MAP DEPT.
DATE 6-8-81
PAGE 6-119
BY
VOID AFTER