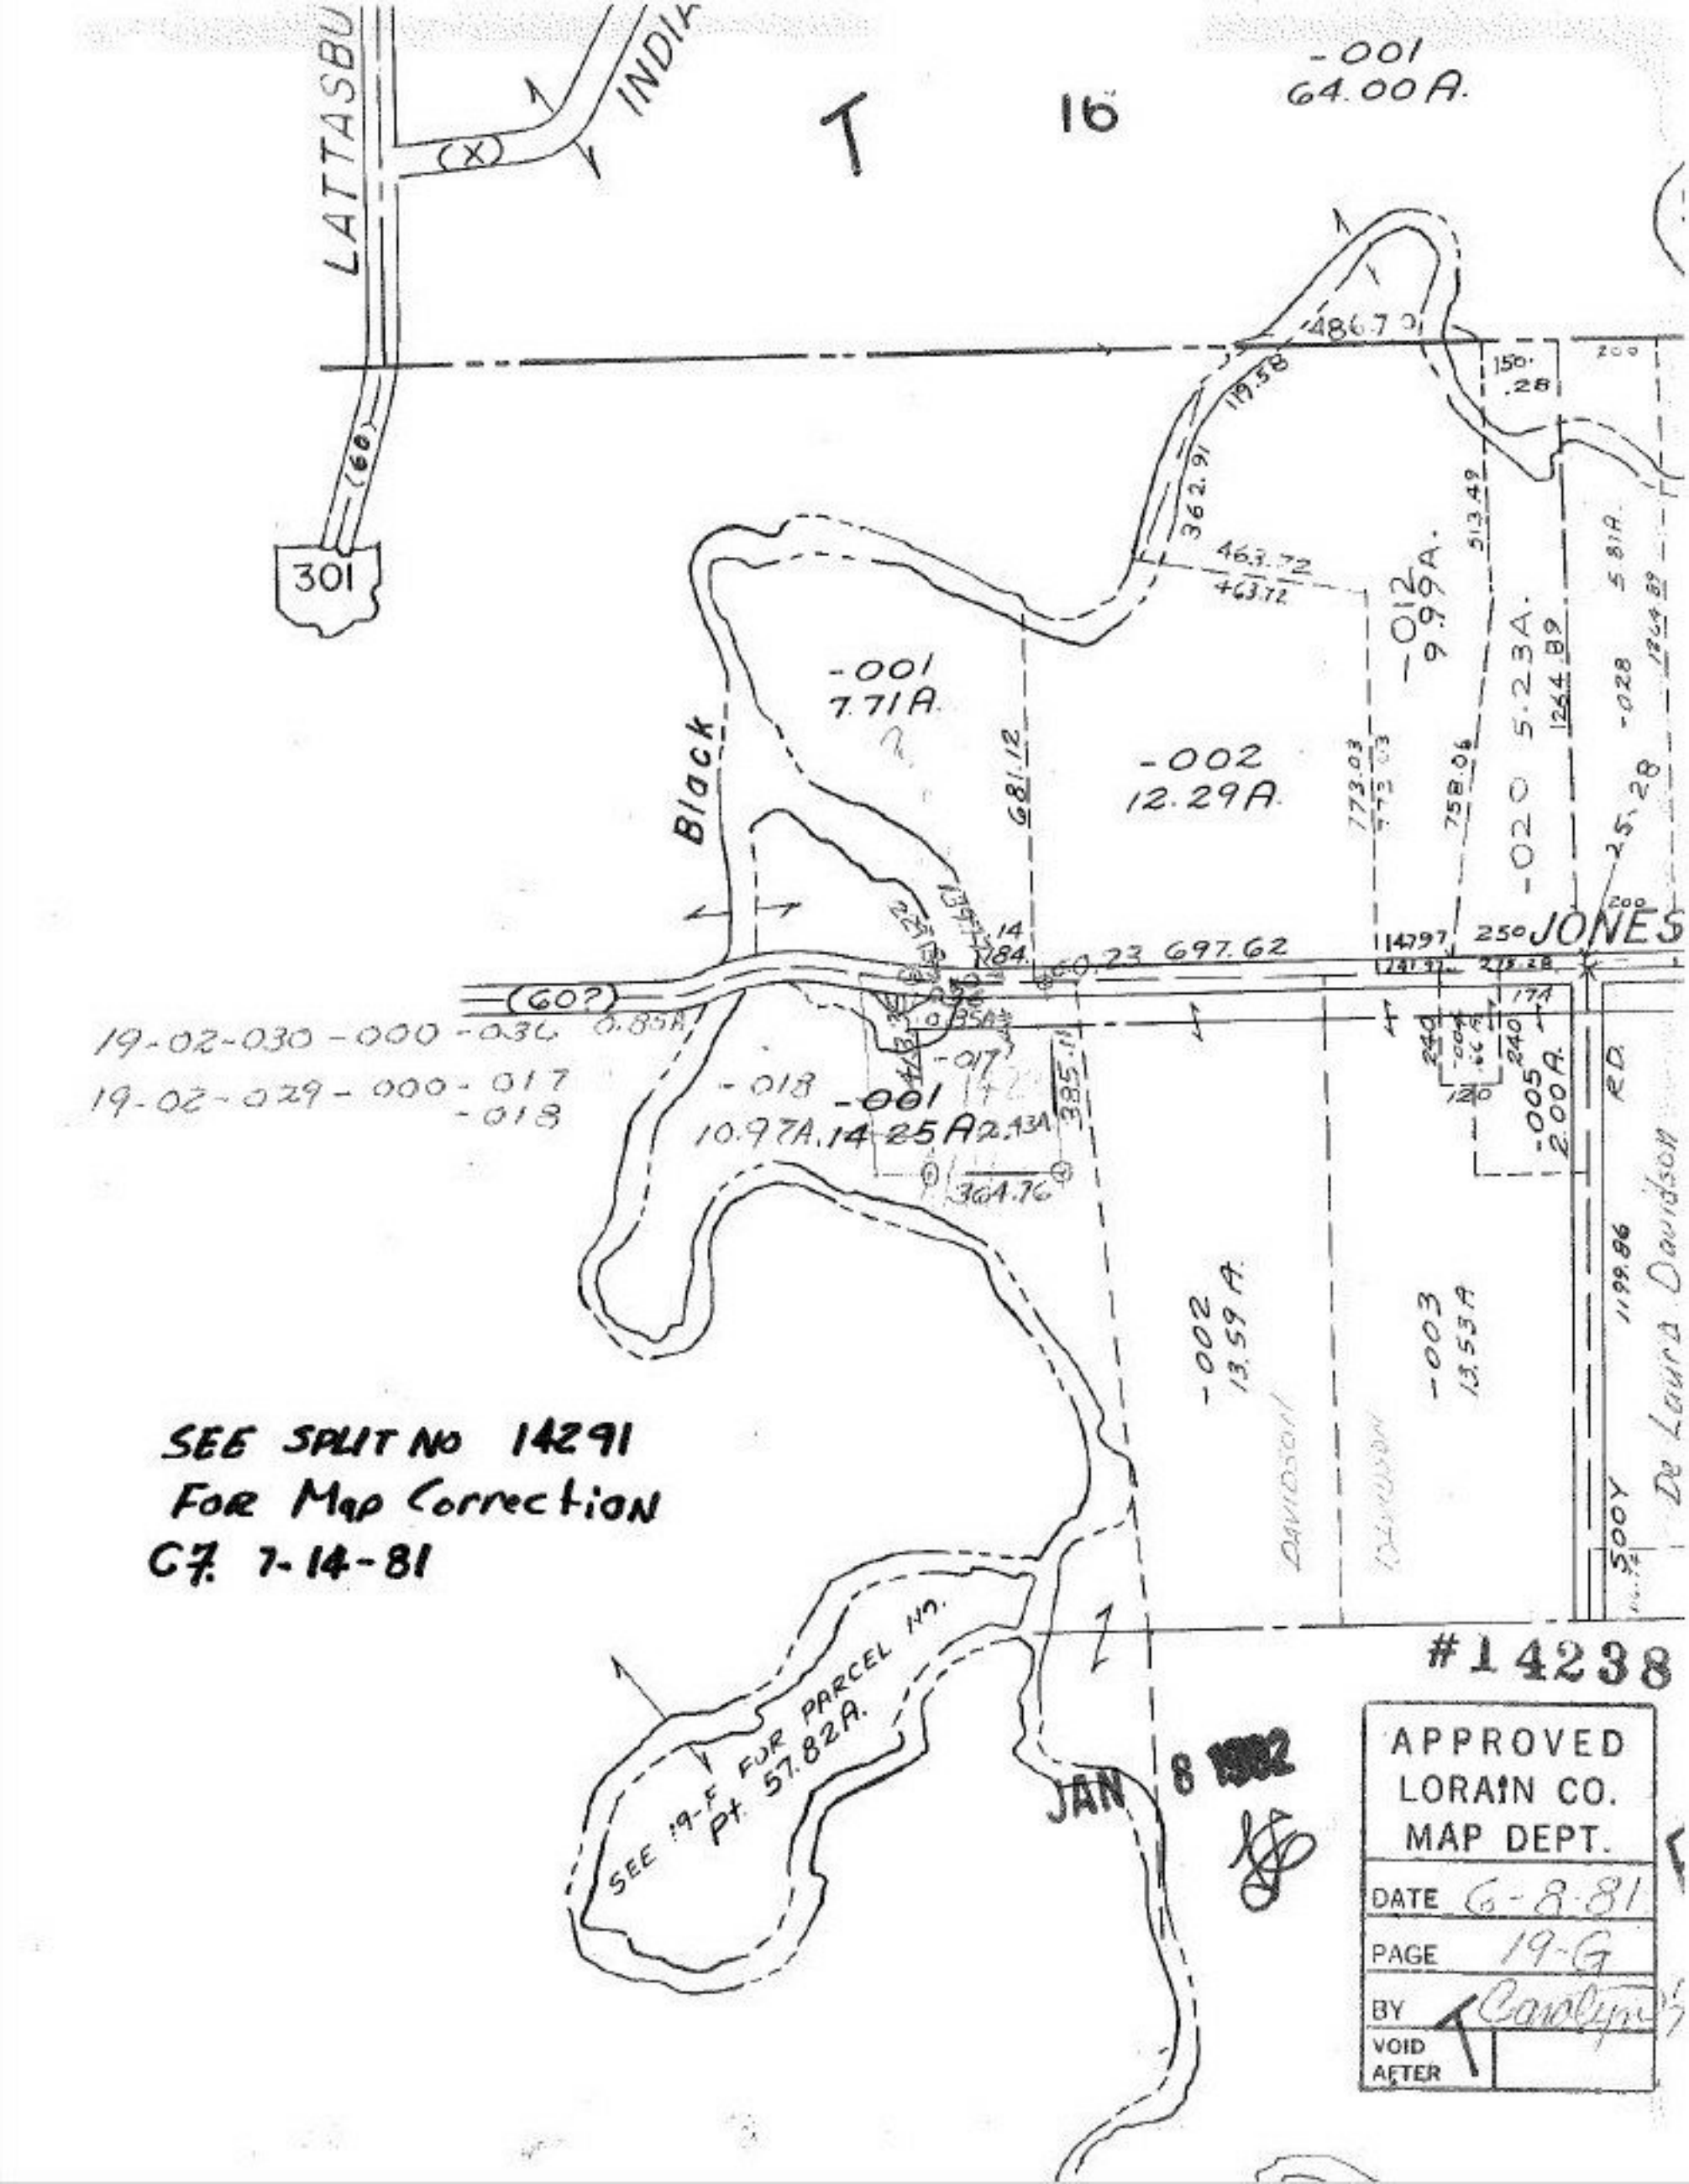

LATTASBU
INDIA
T 16
-001
64.00A.
301
(60)
(X)
486.70
119.58
362.91
463.72
463.72
150.
.28
200
513.49
-012
9.99A.
-001
7.71A.
-002
12.29A.
681.12
773.03
758.06
-020 5.23A.
1264.89
-028
5.81A.
25.28
Black
14
184.
697.62
14797
250
JONES
(60?)
0.85A
19-02-030-000-036
19-02-029-000-017
-018
-018
-001
10.97A.14.25A
-017
385.11
364.76
-005
2.00A.
RD.
1199.86
-002
13.59A.
-003
13.53A
DAVIDSON
500Y
De Laura Davidson
SEE SPLIT NO 14291
FOR Map Correction
C7. 7-14-81
SEE 19-F FOR PARCEL NO.
Pt. 57.82A.
#14238
JAN 8 1982
APPROVED
LORAIN CO.
MAP DEPT.
DATE 6-8-81
PAGE 19-G
BY Carolyn
VOID
AFTER