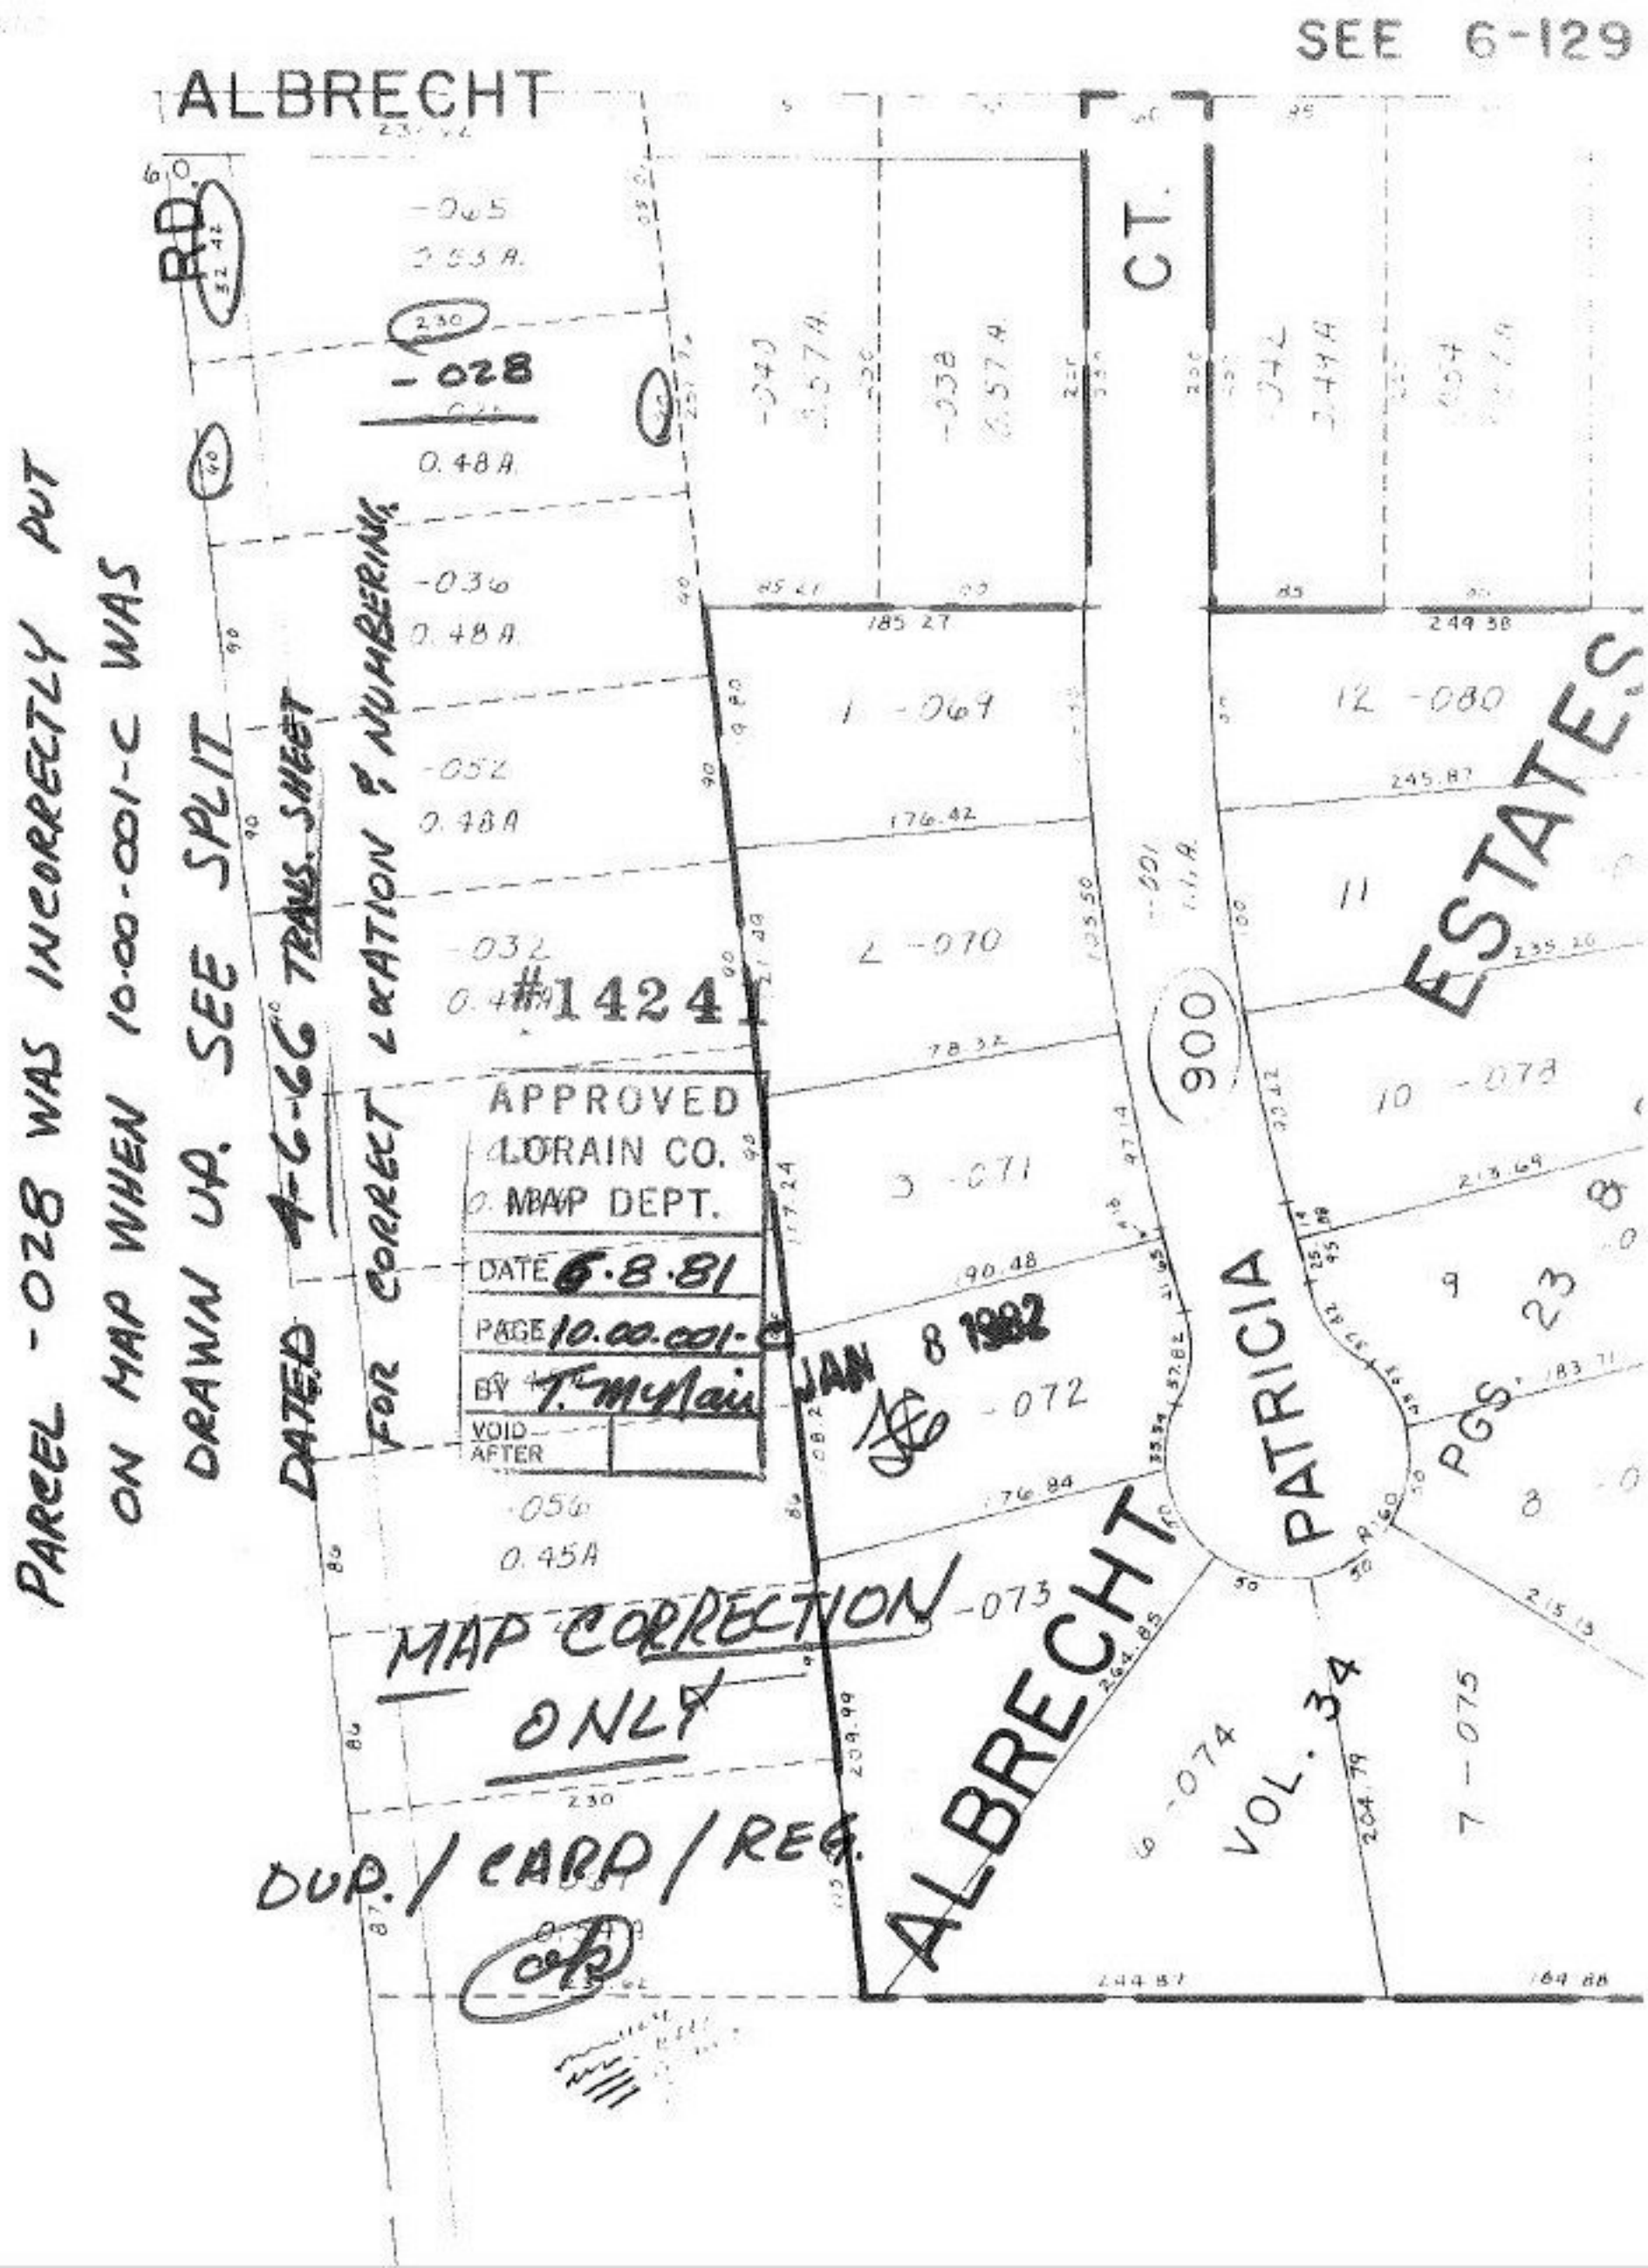
SEE 6-129
ALBRECHT
RD.
CT.
ESTATES
PATRICIA
ALBRECHT
VOL. 34
PGS. 23
900
-065
0.53 A.
-028
0.48 A.
-036
0.48 A.
-052
0.48 A.
-032
0.48 A.
-056
0.45 A.
1 -069
2 -070
3 -071
-072
-073
6 -074
7 -075
8
9
10 -078
11
12 -080
#14241
APPROVED
LORAIN CO.
MAP DEPT.
DATE 6.8.81
PAGE 10.00.001-C
BY T. McNair
VOID AFTER
JAN 8 1982
PARCEL -028 WAS INCORRECTLY PUT ON MAP WHEN 10-00-001-C WAS DRAWN UP. SEE SPLIT
DATED 4-6-66 TRANS. SHEET
FOR CORRECT LOCATION & NUMBERING
MAP CORRECTION ONLY
DUP. / CARD / REG.