SEE 5-00-022-A

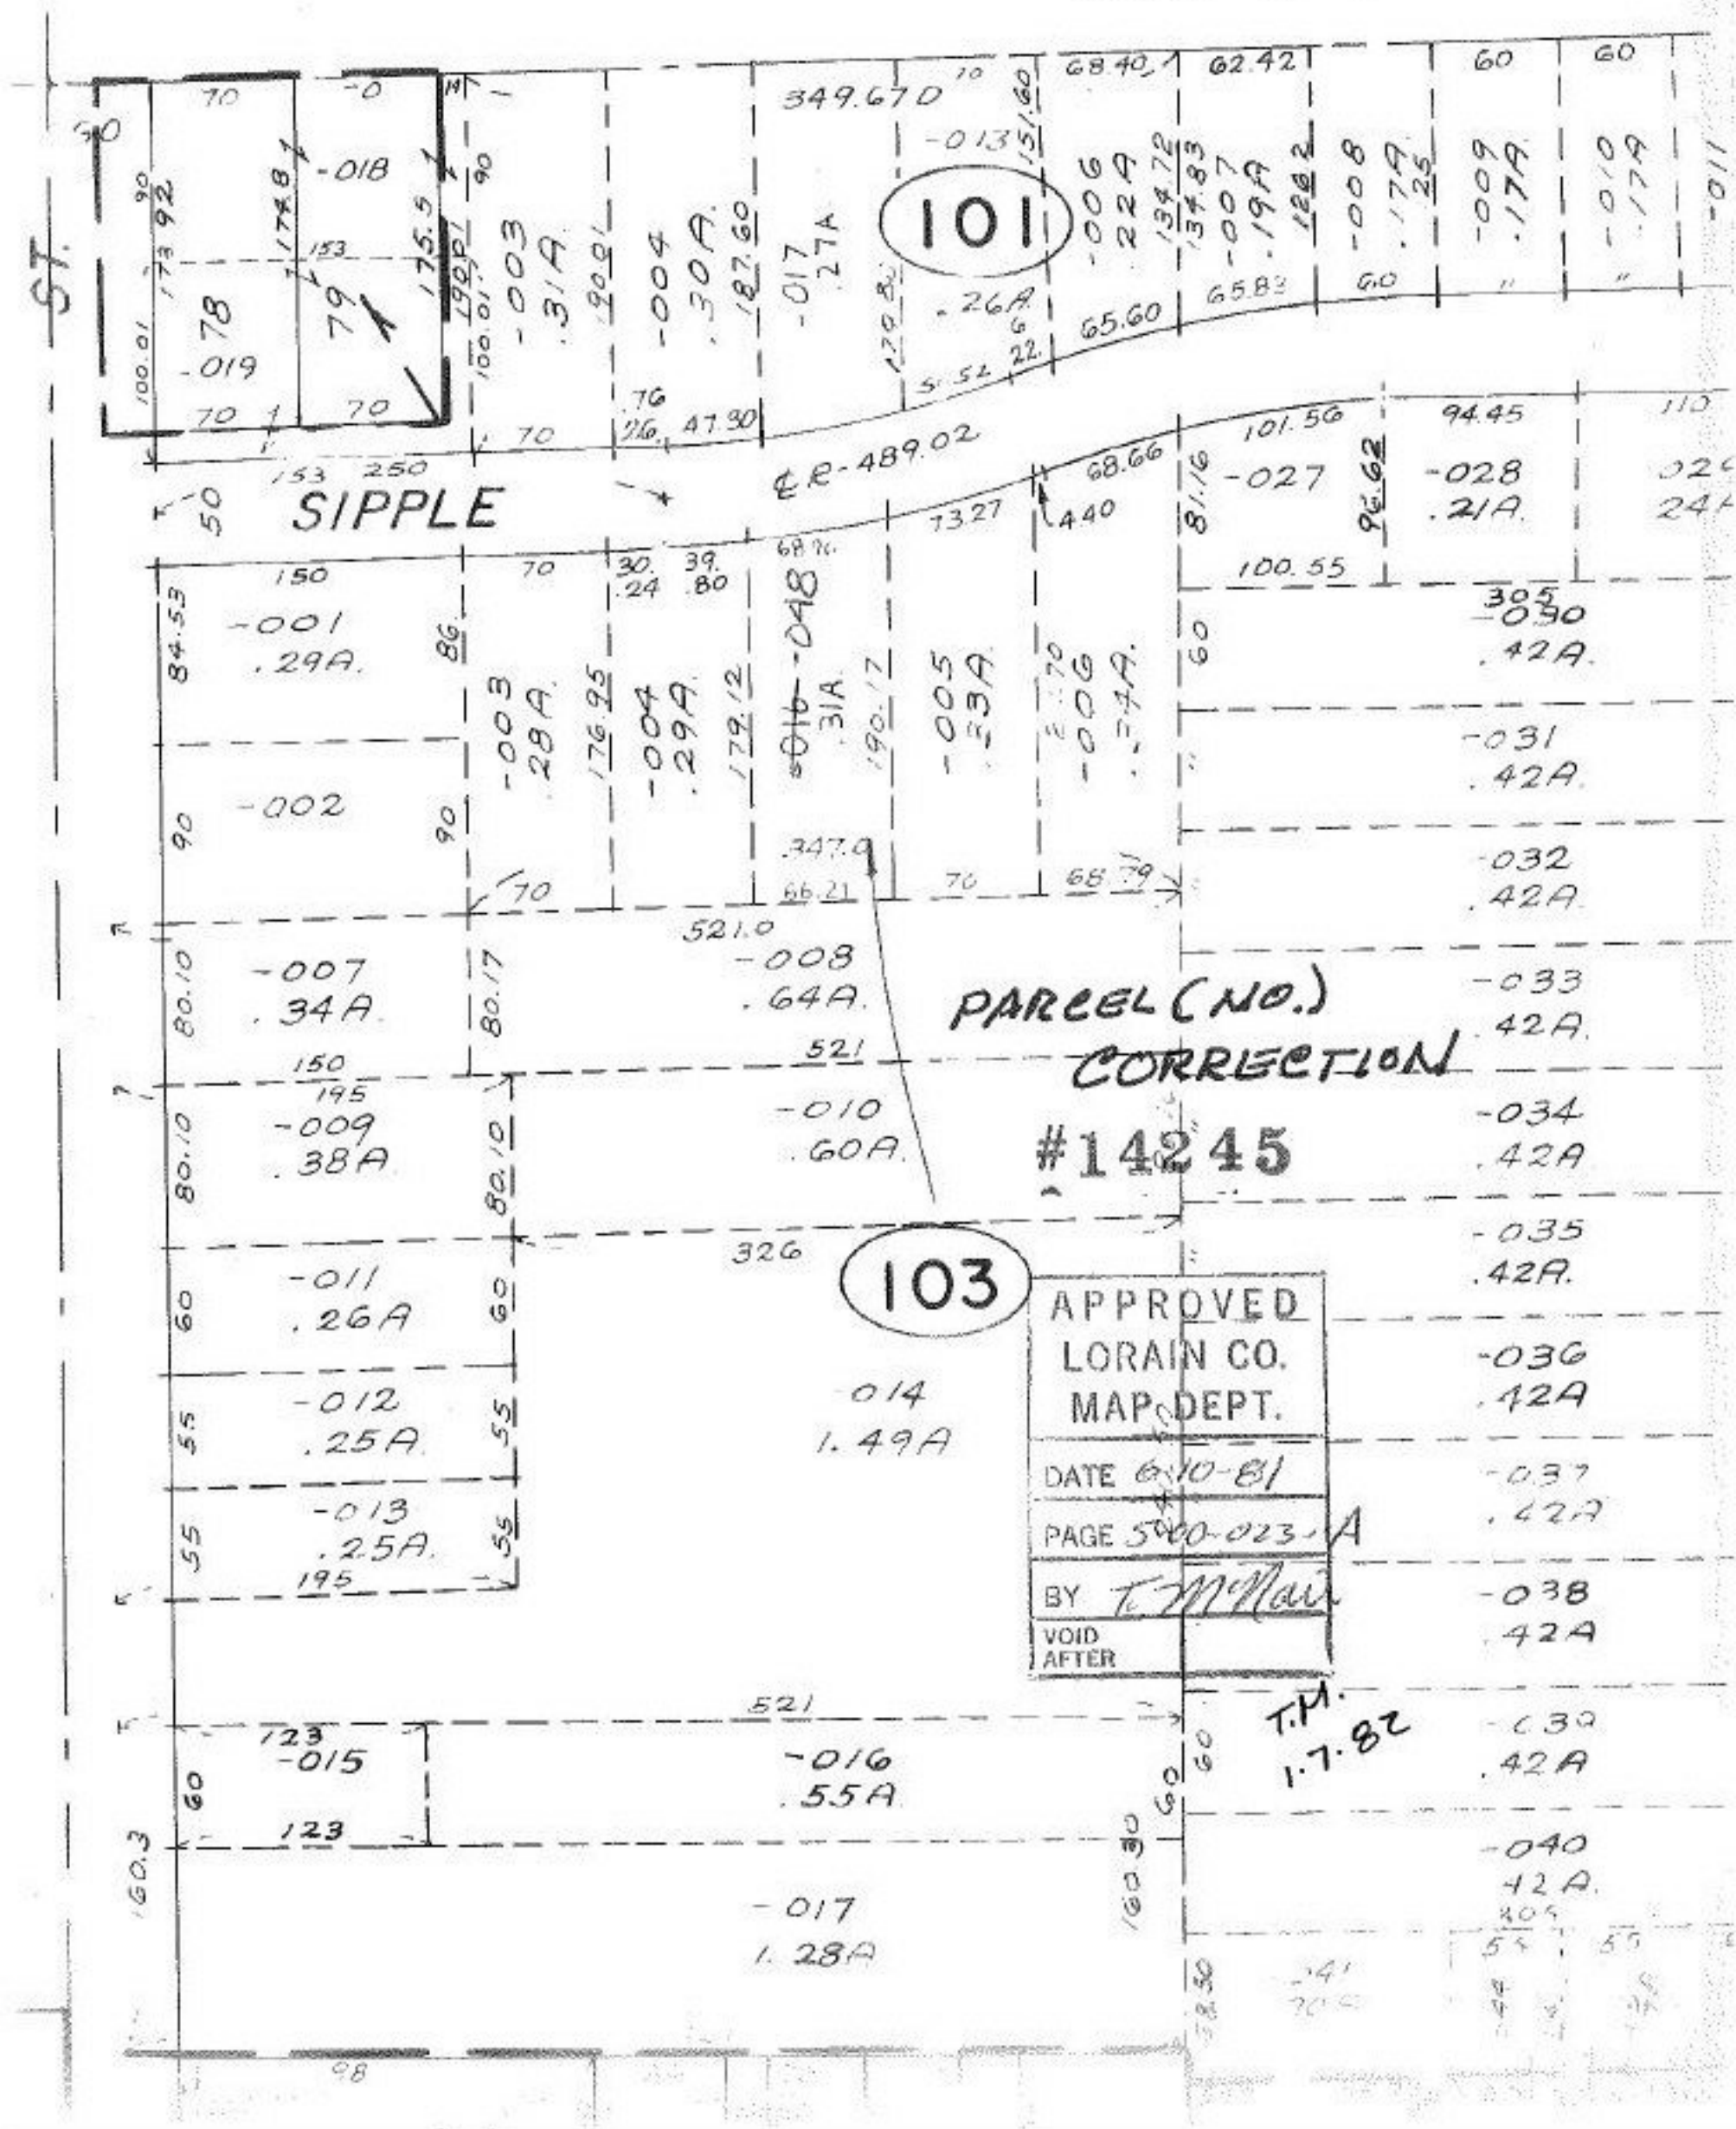

ST.
SIPPLE
101
103
PARCEL (NO.) CORRECTION
#14245
APPROVED
LORAIN CO.
MAP DEPT.
DATE 6-10-81
PAGE 5-00-023-A
BY T. McNair
VOID AFTER
T.M. 1.7.82