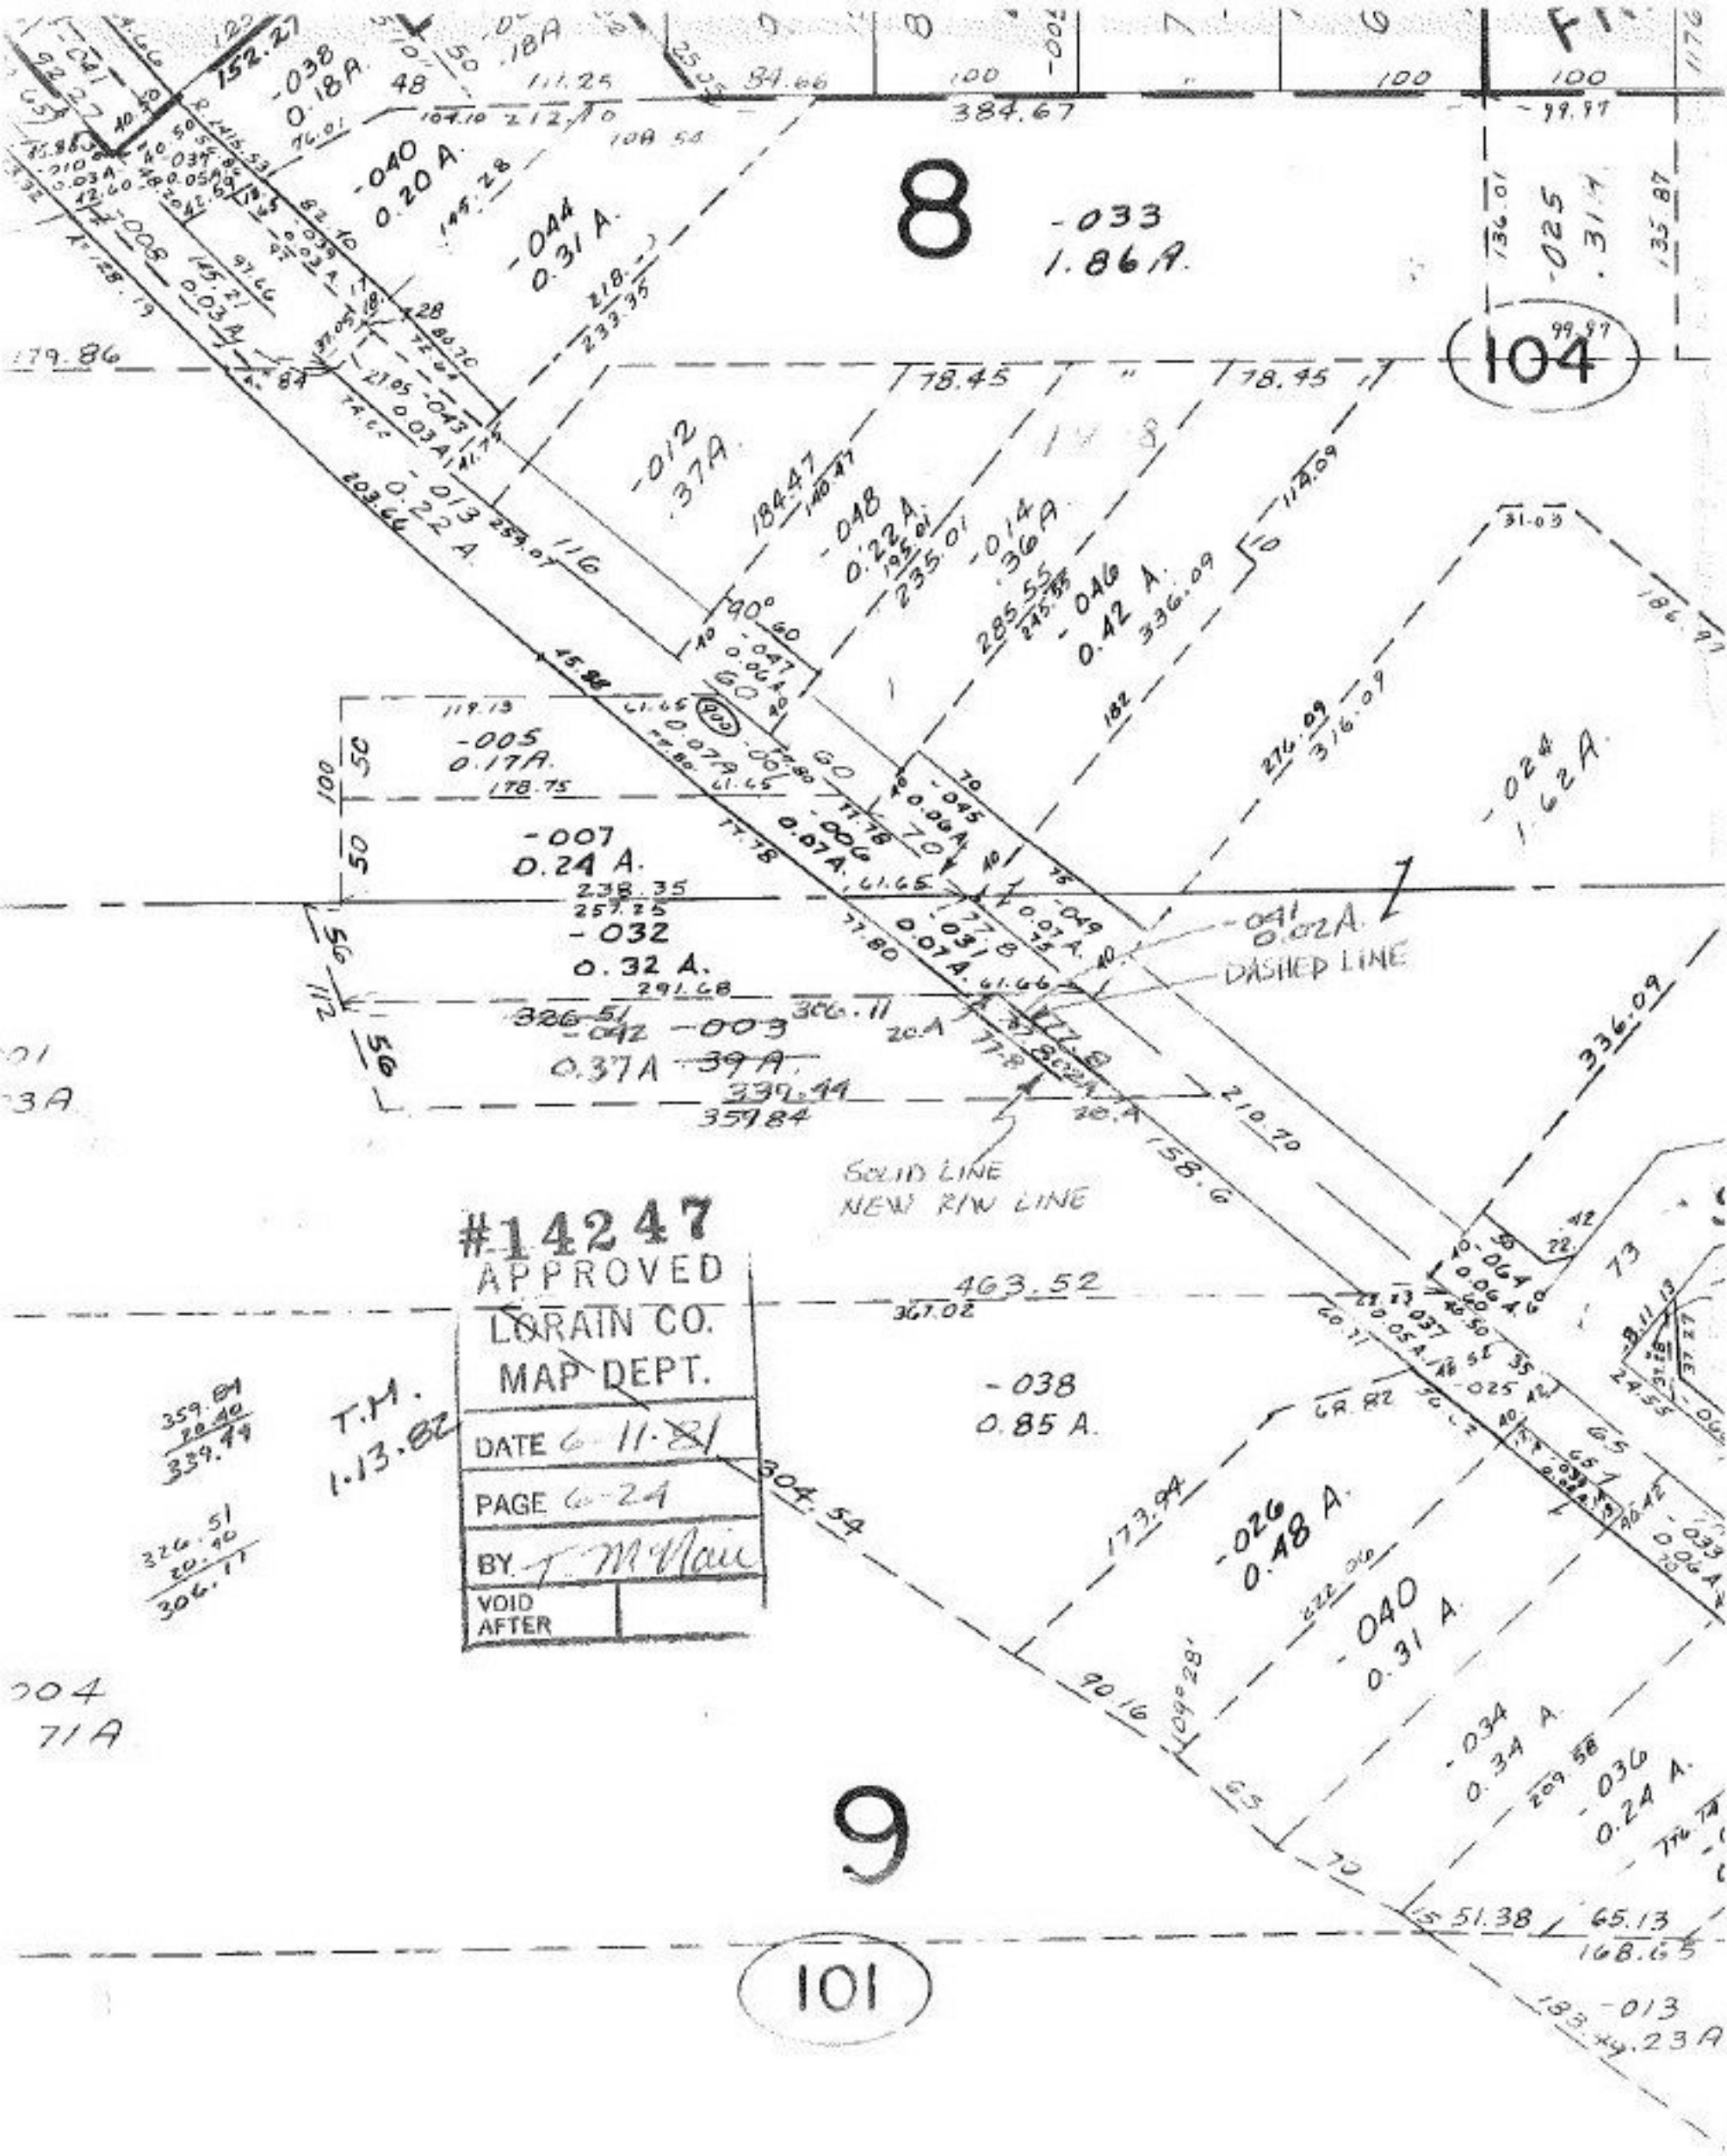
8
-033
1.86A.
104
-038
0.18A.
-040
0.20 A.
-044
0.31 A.
-012
.37A.
-048
0.22A.
-014
.36A.
-046
0.42 A.
-005
0.17A.
-007
0.24 A.
-032
0.32 A.
-041
0.02A.
DASHED LINE
-024
1.62A.
SOLID LINE
NEW R/W LINE
463.52
-038
0.85 A.
-026
0.48 A.
-040
0.31 A.
-034
0.34 A.
-036
0.24 A.
9
101
-013
.23A
T.M.
1.13.82
#14247
APPROVED
LORAIN CO.
MAP DEPT.
DATE 6-11-81
PAGE 6-24
BY T. McNair
VOID
AFTER