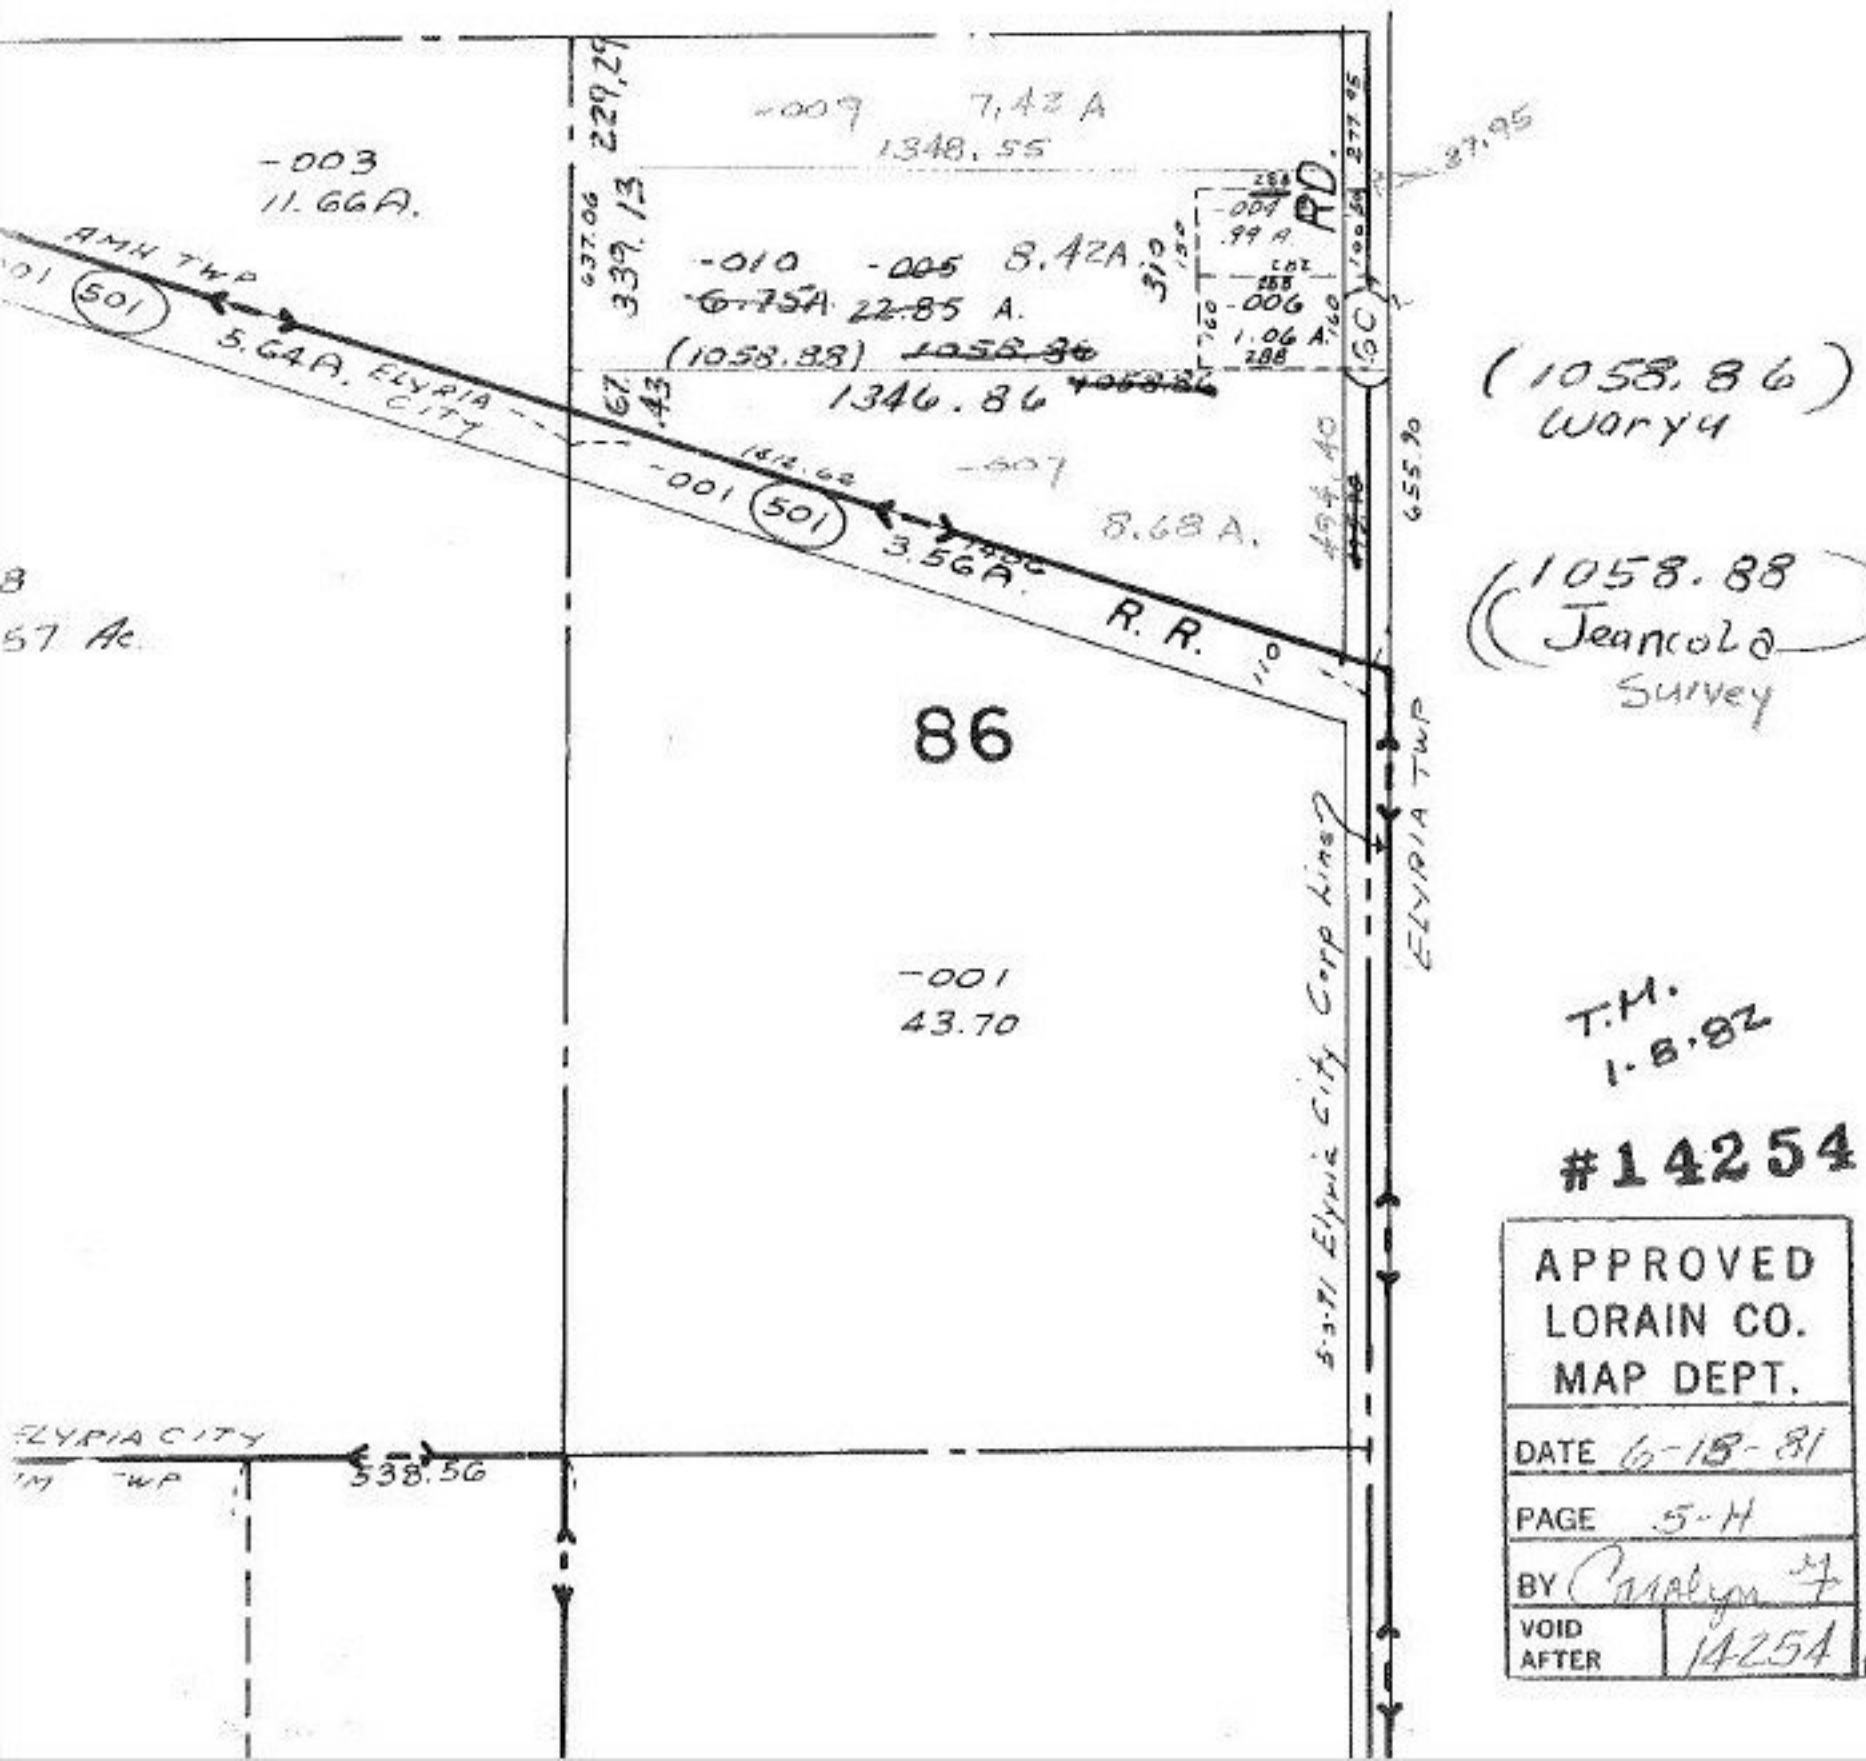"Acreage Correction Only"
By Deed.