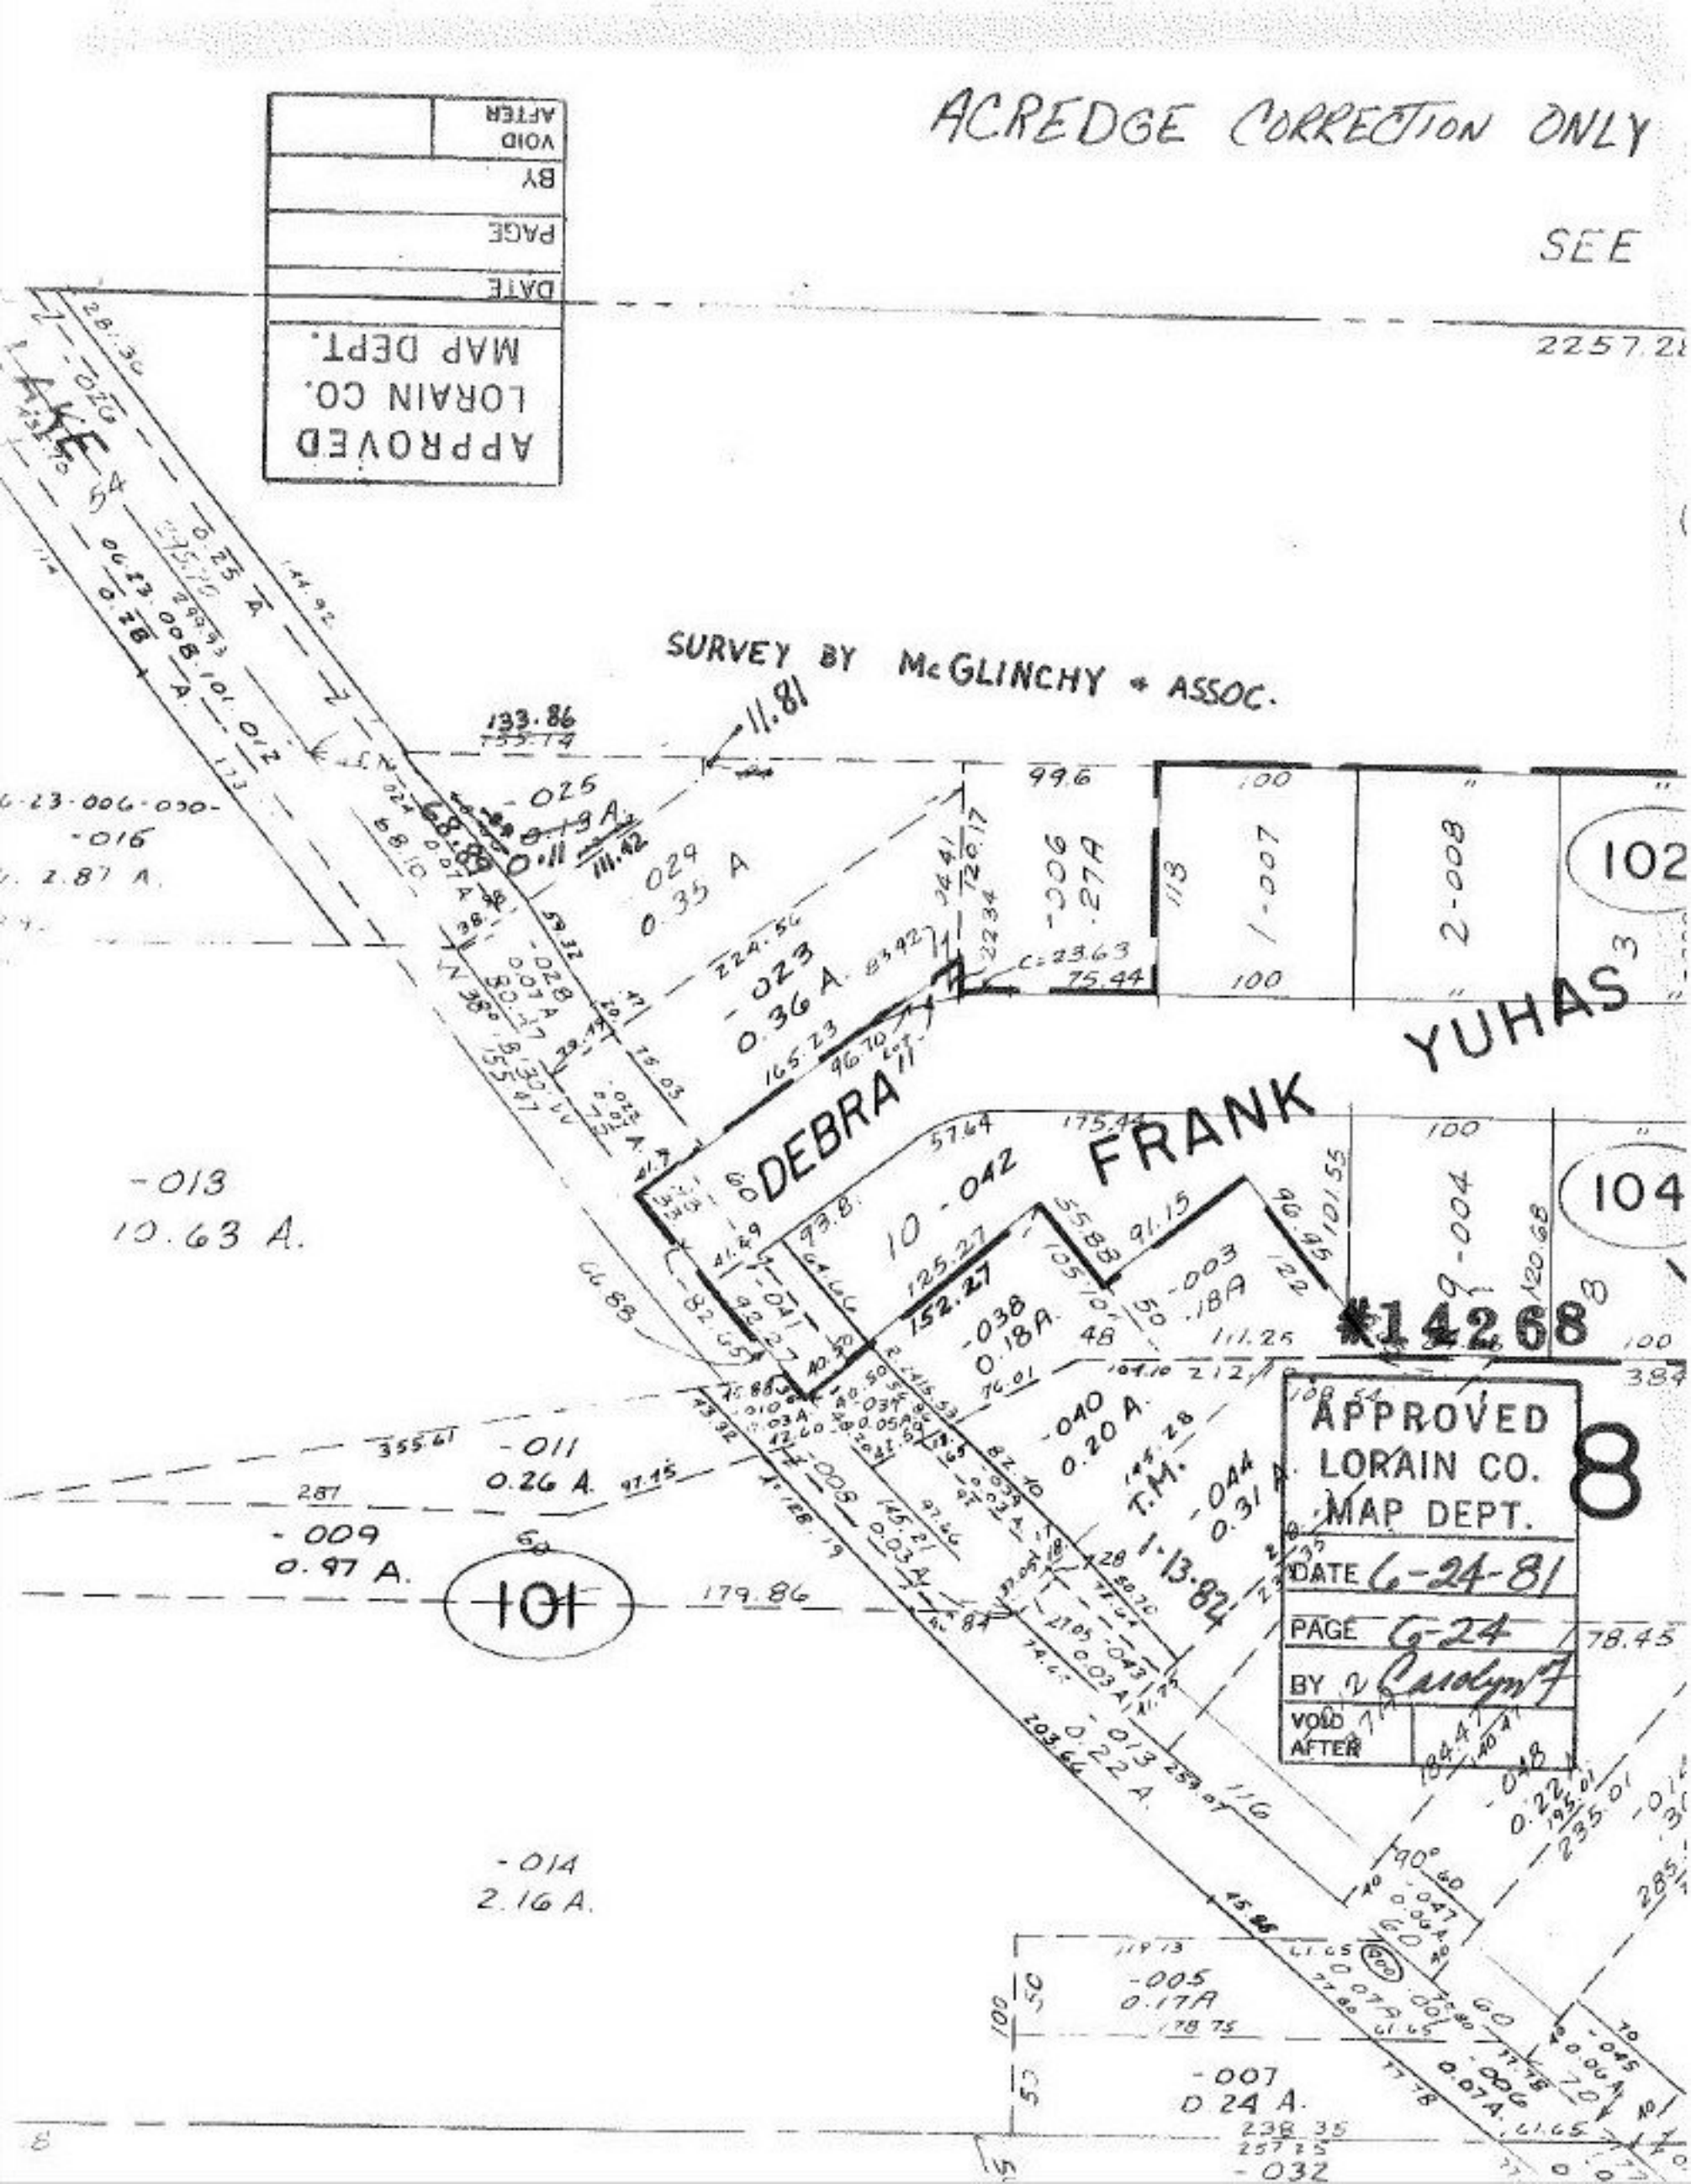
ACREDGE CORRECTION ONLY
SEE
APPROVED
LORAIN CO.
MAP DEPT.
DATE
PAGE
BY
VOID
AFTER
SURVEY BY McGLINCHY + ASSOC.
DEBRA
FRANK YUHAS
#14268
APPROVED
LORAIN CO.
MAP DEPT.
DATE 6-24-81
PAGE 6-24
BY
VOID
AFTER
8
101
102
104
-013
10.63 A.
-011
0.26 A.
-009
0.97 A.
-014
2.16 A.
-005
0.17A
-007
0.24 A.
-032
-025
0.13 A.
-029
0.35 A
-023
0.36 A.
-038
0.18A.
-040
0.20 A.
-044
0.31 A.
-006
.27A
-003
.18A
-004
1-007
2-008
10-042
1-13-82
T.M.
133.86
11.81
99.6
75.44
175.44
152.27
179.86
78.45
2257.28