SEE 11-00-099-B

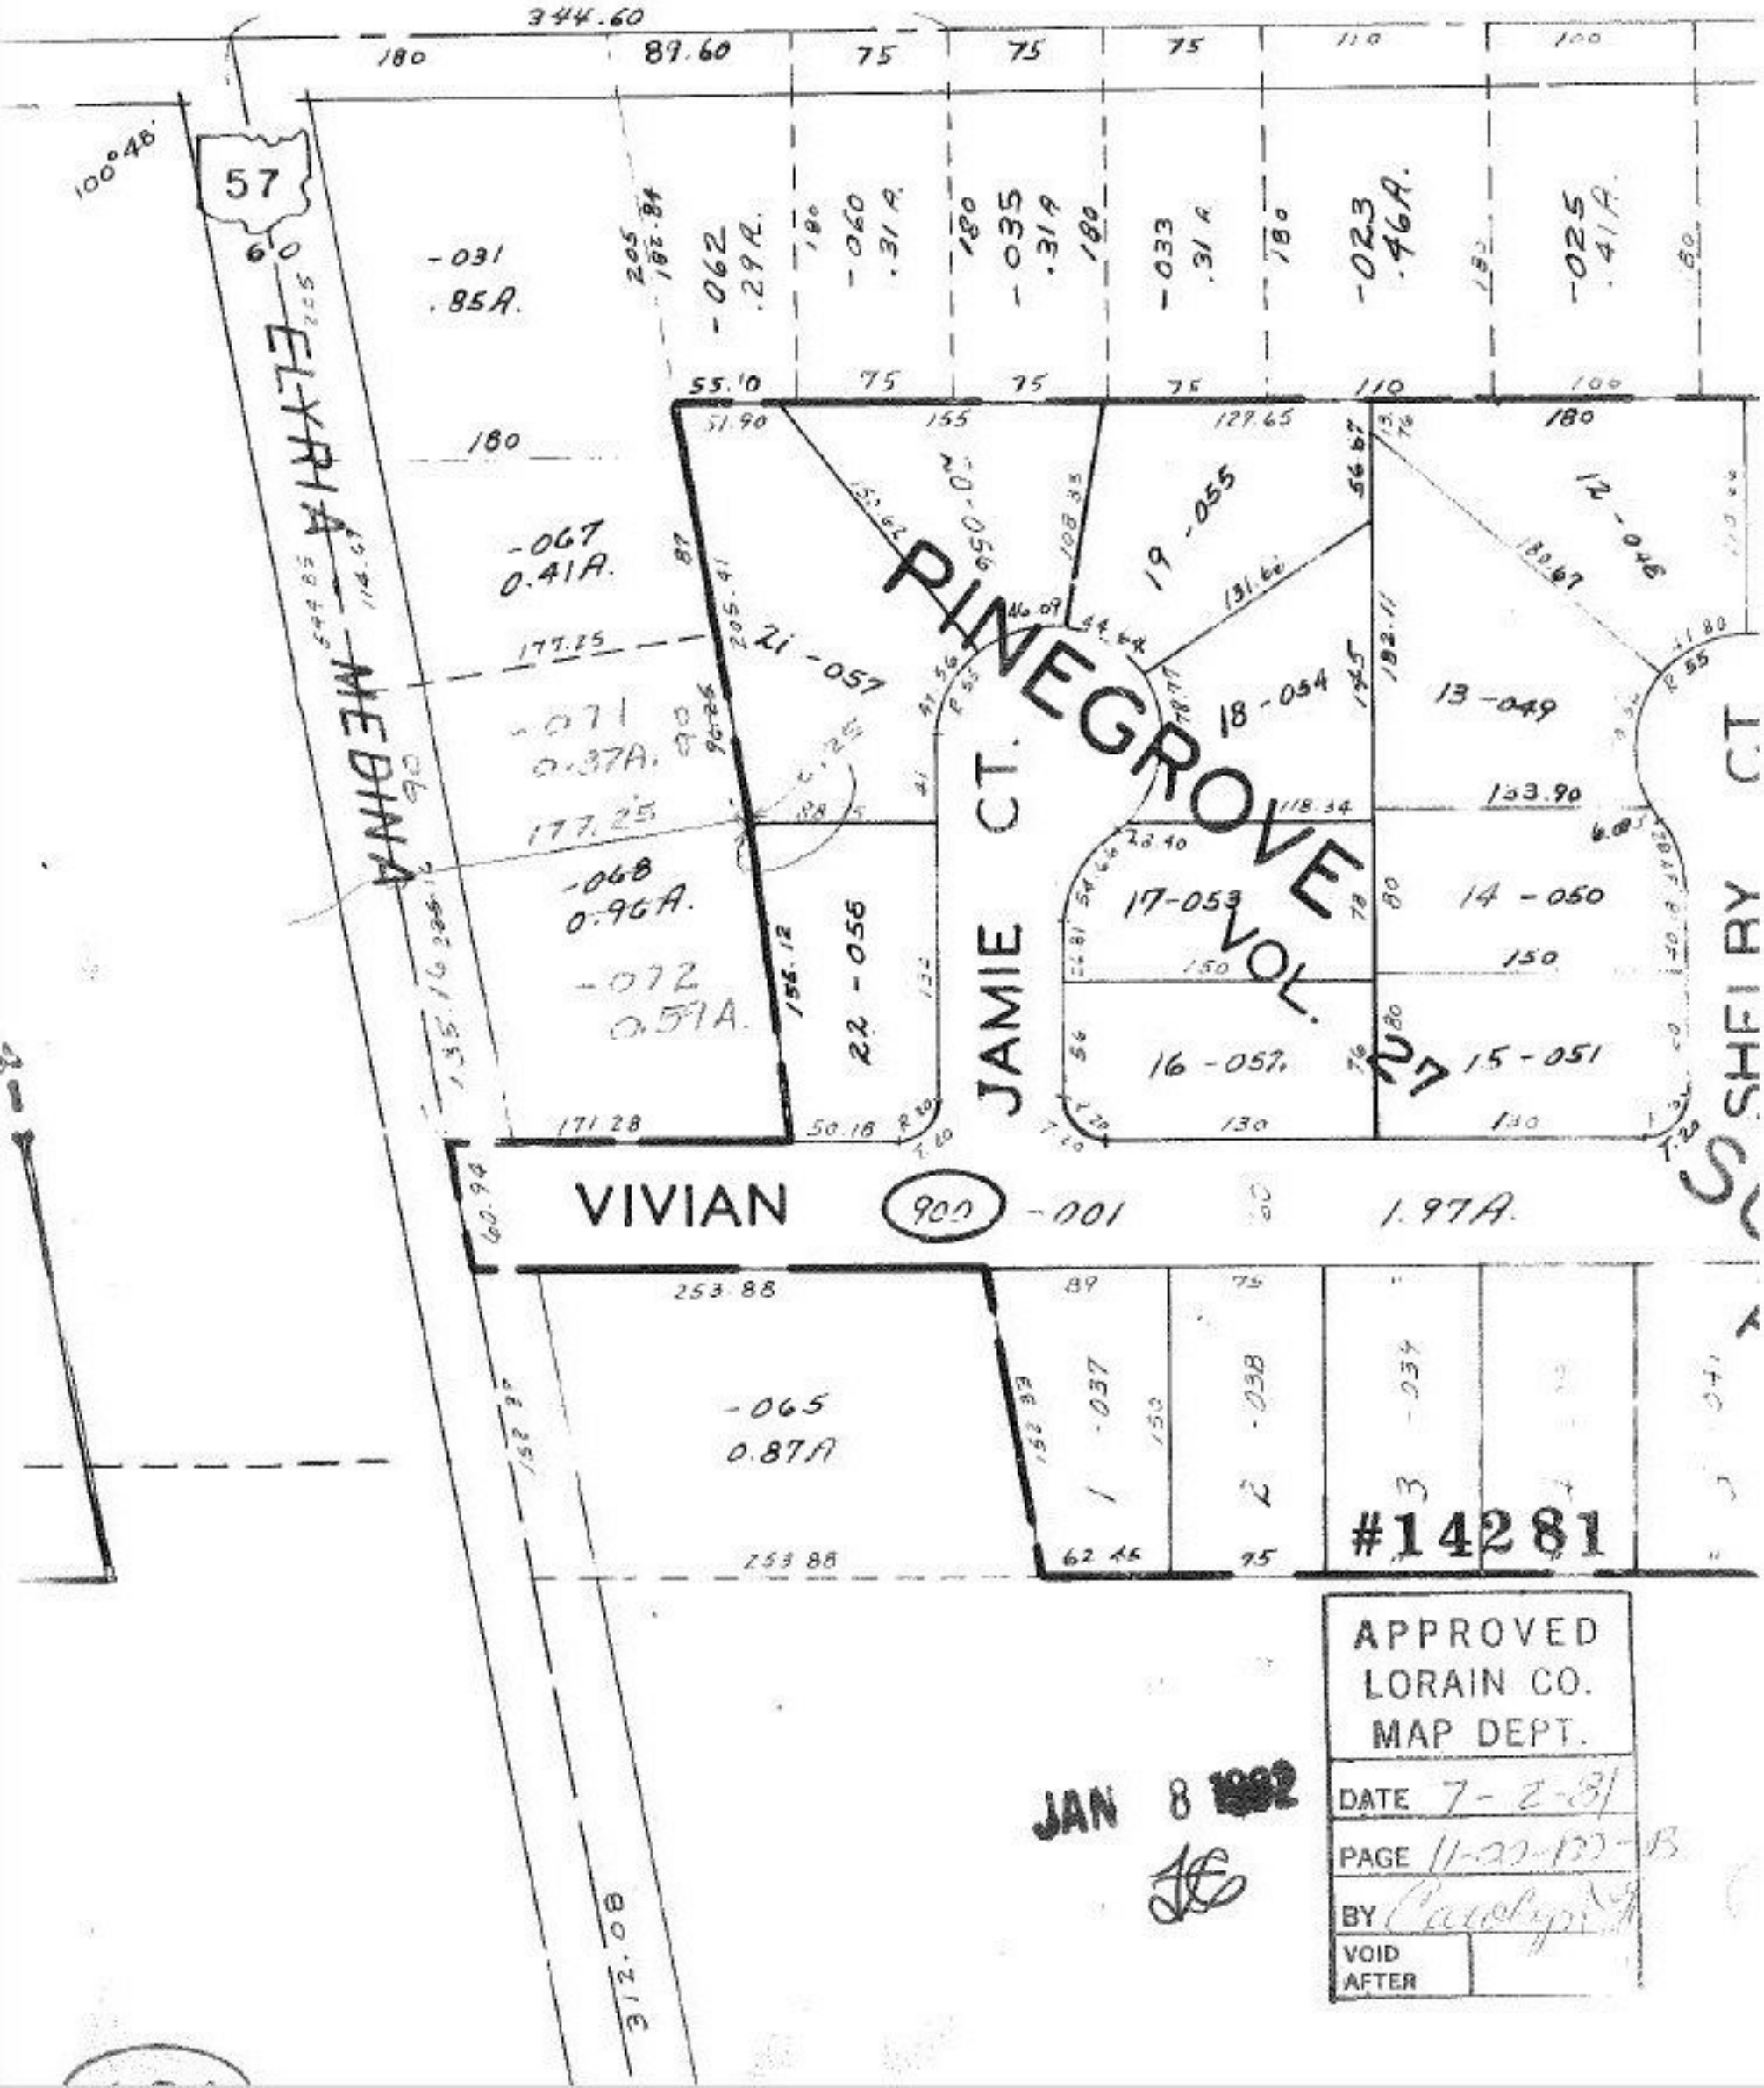

APPROVED
LORAIN CO.
MAP DEPT.

DATE 7-2-81


BY [illegible]

VOID AFTER

JAN 8 1982